


NOTE:
METERS, METER CANS, VAULTS AND BACKFLOW PREVENTION ASSEMBLIES TO BE INSTALLED AND TESTED PER TOWN OF ADDISON GENERAL REQUIREMENTS.

LEGEND

	ELECTRIC		MISC.
	LIGHT POLE		EX. STORM SEWER
	POWER POLE		CHAIN LINK FENCE
	TELEPHONE		WOOD FENCE
	TELEPHONE MANHOLE		EXISTING ASPHALT
	TELEPHONE PEDESTAL		EXISTING DIRT OR GRAVEL
	TELEPHONE SIGN		EX. CONCRETE
	GAS		TREE/TREE LINE
	GAS METER		EXISTING CURB
	GAS SIGN		PROP. CURB
	LAND USE		PROP. EDGE OF PAVEMENT NO CURB
	RAILROAD SIGN		EX. PROPERTY LINE
	SIGN		PROP. CENTERLINE
	SURVEY FOUND IRON ROD		PROP. R.O.W.
	BENCHMARK		PROP. INLET
	WASTEWATER MANHOLE		T.P. TOP OF PAVEMENT
	CLEANOUT		T.C. TOP OF CURB
	WATER		CR CURB RETURN
	FIRE HYDRANT		EX. G EXISTING GUTTER
	METER		EX. T.C. EXISTING TOP OF CURB
	WATER VALVE		B-20 BORING LOCATION
			EXISTING BRICKS
			PAVEMENT REMOVAL


RECORD DRAWING

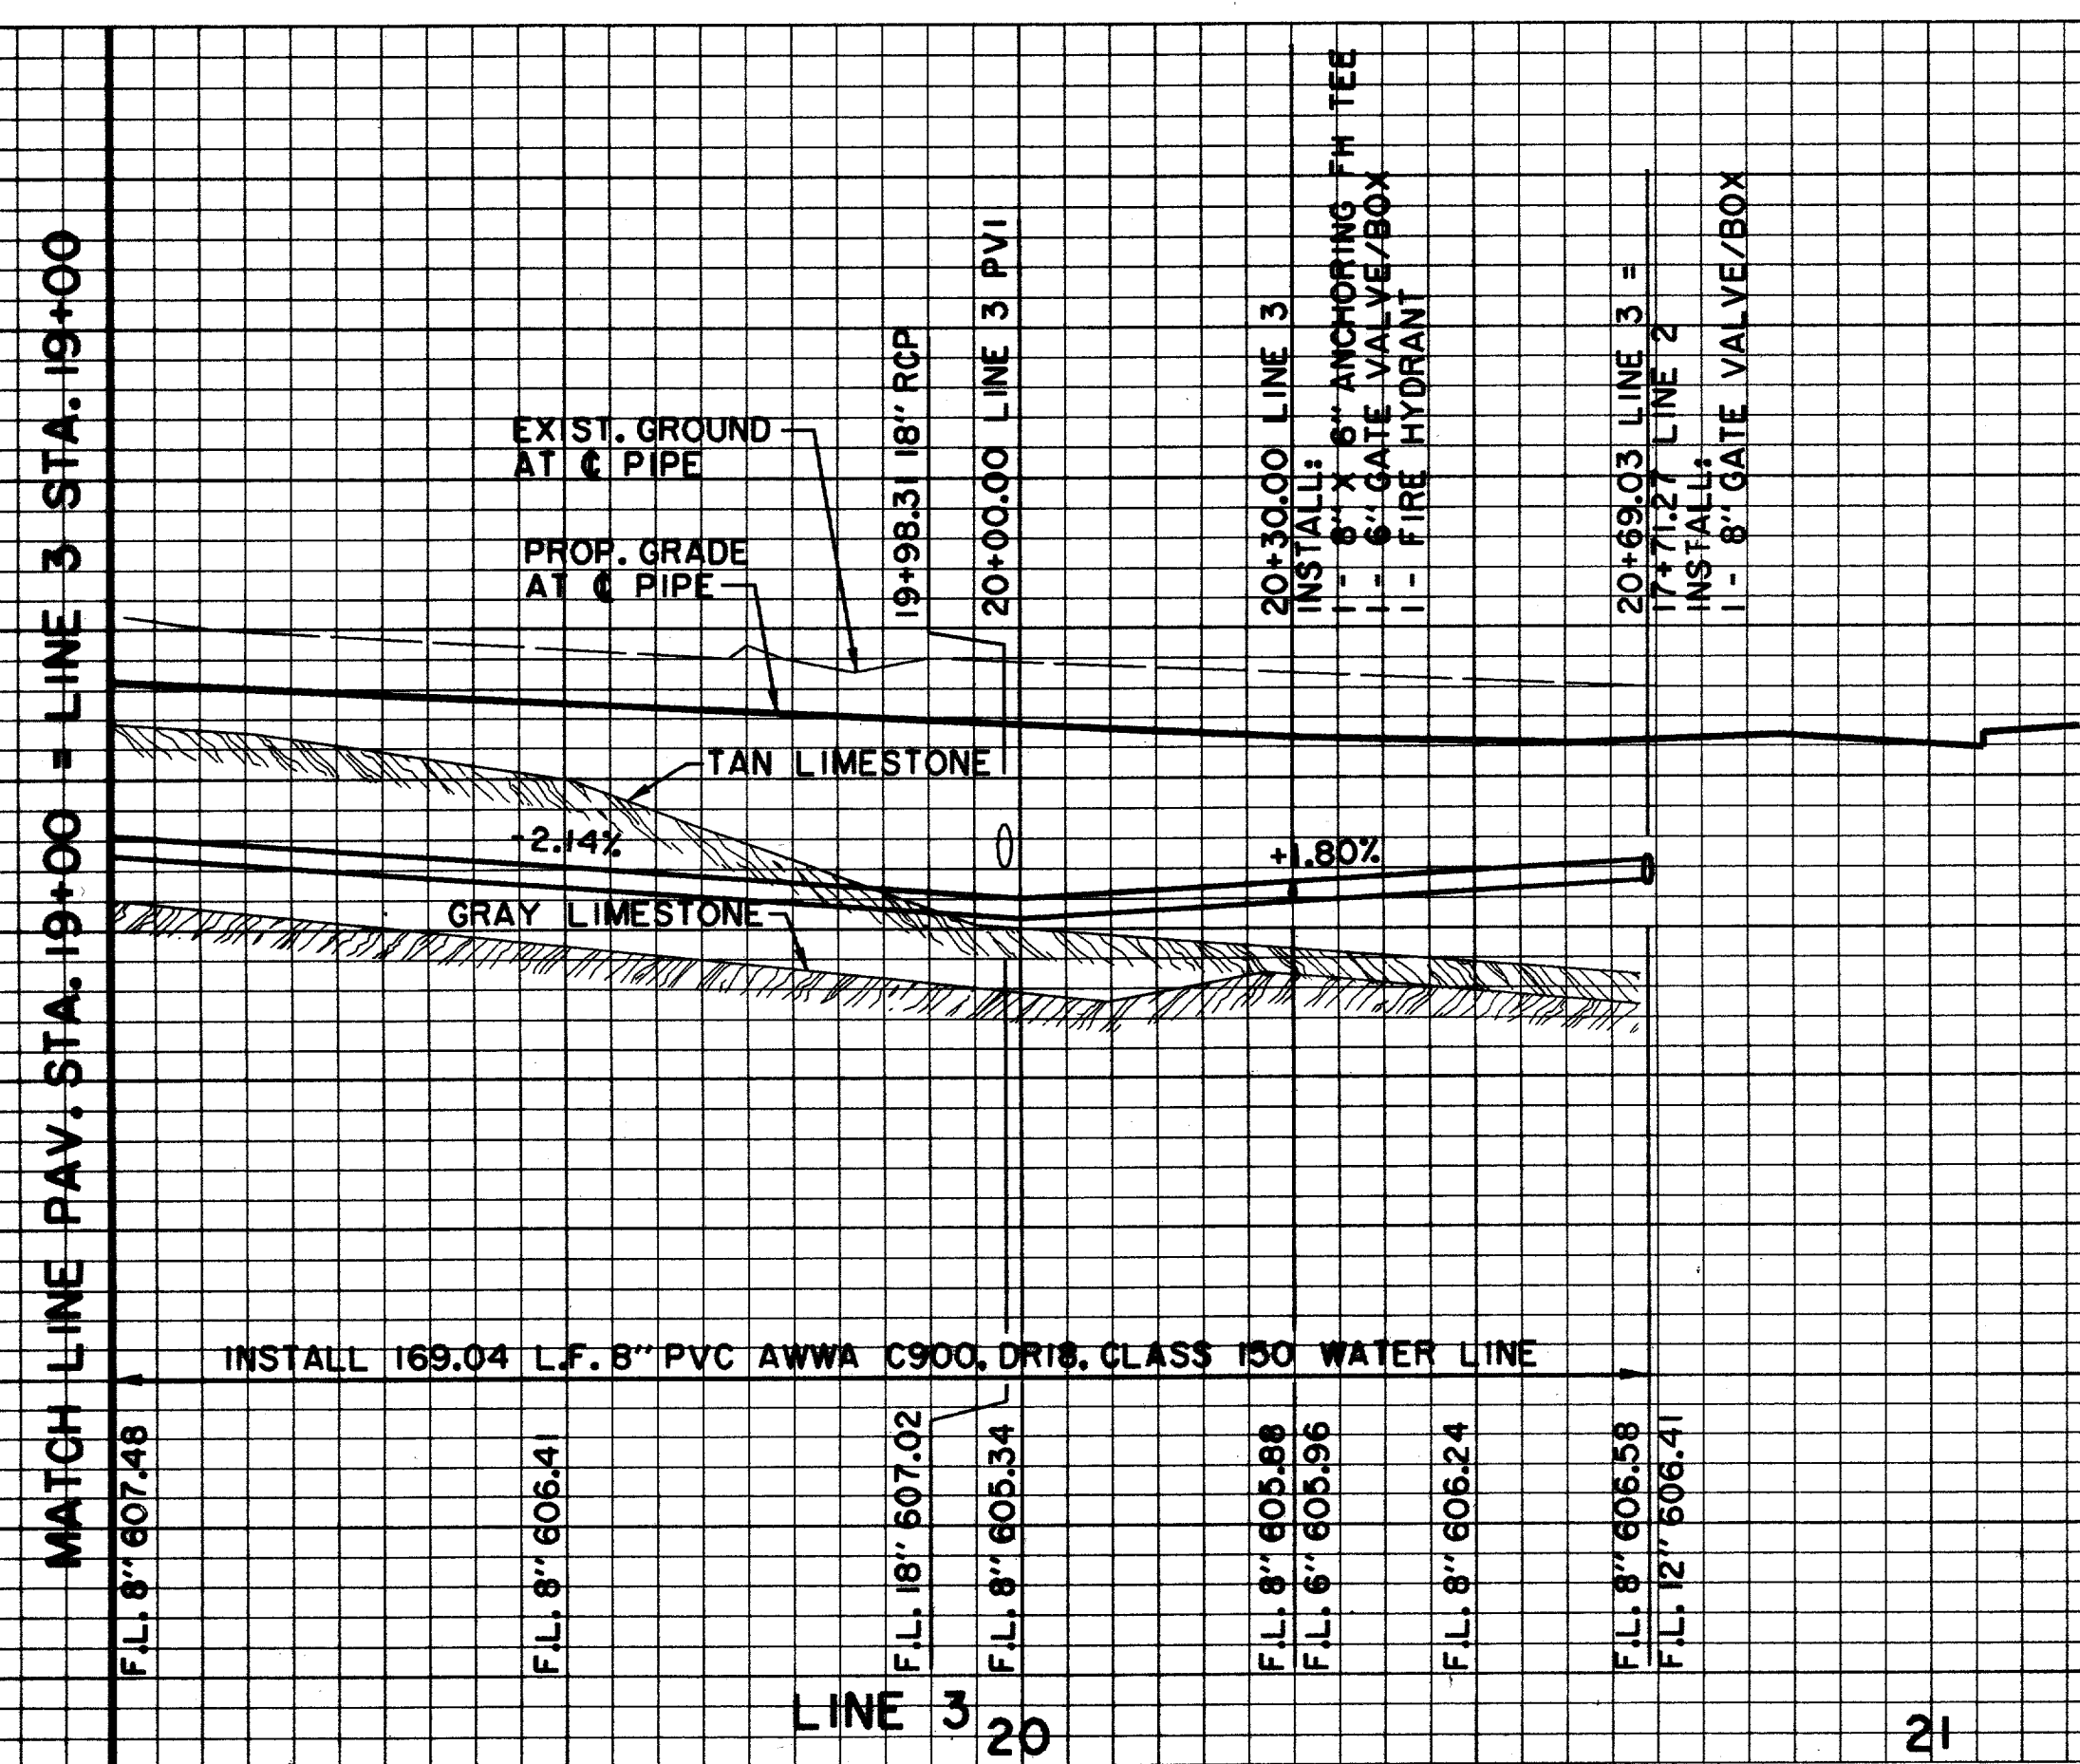

BENCHMARKS:

620	BM#1 "C" CUT AT CENTER BACK OF CURB OF INLET, 190 FEET SOUTH FROM THE CENTERLINE INTERSECTION OF MILDRED STREET, WEST SIDE OF QUORUM DRIVE. ELEV. 621.89
620	BM#4 "C" CUT AT CENTER OF CURB INLET, 1015 FEET NORTH FROM THE CENTERLINE INTERSECTION OF MILDRED STREET, WEST SIDE OF QUORUM DRIVE. ELEV. 629.36

DATE	DESCRIPTION	REF NO.
1/12/98	ADDED SERVICES FOR FUTURE TOWNHOMES	
10/3/97	ISSUED FOR CONSTRUCTION	N/A
7/14/97	ISSUED FOR BID	N/A

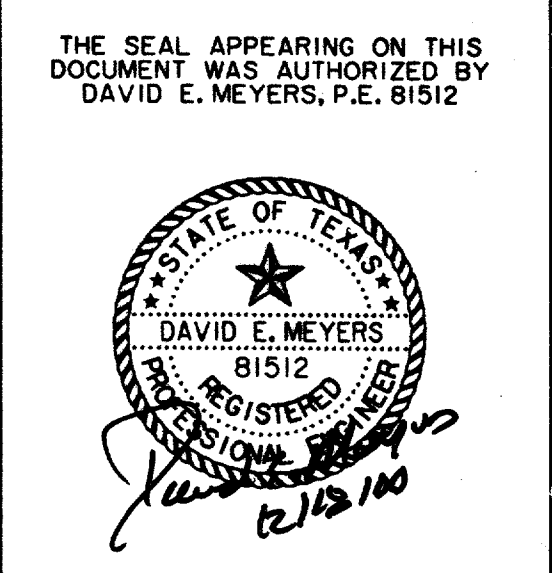

WATER PLAN & PROFILE
LINE 3 - MORRIS AVENUE
ADDISON CIRCLE
PHASE II PUBLIC INFRASTRUCTURE
TOWN OF ADDISON, TEXAS

Hull - Zollars, Inc./Engineering/Architecture
Dallas, Fort Worth, Houston, El Paso, Phoenix, Tustin, Ontario

DESIGN	DRAWN	APPR.	SCALE	DATE	PROJECT NO.	NO.
HZI	HZI	DEM	H ₁ 1"=20' V ₁ 1"=6'	OCT. 97	01-1822-21	W8

PROJECT NO. 01-1822-21
 SHEET NO. W8
 DATE: 10/3/97
 DRAWN BY: HZI
 CHECKED BY: DEM
 APPROVED BY: [Signature]
 HULL - ZOLLARS, INC.
 10000 W. HUNTERS GREEN, SUITE 100
 FORT WORTH, TEXAS 76116
 TEL: 817-335-1111
 FAX: 817-335-1112
 WWW.HULLZOLLARS.COM