


# RECORD DRAWING

### LEGEND

	ELECTRIC — ONE —		MISC. 48" RCP
	LIGHT POLE		EX. STORM SEWER
	POWER POLE		CHAIN LINK FENCE
	TELEPHONE MANHOLE		WOOD FENCE
	TELEPHONE PEDESTAL		EXISTING ASPHALT
	TELEPHONE SIGN		EXISTING DIRT OR GRAVEL
	GAS METER		EX. CONCRETE
	GAS SIGN		TREE/TREE LINE
	LAND USE		EXISTING CURB
	RAILROAD SIGN		PROP. CURB
	SIGN		PROP. EDGE OF PAVEMENT NO CURB
	FOUND IRON ROD		EX. PROPERTY LINE
	BENCHMARK		PROP. CENTERLINE
	WASTEWATER MANHOLE		PROP. R.O.W.
	CLEANOUT		PROP. INLET
	FIRE HYDRANT		T.P. TOP OF PAVEMENT
	METER		T.C. TOP OF CURB
	WATER VALVE		CR CURB RETURN
	MISC.		EX. G. EXISTING GUTTER
	MISC.		EX. T.C. EXISTING TOP OF CURB
	MISC.		B-20 BORING LOCATION
	MISC.		EXISTING BRICKS
	MISC.		PAVEMENT REMOVAL

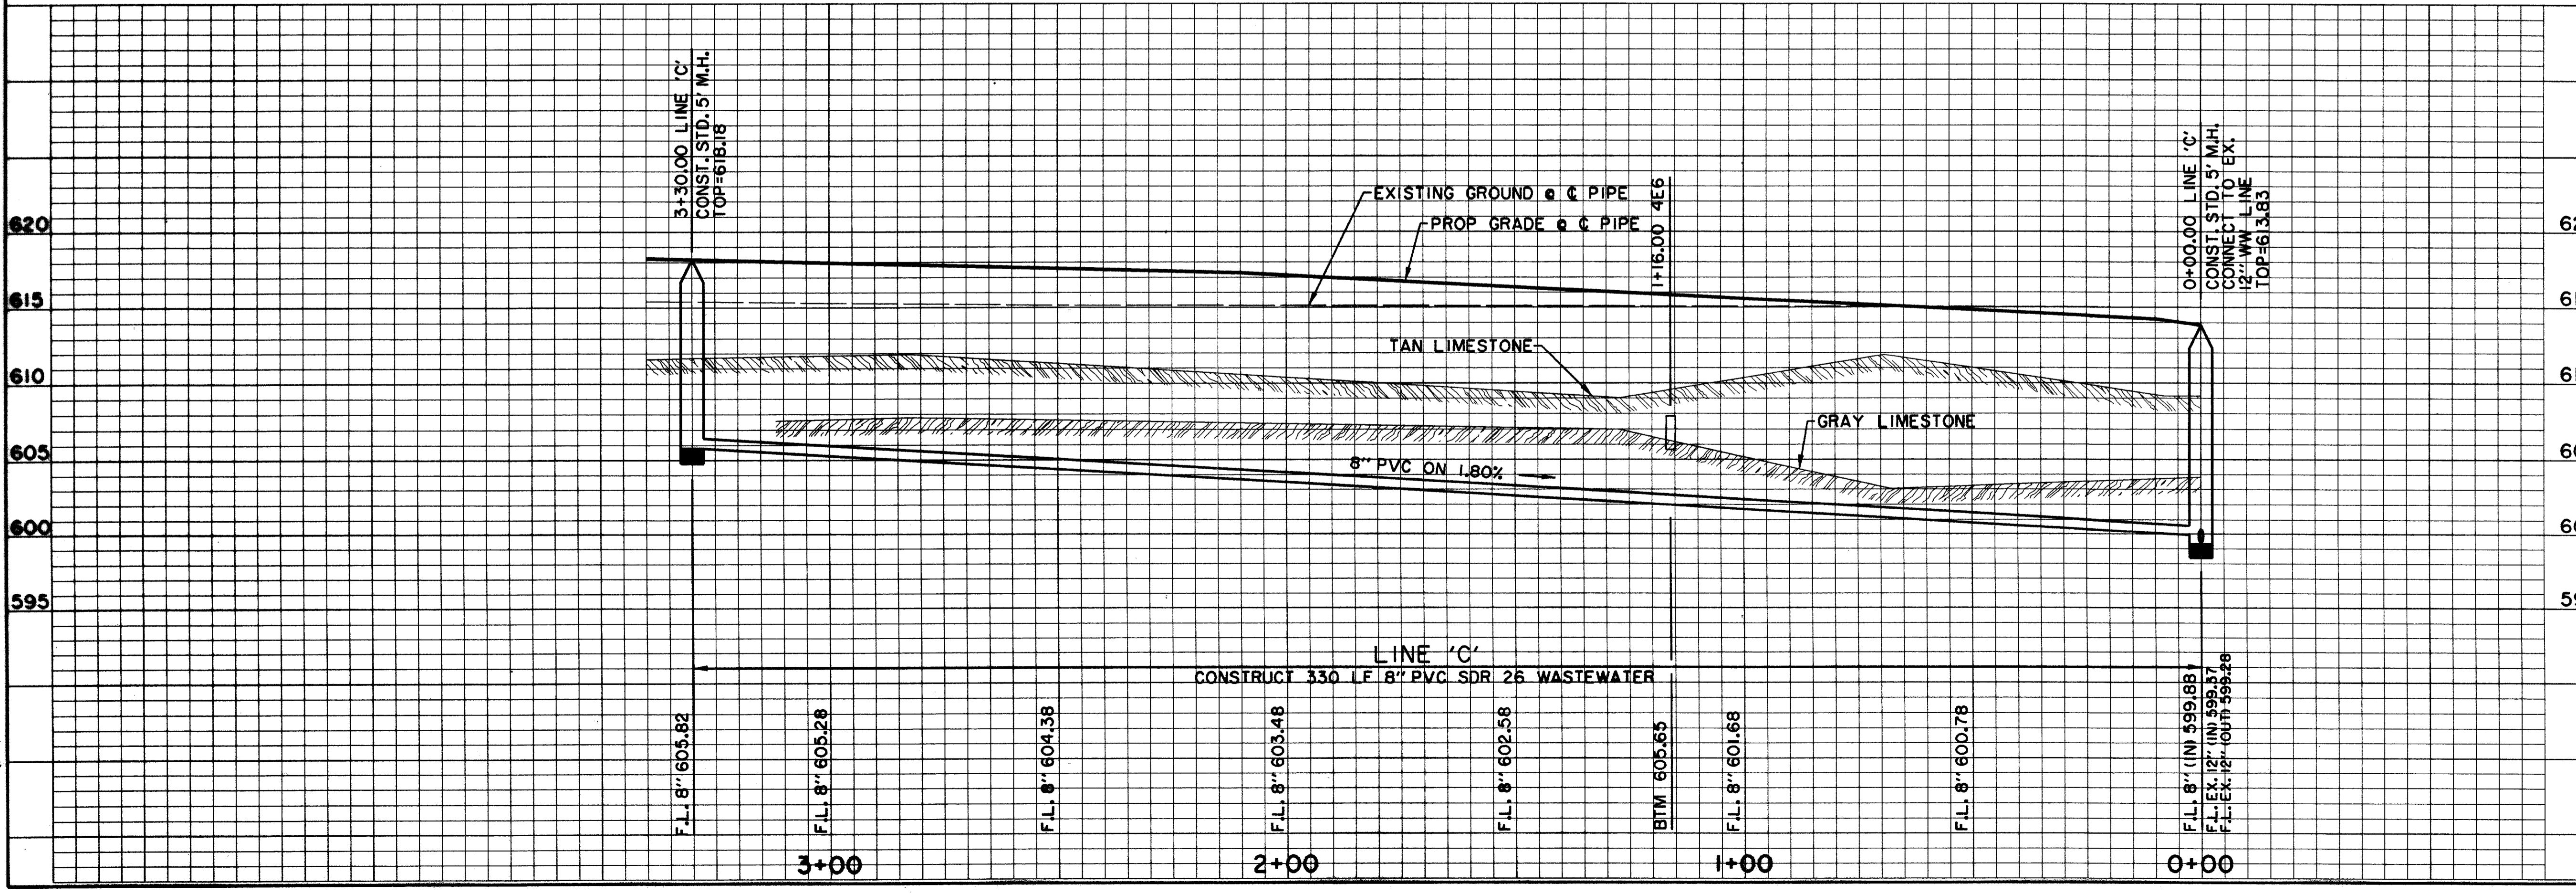

**BENCHMARKS:**

BM#1 'D' CUT AT CENTER BACK OF CURB OF INLET, 190 FEET SOUTH FROM THE CENTERLINE INTERSECTION OF MILDRED STREET, WEST SIDE OF QUORUM DRIVE. ELEV. 621.89

BM#5 'D' CUT ON NORTHWEST CORNER OF CONC. HDWL. FOR 7'X7' BOX CULVERT UNDER R.R. TRACKS, 180 FEET WEST OF DALLAS PARKWAY SOUTHBOUND. ELEV. 610.49

THE SEAL APPEARING ON THIS DOCUMENT WAS AUTHORIZED BY DAVID E. MEYERS, P.E. 81512

DATE	DESCRIPTION	REF NO.
11/15/97	REVISED 6" LATERAL LOCATION	▲
10/3/97	ISSUED FOR CONSTRUCTION	N/A
7/14/97	ISSUED FOR BID	N/A

<b>WASTEWATER PLAN &amp; PROFILE</b>					
LINE C - STA. 0+00 TO STA. 3+40.00					
<b>ADDISON CIRCLE</b>					
<b>PHASE II PUBLIC INFRASTRUCTURE</b>					
<b>TOWN OF ADDISON, TEXAS</b>					
Huitt-Zollars, Inc./Engineering/Architecture Dallas, Fort Worth, Houston, El Paso, Phoenix, Tustin, Ontario					
DESIGN	DRAWN	APPR.	SCALE	DATE	PROJECT NO.
HZ1	HZ1	DEM	H <sub>1</sub> 1"=20' V <sub>1</sub> 1"=6'	OCT. 97	01-1822-21
					<b>WW4</b>

THE INFORMATION CONTAINED HEREIN IS THE PROPERTY OF HUITT-ZOLLARS, INC. AND IS NOT TO BE REPRODUCED, COPIED, OR TRANSMITTED IN ANY FORM OR BY ANY MEANS, ELECTRONIC OR MECHANICAL, INCLUDING PHOTOCOPYING, RECORDING, OR BY ANY INFORMATION STORAGE AND RETRIEVAL SYSTEM, WITHOUT THE WRITTEN PERMISSION OF HUITT-ZOLLARS, INC.

ALL DIMENSIONS AND LOCATIONS ARE AS SHOWN ON THE DRAWING UNLESS OTHERWISE NOTED. THE CONTRACTOR SHALL BE RESPONSIBLE FOR VERIFYING ALL DIMENSIONS AND LOCATIONS IN THE FIELD. THE CONTRACTOR SHALL BE RESPONSIBLE FOR OBTAINING ALL NECESSARY PERMITS AND APPROVALS FROM THE APPROPRIATE AGENCIES. THE CONTRACTOR SHALL BE RESPONSIBLE FOR PROTECTING ALL EXISTING UTILITIES AND STRUCTURES. THE CONTRACTOR SHALL BE RESPONSIBLE FOR MAINTAINING ACCESS TO ALL ADJACENT PROPERTIES AND PUBLIC AREAS. THE CONTRACTOR SHALL BE RESPONSIBLE FOR CLEANING UP ALL DEBRIS AND RESTORING THE AREA TO ORIGINAL OR BETTER CONDITION. THE CONTRACTOR SHALL BE RESPONSIBLE FOR NOTIFYING ALL AFFECTED PARTIES OF ANY CHANGES TO THE WORK. THE CONTRACTOR SHALL BE RESPONSIBLE FOR MAINTAINING ACCURATE RECORDS OF ALL WORK DONE. THE CONTRACTOR SHALL BE RESPONSIBLE FOR OBTAINING ALL NECESSARY INSURANCE AND BONDS. THE CONTRACTOR SHALL BE RESPONSIBLE FOR OBTAINING ALL NECESSARY LABORERS' COMPENSATION. THE CONTRACTOR SHALL BE RESPONSIBLE FOR OBTAINING ALL NECESSARY WORKERS' COMPENSATION. THE CONTRACTOR SHALL BE RESPONSIBLE FOR OBTAINING ALL NECESSARY UNEMPLOYMENT COMPENSATION. THE CONTRACTOR SHALL BE RESPONSIBLE FOR OBTAINING ALL NECESSARY DISABILITY BENEFITS. THE CONTRACTOR SHALL BE RESPONSIBLE FOR OBTAINING ALL NECESSARY MEDICAL BENEFITS. THE CONTRACTOR SHALL BE RESPONSIBLE FOR OBTAINING ALL NECESSARY LIFE INSURANCE. THE CONTRACTOR SHALL BE RESPONSIBLE FOR OBTAINING ALL NECESSARY RETIREMENT BENEFITS. THE CONTRACTOR SHALL BE RESPONSIBLE FOR OBTAINING ALL NECESSARY PENSION BENEFITS. THE CONTRACTOR SHALL BE RESPONSIBLE FOR OBTAINING ALL NECESSARY ANNUITY BENEFITS. THE CONTRACTOR SHALL BE RESPONSIBLE FOR OBTAINING ALL NECESSARY OTHER BENEFITS. THE CONTRACTOR SHALL BE RESPONSIBLE FOR OBTAINING ALL NECESSARY OTHER PERKS. THE CONTRACTOR SHALL BE RESPONSIBLE FOR OBTAINING ALL NECESSARY OTHER PRIVILEGES. THE CONTRACTOR SHALL BE RESPONSIBLE FOR OBTAINING ALL NECESSARY OTHER RIGHTS. THE CONTRACTOR SHALL BE RESPONSIBLE FOR OBTAINING ALL NECESSARY OTHER BENEFITS AND PERKS.