


THE SEAL APPEARING ON THIS DOCUMENT WAS AUTHORIZED BY DAVID E. MEYERS, P.E. 81512

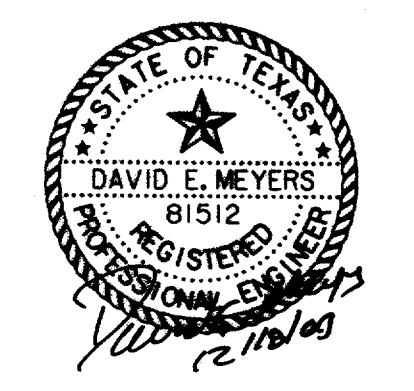

RECORD DRAWING

NOTE:
THE PRECISE FINAL LOCATIONS OF ALL UTILITIES ARE ESTABLISHED IN PLAN VIEW. LOCATIONS ON THIS PLAN ARE GIVEN AS A GUIDE AND TO INDICATE ALLOCATION OF SPACE.

| DATE | DESCRIPTION | REF. NO. |
|---------|---------------------------------|----------|
| 2/5/98 | REVISED PHONE AND GAS LOCATIONS | |
| 10/3/97 | ISSUED FOR CONSTRUCTION | N/A |
| 7/14/97 | ISSUED FOR BID | N/A |

| RECOMMENDED UTILITY LOCATIONS | | | | | | |
|--|-------|-------|--------|---------|-------------|-----|
| ADDISON CIRCLE | | | | | | |
| PHASE II PUBLIC INFRASTRUCTURE | | | | | | |
| TOWN OF ADDISON, TEXAS | | | | | | |
| Huitt-Zollers, Inc./Engineering/Architecture Dallas, Fort Worth, Houston, El Paso, Phoenix, Tustin, Ontario | | | | | | |
| DESIGN | DRAWN | APPR. | SCALE | DATE | PROJECT NO. | NO. |
| HZI | HZI | DEM | N.T.S. | OCT. 97 | 01-1822-21 | P3 |