


SIGN NO./LOCATION	STREET NAME	BLOCK NO.	MOUNTING
1	MORRIS AVE.	5000	NEW SIGN POLE
	QUORUM DR.	15700	
2	MORRIS AVE.	5000	NEW SIGN POLE
	MILDRED PLACE	15600	
3	MILDRED PLACE	15600	NEW SIGN POLE
	ADDISON CIRCLE	5000	
4	LEWIS PLACE	15500	NEW SIGN POLE
	ADDISON CIRCLE	5000	
5	LEWIS PLACE	15400	NEW SIGN POLE
	MCENTIRE PLACE	5000	
6	MCENTIRE PLACE	5000	NEW SIGN POLE
	QUORUM DR.	15400	
7	MCENTIRE PLACE	5000	NEW SIGN POLE
	SPECTRUM DR.	15500	
8	ADDISON CIRCLE	5000	NEW SIGN POLE
	SPECTRUM DR.	15500	
9	ADDISON CIRCLE	5000	NEW SIGN POLE
	DALLAS PKWY.	15600	
10	SPECTRUM DR.	15600	NEW SIGN POLE
	MORRIS AVE.	5000	
11	ADDISON CIRCLE	5000	NEW SIGN POLE
	SPECTRUM DR.	15600	

- NOTES:
- ALL TRAFFIC SIGN DESIGN, FABRICATION AND PLACEMENT SHALL CONFORM TO THE LATEST ISSUE OF THE "TEXAS MANUAL ON UNIFORM TRAFFIC CONTROL DEVICES FOR STREETS AND HIGHWAYS".
 - STREET NAME SIGNS ARE TO BE MOUNTED PER TABLE ON THIS DRAWING.
 - PRIOR TO FINAL INSTALLATION OF SIGNS, CONTRACTOR SHALL REVIEW PLACEMENT WITH THE DIRECTOR OF PUBLIC WORKS TO ENSURE PROPER VISIBILITY RELATIVE TO COMPLETION OF OTHER IMPROVEMENTS.
 - MOUNTING HEIGHT OF ALL ONE-WAY WITH CHEVRON SIGNS SHALL BE 1' CLEAR FROM TOP OF CURB TO BOTTOM OF SIGN.
 - SEE SHEET P21 FOR LANE STRIPING DETAILS.

THE SEAL APPEARING ON THIS DOCUMENT WAS AUTHORIZED BY DAVID E. MEYERS, P.E. 81512

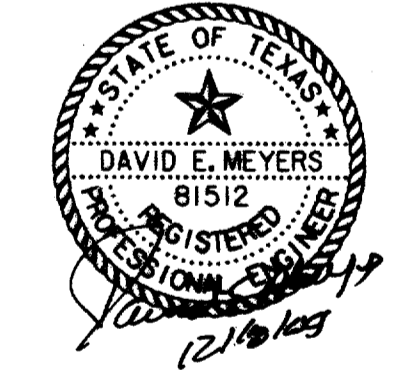

RECORD DRAWING

DATE	DESCRIPTION	REF NO.
2/13/98	ADDED VAN ACCESSIBLE SIGNS;	
	ADDED BLOCK NO'S FOR SIGN BLADES	
11/14/97	REVISED STREET NAMES	
10/17/97	DELETED BUTTONS; ADDED DUAL RIGHT SIGN	
10/3/97	ISSUED FOR CONSTRUCTION	N/A
7/14/97	ISSUED FOR BID	N/A

SIGNAGE AND STRIPING PLAN					
ADDISON CIRCLE					
PHASE II PUBLIC INFRASTRUCTURE					
TOWN OF ADDISON, TEXAS					
Hullitt-Zollars, Inc./Engineering/Architecture Dallas, Fort Worth, Houston, El Paso, Phoenix, Austin, Ontario					
DESIGN	DRAWN	APPR.	SCALE	DATE	PROJECT NO.
HZ1	HZ1	DEM	1"=50'	OCT. 97	01-1822-21
					P5