


THE SEAL APPEARING ON THIS DOCUMENT WAS AUTHORIZED BY KAREN W. KOERTH, L.A. 1594

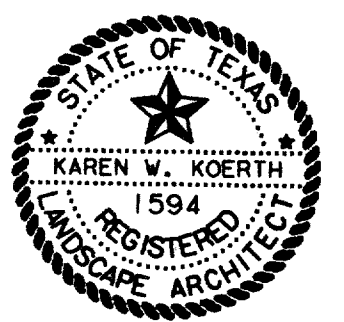

RECORD DRAWING

DATE	DESCRIPTION	REF. NO.
10/3/97	ISSUED FOR CONSTRUCTION	N/A
7/14/97	ISSUED FOR BID	N/A

PLANTING & FURNITURE PLAN
QUORUM DRIVE
ADDISON CIRCLE
PHASE II PUBLIC INFRASTRUCTURE
TOWN OF ADDISON, TEXAS

Hull-Zollars, Inc./Engineering/Architecture
 Dallas, Fort Worth, Houston, El Paso, Phoenix, Tustin, Ontario

DESIGN	DRAWN	APPR.	SCALE	DATE	PROJECT NO.	NO.
HZI	HZI	KWK	1"=20'	OCT. 97	01-1822-21	PF1

N:\proj\011822\ADDISON\ADDISON.dwg
 P:\proj\011822\ADDISON\ADDISON.dwg
 10/3/97 10:30 AM
 KWK

T:\ADDISON\1-1822-21-21.dwg
 10/3/97 10:30 AM
 KWK

HULL-ZOLLARS, INC.
 ENGINEERING/ARCHITECTURE
 DALLAS, FORT WORTH, HOUSTON, EL PASO, PHOENIX, TUSTIN, ONTARIO