



SEE SUPPLEMENTAL LANDSCAPE & IRRIGATION SPECIFICATIONS FOR FURNITURE SCHEDULE, POT SCHEDULE AND PLANT LIST.

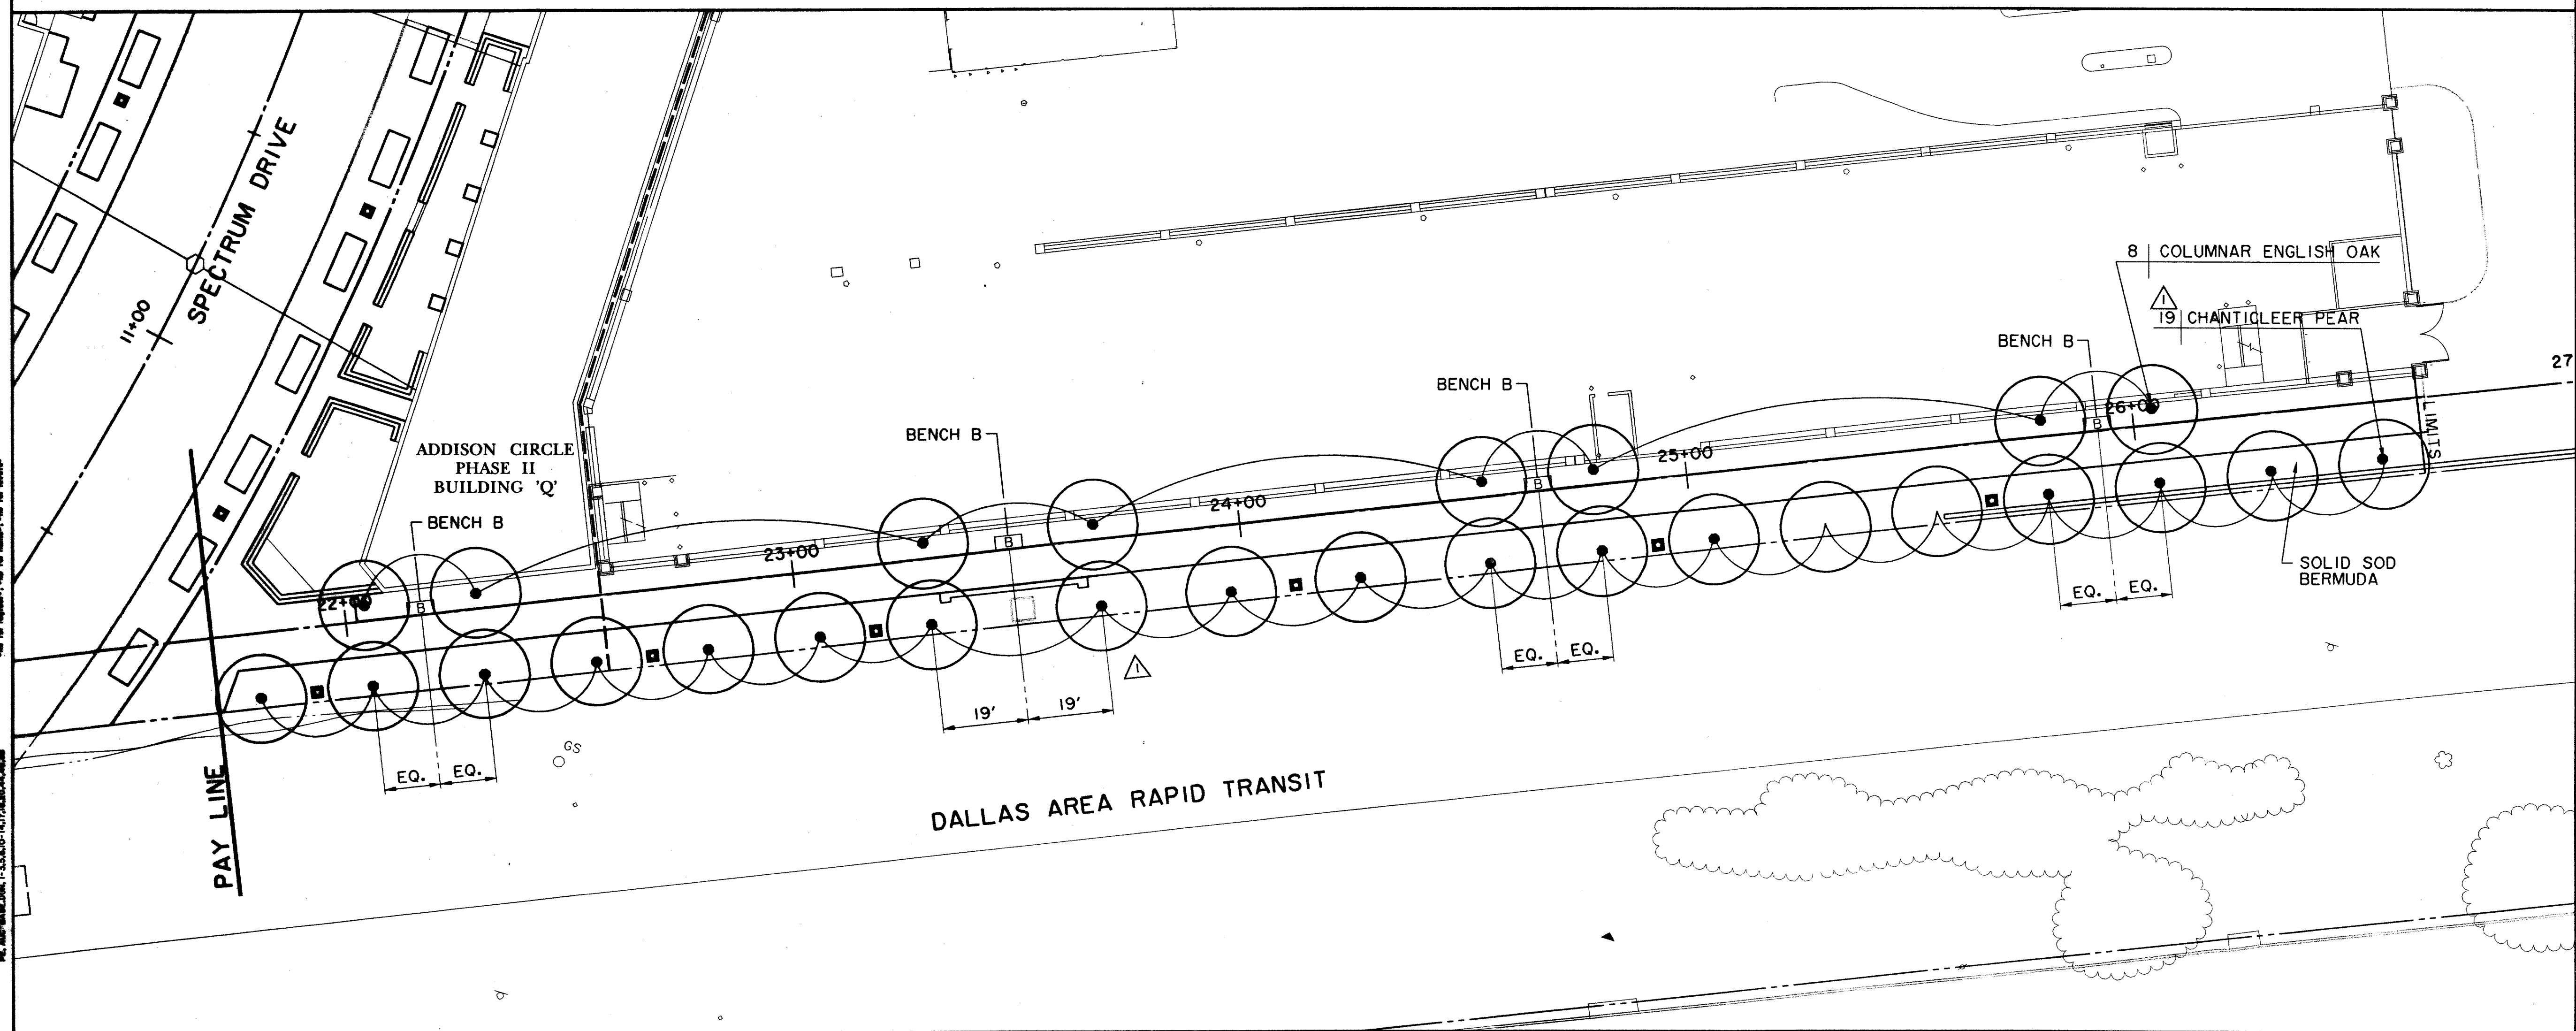

THE SEAL APPEARING ON THIS DOCUMENT WAS AUTHORIZED BY KAREN W. KOERTH, L.A. 1594

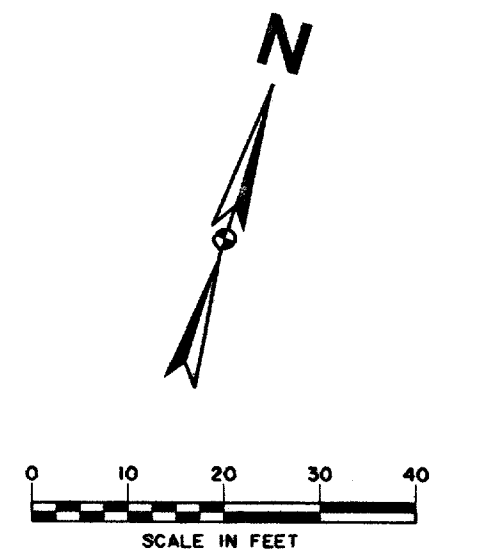

RECORD DRAWING

DATE	DESCRIPTION	REF. NO.
1/12/98	REVISED TREE SPACING; REMOVED TREE	▲
10/3/97	ISSUED FOR CONSTRUCTION	N/A
7/14/97	ISSUED FOR BID	N/A

PLANTING & FURNITURE PLAN
ADDISON CIRCLE / HIKE & BIKE
ADDISON CIRCLE
PHASE II PUBLIC INFRASTRUCTURE
TOWN OF ADDISON, TEXAS

Huitt-Zollars, Inc./Engineering/Architecture
 Dallas, Fort Worth, Houston, El Paso, Phoenix, Tustin, Ontario

DESIGN	DRAWN	APPR.	SCALE	DATE	PROJECT NO.	NO.
HZI	HZI	KWK	1"=20'	OCT. 97	01-1822-21	PF4

KAREN W. KOERTH, L.A. 1594
 REGISTERED LANDSCAPE ARCHITECT
 STATE OF TEXAS
 1100 W. WILSON ROAD, SUITE 100, ADDISON, TEXAS 75001
 TEL: 972-381-1111 FAX: 972-381-1112
 WWW.KOERTH.COM