


THE TOWN OF ADDISON, TEXAS
 ENGINEER
 KAREN W. KOERTH
 REGISTERED LANDSCAPE ARCHITECT
 LICENSE NO. 1594
 STATE OF TEXAS
 10/3/97 ISSUED FOR CONSTRUCTION
 7/14/97 ISSUED FOR BID
 HUII-ZOLLARS, INC./ENGINEERING/ARCHITECTURE
 DALLAS, FORT WORTH, HOUSTON, EL PASO, PHOENIX, TUSTIN, ONTARIO
 DESIGN: HZI DRAWN: HZI APPR: KWK SCALE: 1"=20' DATE: OCT. 97 PROJECT NO.: 01-1822-21 NO.: PF7

RECORD DRAWING

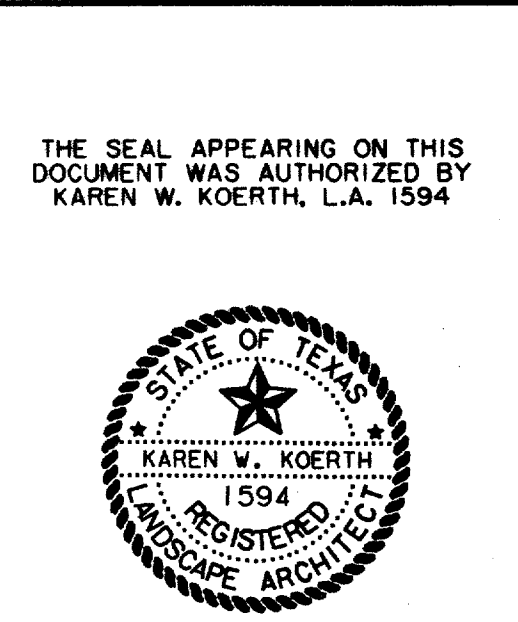

DATE	DESCRIPTION	REF. NO.
10/3/97	ISSUED FOR CONSTRUCTION	N/A
7/14/97	ISSUED FOR BID	N/A

PLANTING & FURNITURE PLAN						
M-2 SOUTH AND M-2 NORTH						
ADDISON CIRCLE						
PHASE II PUBLIC INFRASTRUCTURE						
TOWN OF ADDISON, TEXAS						
HUII-ZOLLARS, INC./ENGINEERING/ARCHITECTURE						
DALLAS, FORT WORTH, HOUSTON, EL PASO, PHOENIX, TUSTIN, ONTARIO						
DESIGN	DRAWN	APPR.	SCALE	DATE	PROJECT NO.	NO.
HZI	HZI	KWK	1"=20'	OCT. 97	01-1822-21	PF7