


C SPECIAL DETAIL  
SEE SHEET SP9

# RECORD DRAWING

## LEGEND

ELECTRIC — ONE —	48" RCP	MISC.
⊙ LIGHT POLE	— EX. STORM SEWER	— CHAIN LINK FENCE
PP POWER POLE	— WOOD FENCE	— EXISTING ASPHALT
← GUY WIRE	— EXISTING DIRT OR GRAVEL	— EX. CONCRETE
TELEPHONE — T —	— TREE/TREE LINE	— EXISTING CURB
TELEPHONE MANHOLE	— EXISTING CURB	— PROP. CURB
TELEPHONE PEDESTAL	— PROP. EDGE OF PAVEMENT NO CURB	— EX. PROPERTY LINE
TS TELEPHONE SIGN	— PROP. CENTERLINE	— PROP. R.O.W.
GAS — G —	— PROP. INLET	— T.P. TOP OF PAVEMENT
GM GAS METER	— T.C. TOP OF CURB	— CR CURB RETURN
GS GAS SIGN	— EX. T.C. EXISTING TOP OF CURB	— EX. G. EXISTING GUTTER
LAND USE	— B-20 BORING LOCATION	— EXISTING BRICKS
R/R RAILROAD SIGN	— EXISTING BRICKS	— PAVEMENT REMOVAL
SIGN	— PAVEMENT REMOVAL	
SURVEY		
I.R. FOUND IRON ROD		
BENCHMARK		
WASTE WATER — WW —		
WM WASTEWATER MANHOLE		
CO CLEANOUT		
WATER — W —		
FH FIRE HYDRANT		
METER		
WATER VALVE		

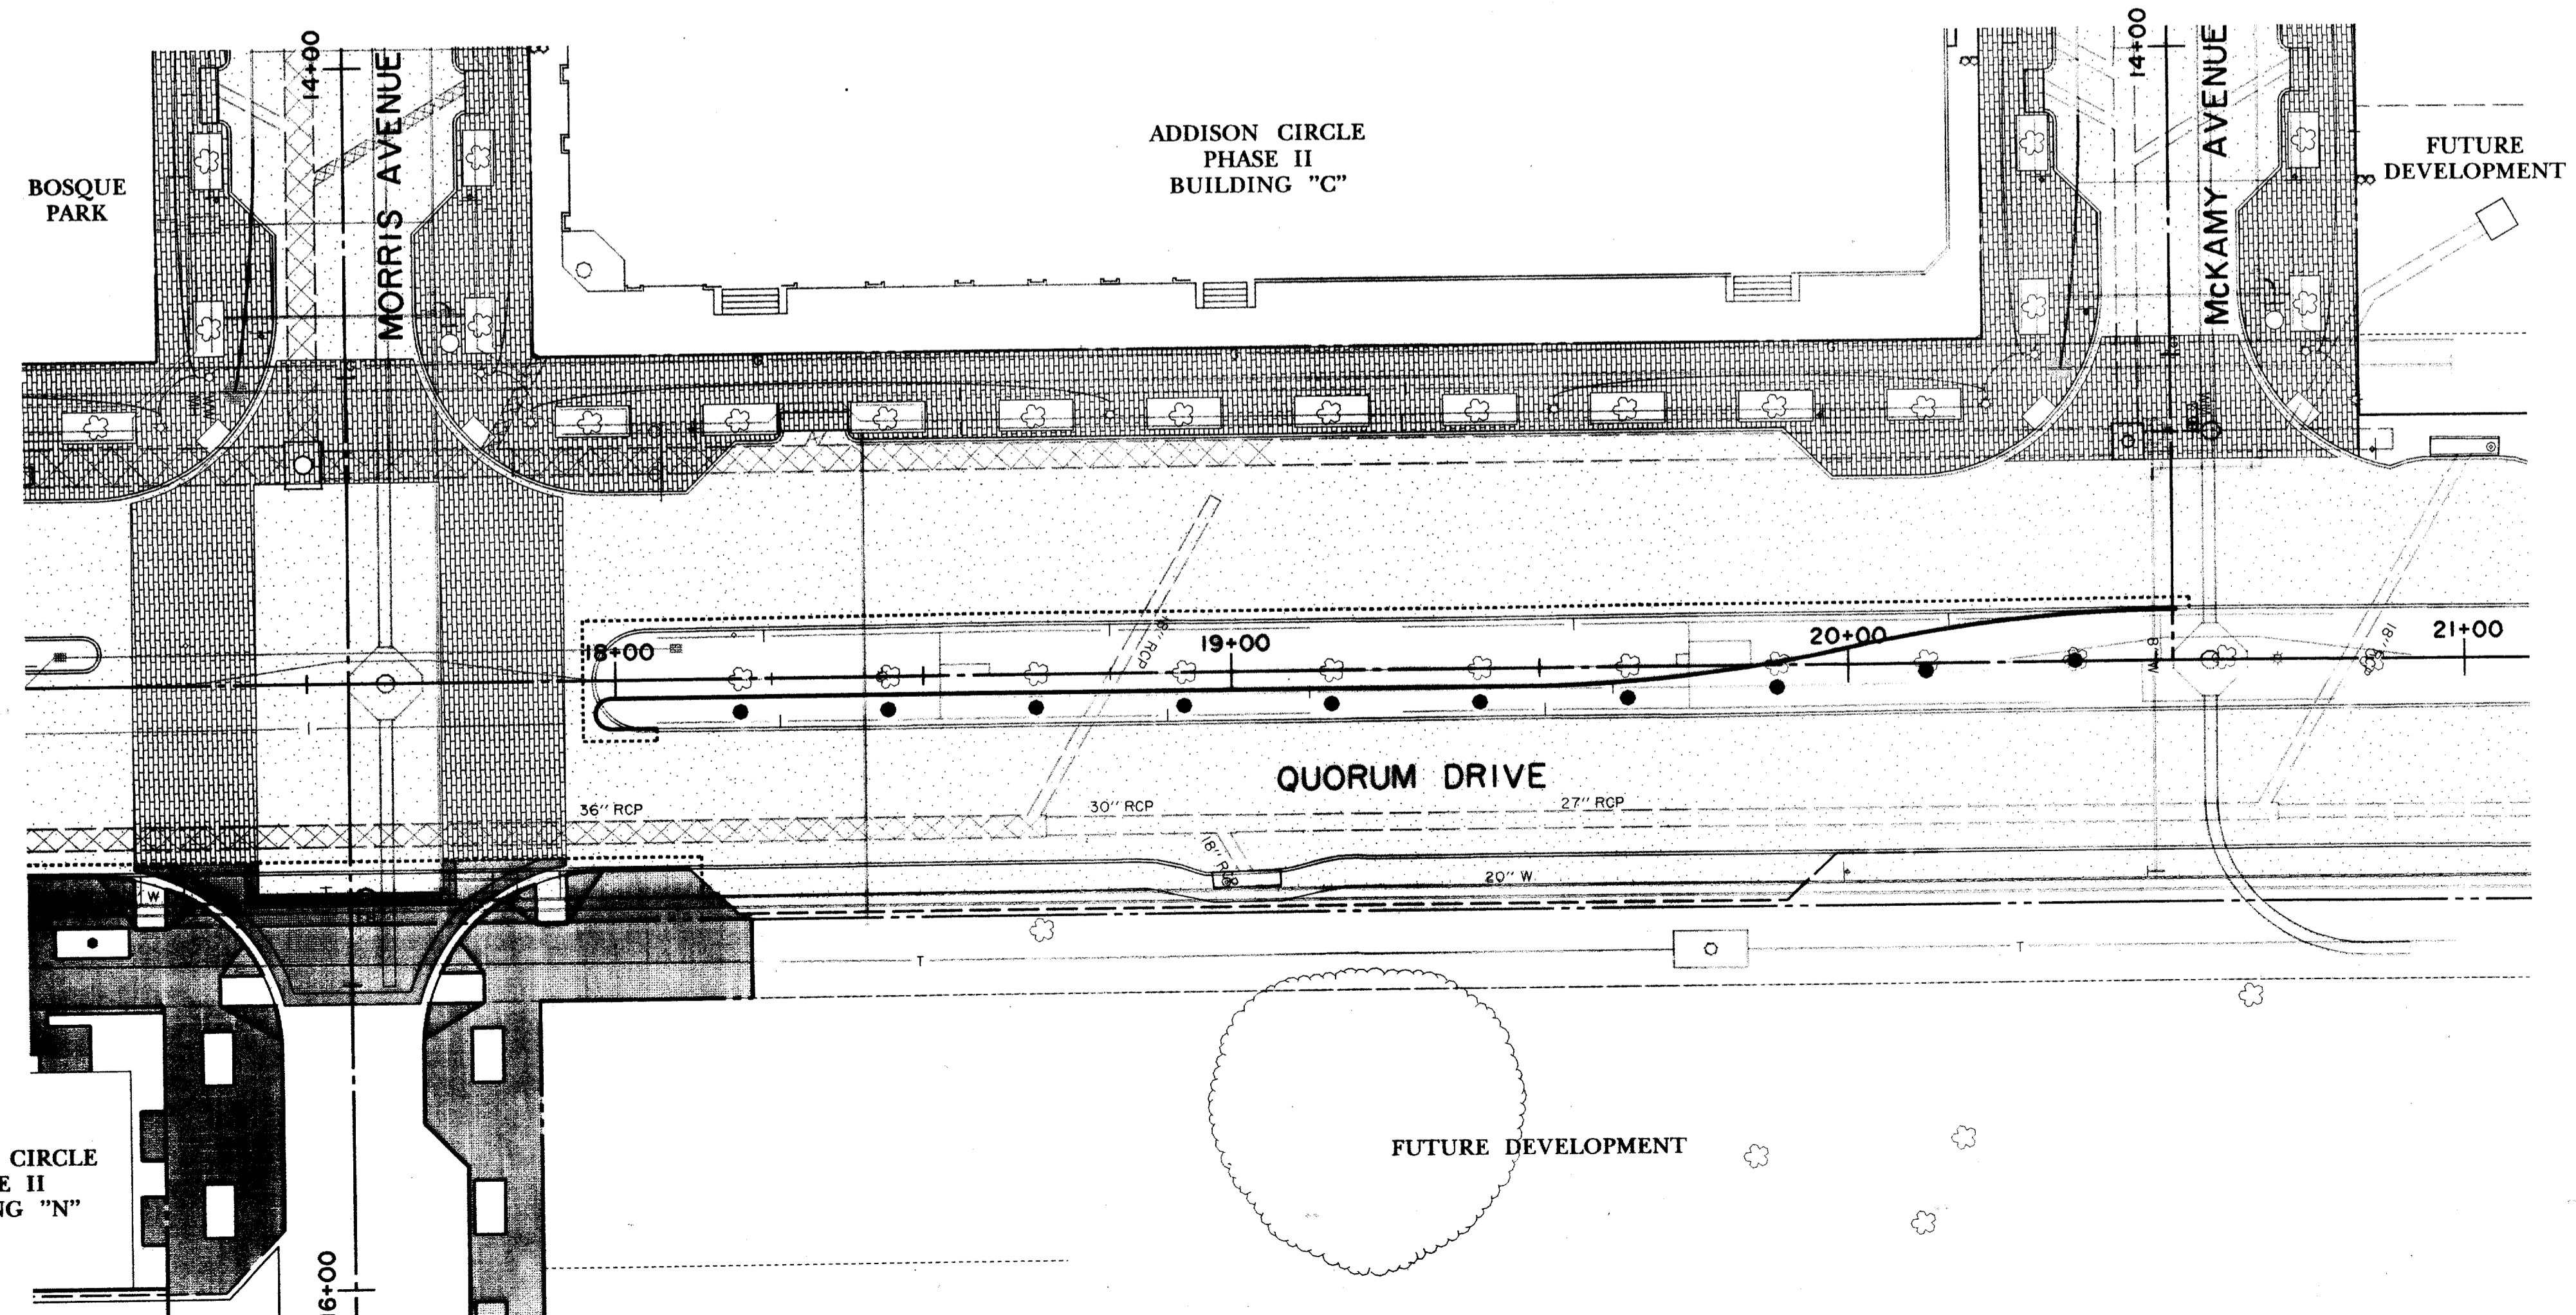

**BENCHMARKS:**  
 BM#1 "C" CUT AT CENTER BACK OF CURB OF INLET, 190 FEET SOUTH FROM THE CENTERLINE INTERSECTION OF ADDISON CIRCLE, WEST SIDE OF QUORUM DRIVE. ELEV. 621.89  
 BM#4 "C" CUT AT CENTER OF CURB INLET, 1015 FEET NORTH FROM THE CENTERLINE INTERSECTION OF ADDISON CIRCLE, WEST SIDE OF QUORUM DRIVE. ELEV. 629.36

THE SEAL APPEARING ON THIS DOCUMENT WAS AUTHORIZED BY DAVID E. MEYERS, P.E. 81512

DATE	DESCRIPTION	REF NO.
10/3/97	ISSUED FOR CONSTRUCTION	N/A
7/14/97	ISSUED FOR BID	N/A

**SURFACE PATTERNING PLAN**  
 EAST ROUNDABOUT - QUORUM DRIVE LT. TURN LANE  
**ADDISON CIRCLE**  
 PHASE II PUBLIC INFRASTRUCTURE  
 TOWN OF ADDISON, TEXAS  
 Huitt-Zollars, Inc./Engineering/Architecture  
 Dallas, Fort Worth, Houston, El Paso, Phoenix, Tustin, Ontario

DESIGN	DRAWN	APPR.	SCALE	DATE	PROJECT NO.	NO.
H21	H21	DEM	1"=20'	OCT. 97	01-1822-21	SP2

ALL DIMENSIONS UNLESS OTHERWISE SPECIFIED ARE IN FEET AND DECIMALS THEREOF.  
 ALL UTILITIES SHOWN ARE BASED ON RECORD DRAWINGS AND FIELD SURVEY.  
 THE CONTRACTOR SHALL VERIFY THE LOCATION AND DEPTH OF ALL UTILITIES PRIOR TO CONSTRUCTION.  
 THE CONTRACTOR SHALL BE RESPONSIBLE FOR OBTAINING ALL NECESSARY PERMITS AND APPROVALS.  
 THE CONTRACTOR SHALL MAINTAIN ACCESS TO ALL ADJACENT PROPERTIES AT ALL TIMES.  
 THE CONTRACTOR SHALL PROTECT ALL EXISTING UTILITIES AND STRUCTURES.  
 THE CONTRACTOR SHALL MAINTAIN THE STRENGTH AND INTEGRITY OF ALL EXISTING UTILITIES.  
 THE CONTRACTOR SHALL BE RESPONSIBLE FOR THE PROTECTION OF ALL ADJACENT PROPERTIES.  
