


THE SEAL APPEARING ON THIS DOCUMENT WAS AUTHORIZED BY DAVID E. MEYERS, P.E. 81512

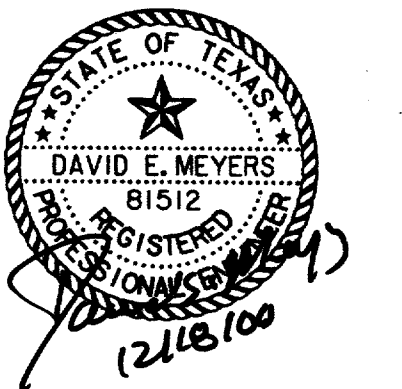

RECORD DRAWING

DATE	DESCRIPTION	REF NO.				
10/3/97	ISSUED FOR CONSTRUCTION	N/A				
7/14/97	ISSUED FOR BID	N/A				
SUBDRAIN DETAILS						
ADDISON CIRCLE						
PHASE II PUBLIC INFRASTRUCTURE						
TOWN OF ADDISON, TEXAS						
Huilt-Zollors, Inc./Engineering/Architecture Dallas, Fort Worth, Houston, El Paso, Phoenix, Tustin, Ontario						
DESIGN	DRAWN	APPR.	SCALE	DATE	PROJECT NO.	NO.
HZ1	HZ1	DEM	N.T.S.	OCT. 97	01-1822-21	ST14