


# RECORD DRAWING

## LEGEND

ELECTRIC	MISC.
○ LIGHT POLE	48" RCP EX. STORM SEWER
pp POWER POLE	CHAIN LINK FENCE
← GUY WIRE	WOOD FENCE
TELEPHONE — T — TELEPHONE	EXISTING ASPHALT
TELEPHONE MANHOLE	EXISTING DIRT OR GRAVEL
TELEPHONE PEDESTAL	EX. CONCRETE
TELEPHONE SIGN	TREE/TREE LINE
GAS — G — GAS	EXISTING CURB
GAS METER	PROP. CURB
GAS SIGN	PROP. EDGE OF PAVEMENT NO CURB
LAND USE	EX. PROPERTY LINE
RAILROAD SIGN	PROP. CENTERLINE
SIGN	PROP. R.O.W.
SURVEY	PROP. INLET
FOUND IRON ROD	T.P. TOP OF PAVEMENT
BENCHMARK	T.C. TOP OF CURB
WASTEWATER — WW — WASTEWATER	CR CURB RETURN
WASTEWATER MANHOLE	EX. G. EXISTING GUTTER
CLEANOUT	EX. T.C. EXISTING TOP OF CURB
WATER — W — WATER	B-20 BORING LOCATION
FIRE HYDRANT	EXISTING BRICKS
METER	PAVEMENT REMOVAL
WATER VALVE	

**NOTE:**  
CENTER TO CENTER TREE DIMENSIONS ARE MEASURED RADIALLY ALONG CENTERLINE OF OUTER RING OF TREES.

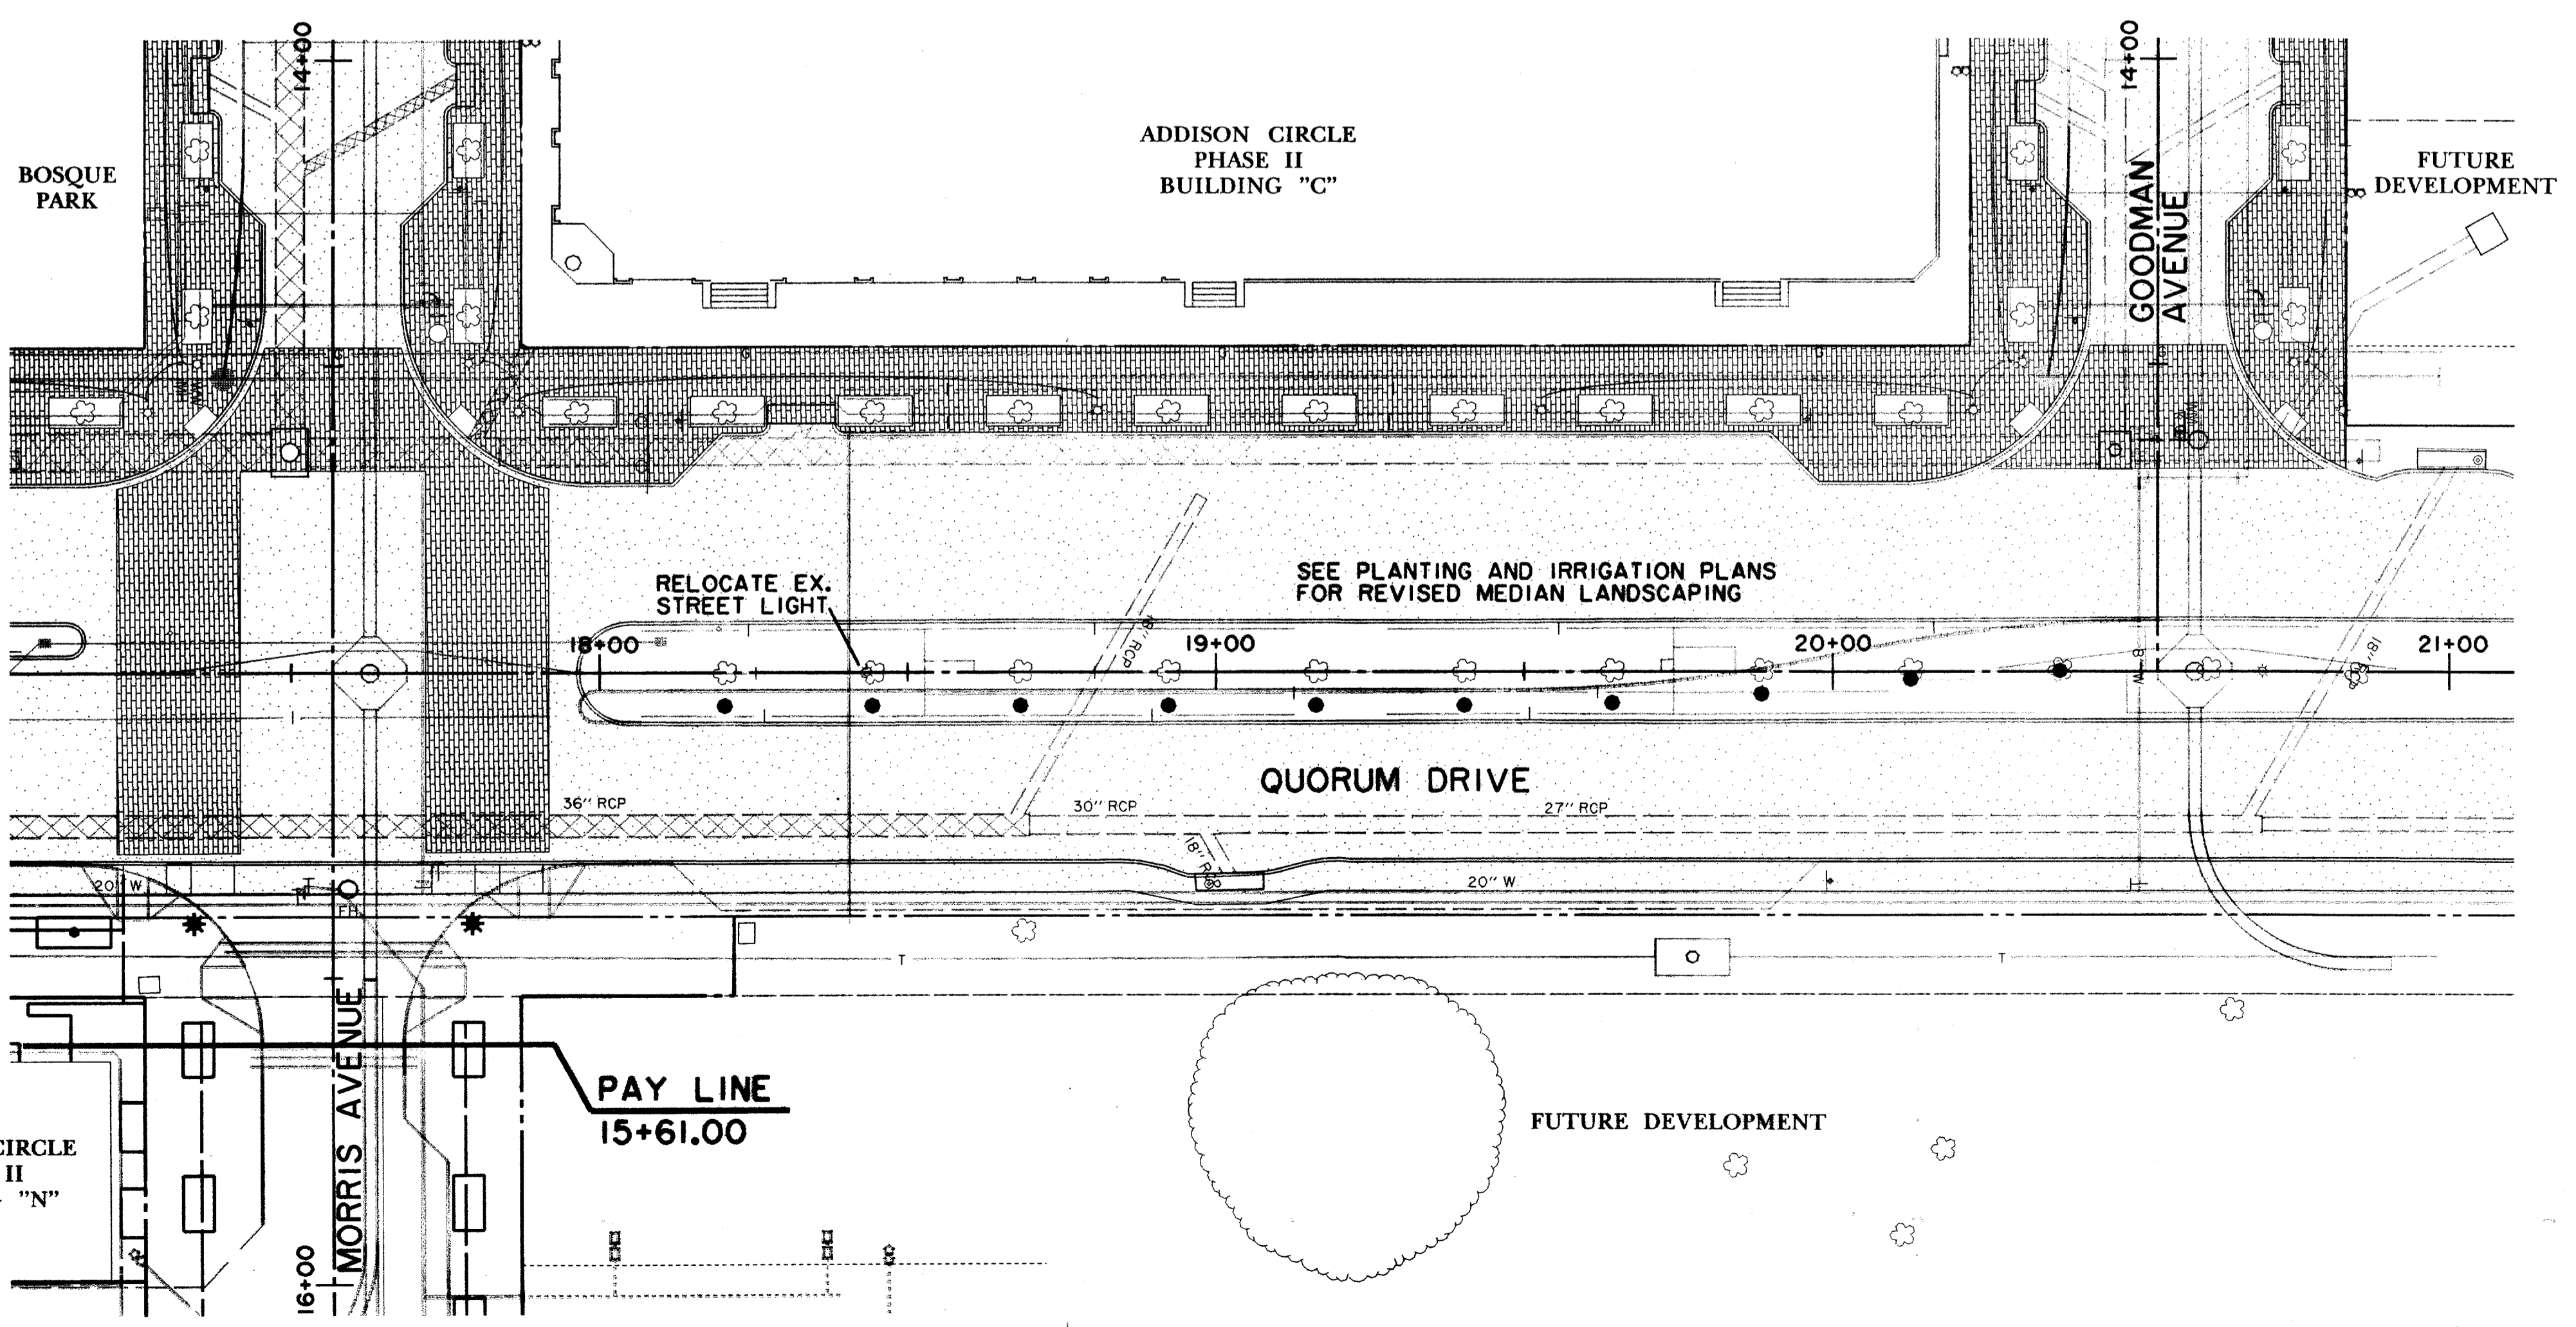

**BENCHMARKS:**  
BM#1  
"C" CUT AT CENTER BACK OF CURB OF INLET, 190 FEET SOUTH FROM THE CENTERLINE INTERSECTION OF ADDISON CIRCLE, WEST SIDE OF QUORUM DRIVE. ELEV. 621.89  
BM#4  
"C" CUT AT CENTER OF CURB INLET, 1015 FEET NORTH FROM THE CENTERLINE INTERSECTION OF ADDISON CIRCLE, WEST SIDE OF QUORUM DRIVE. ELEV. 629.36

THE SEAL APPEARING ON THIS DOCUMENT WAS AUTHORIZED BY DAVID E. MEYERS, P.E. 81512

DATE	DESCRIPTION	REF NO.
10/3/97	ISSUED FOR CONSTRUCTION	N/A
7/14/97	ISSUED FOR BID	N/A

**STREETSCAPE PLAN  
ROTARY EAST - QUORUM LEFT TURN LANE  
ADDISON CIRCLE  
PHASE II PUBLIC INFRASTRUCTURE  
TOWN OF ADDISON, TEXAS**

DESIGN	DRAWN	APPR.	SCALE	DATE	PROJECT NO.	NO.
HZI	HZI	DEM	1"=20'	OCT. 97	01-1822-21	<b>ST3</b>