


LINE 'A', LATERAL CONNECTIONS AND 4 FEET OF LATERAL PIPE CONSTRUCTED WITH THE ADDISON CIRCLE PHASE II MASS GRADING PROJECT UNDER A SEPARATE CONTRACT. CONTRACTOR SHALL REMOVE LATERAL PLUGS AND EXTEND LATERALS TO STUB-OUTS OR INLETS IN THIS CONTRACT.

LEGEND

ELECTRIC	—O—	48" RCP	MISC.
□	LIGHT POLE	—	EX. STORM SEWER
PP	POWER POLE	—	CHAIN LINK FENCE
←	GUY WIRE	—	WOOD FENCE
TELE	TELEPHONE	—T—	EXISTING ASPHALT
MH	TELEPHONE MANHOLE	—	EXISTING DIRT OR GRAVEL
TS	TELEPHONE SIGN	—	EX. CONCRETE
GM	GAS METER	—	TREE/TREE LINE
GS	GAS SIGN	—	EXISTING CURB
LAND USE		—	PROP. CURB
R/S	RAILROAD SIGN	—	PROP. EDGE OF PAVEMENT NO CURB
□	SIGN	—	EX. PROPERTY LINE
I.R.	FOUND IRON ROD	—	PROP. CENTERLINE
W	BENCHMARK	—	PROP. R.O.W.
WM	WASTEWATER MANHOLE	—	PROP. INLET
CO	CLEANOUT	—	T.P.
FW	FIRE HYDRANT	—	T.C.
M	METER	—	TOP OF CURB
T	WATER VALVE	—	CR
		—	EX. G
		—	EXISTING TOP OF CURB
		—	EX. T.C.
		—	B-20
		—	BORING LOCATION
		—	EXISTING BRICKS
		—	PAVEMENT REMOVAL

RECORD DRAWING

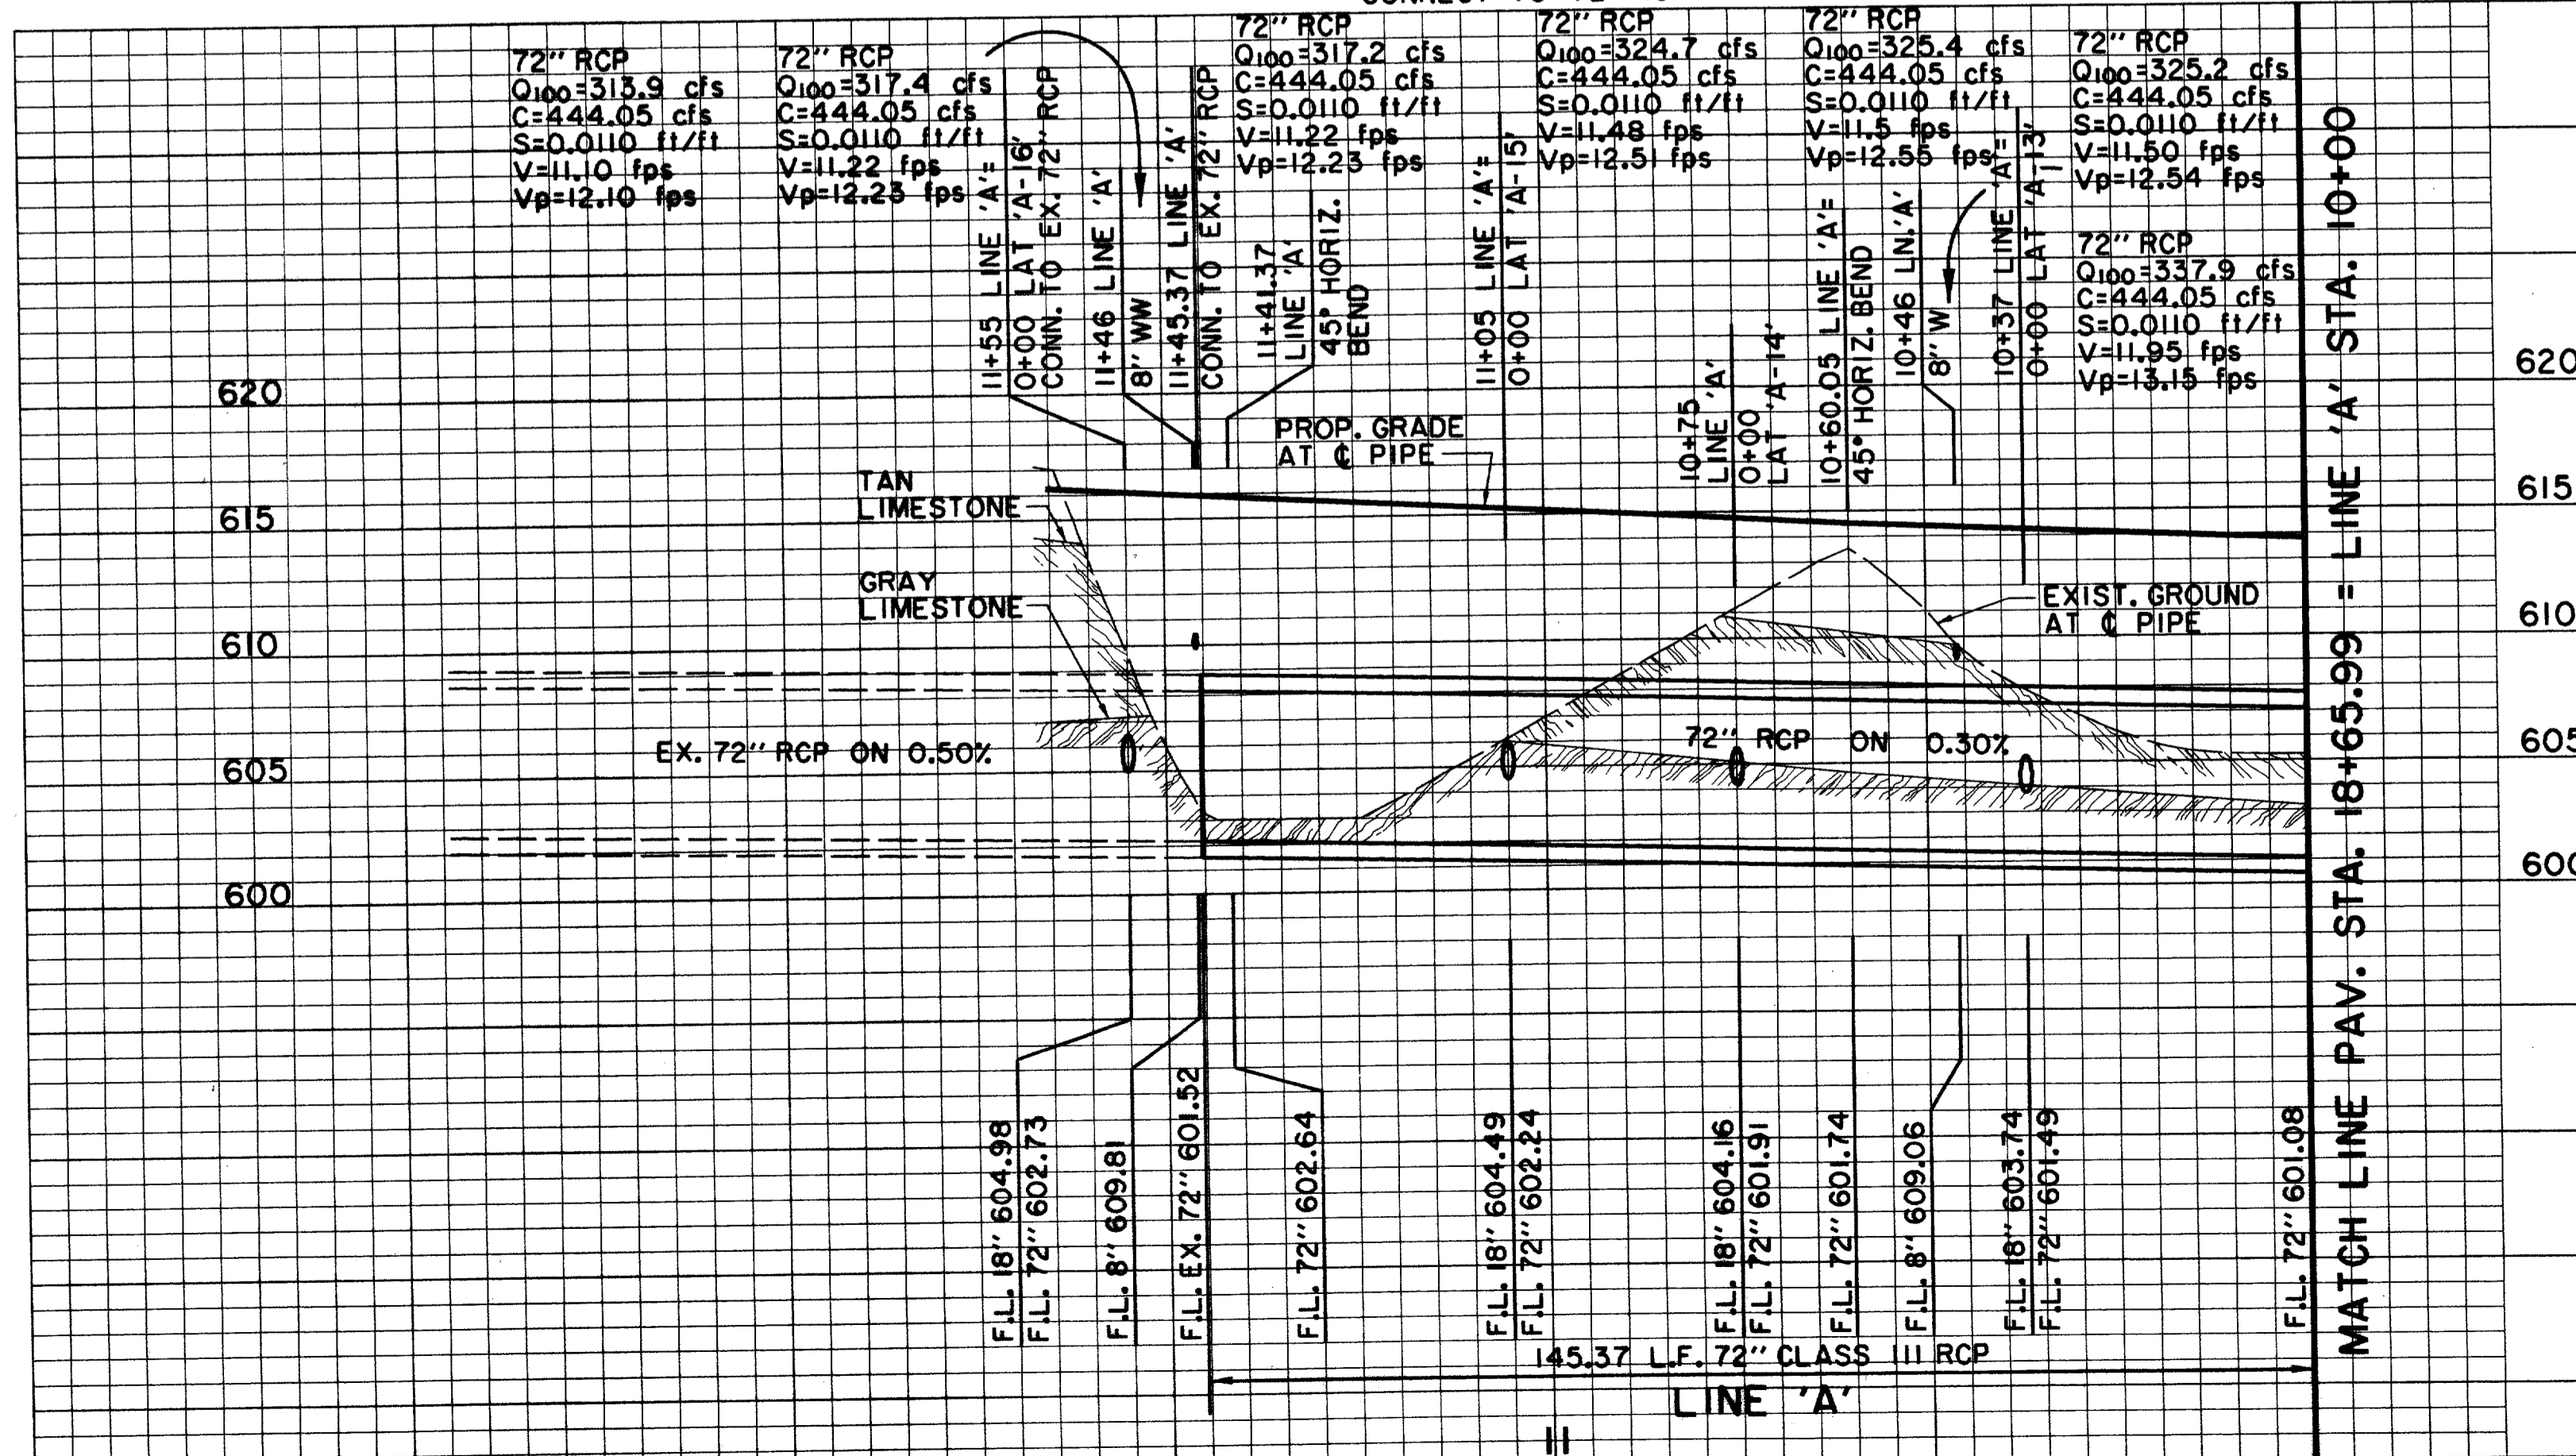

BENCHMARKS:

BM#1
"D" CUT AT CENTER BACK OF CURB OF INLET, 190 FEET SOUTH FROM THE CENTERLINE INTERSECTION OF MILDRED STREET, WEST SIDE OF QUORUM DRIVE. ELEV. 621.89

BM#4
"D" CUT AT CENTER OF CURB INLET, 1015 FEET NORTH FROM THE CENTERLINE INTERSECTION OF MILDRED STREET, WEST SIDE OF QUORUM DRIVE. ELEV. 629.36

DATE	DESCRIPTION	REF. NO.
10/3/97	ISSUED FOR CONSTRUCTION	N/A
7/14/97	ISSUED FOR BID	N/A

STORM WATER PLAN & PROFILE
LINE 'A' STA. 10+00 TO STA. 11+53.7

ADDISON CIRCLE
PHASE II PUBLIC INFRASTRUCTURE
TOWN OF ADDISON, TEXAS

Huiji-Zollars, Inc./Engineering/Architecture
Dallas, Fort Worth, Houston, El Paso, Phoenix, Tustin, Ontario

DESIGN	DRAWN	APPR.	SCALE	DATE	PROJECT NO.	NO.
HZI	HZI	DEM	H: 1"=20' V: 1"=6'	OCT. 97	01-1822-21	SW13

THE SEAL APPEARING ON THIS DOCUMENT WAS AUTHORIZED BY DAVID E. MEYERS, P.E. 81512

DAVID E. MEYERS
REGISTERED PROFESSIONAL ENGINEER
NO. 81512
STATE OF TEXAS
12/18/00

HUIJI-ZOLLARS, INC. ENGINEERING ARCHITECTURE
 1800 WEST LOOP SOUTH, SUITE 1000, DALLAS, TEXAS 75241
 TEL: 972-243-8800 FAX: 972-243-8801
 WWW: WWW.HUIJI-ZOLLARS.COM
 PROJECT NO. 01-1822-21-01
 SHEET NO. SW13 OF 13
 DATE: OCTOBER 1997
 DRAWN BY: HZI
 CHECKED BY: DEM
 APPROVED BY: HZI