

N.T.S.

NOTE:

- I. PROVIDE ALL INSTALLATION HARDWARE INCLUDING UNISTRUT FRAMEWORK FOR SECURE INSTALLATION.
- 2. TERMINAL BLOCK CAN TO HAVE BLOCKS AND SPACE FOR MIN. OF 12 MORE CIRCUITS FOR FUTURE EXPANSION.
- 3. EXACT LOCATION OF PANEL TO BE DETERMINED AT PROJECT SITE.
- 4. SERIES RATING FOR CIRCUIT BREAKERS SHALL BE 65K AIC.
- 5. ENTIRE INSTALLATION TO BE RATED FOR OUTDOOR INSTALLATION. PANEL AND SWITCH SHALL HAVE PROVISIONS FOR LOCKING.
- 6. EXACT LOCATIONS OF EQUIPMENT SHALL BE DETERMINED AT THE PROJECT SITE.
- 7. PROGRAM LIGHTS "ON" BY PHOTO CELL AND "OFF" BY TIME CLOCK.

LIGHT FIXTURE SCHEDULE						
TYPE	DESCRIPTION	LAMP	MANUFACTURER	CATALOGUE NO.	FINISH	
Α	CUSTOM STYLE	175 MH	BEGA	980IMH	BLACK	
A-POLE	15'-8'' ROUND		BEGA	1508HR	BLACK	
В	CUSTOM STYLE	175 MH	BEGA	980IMH (2 PER POLE)	BLACK	
B-POLE	15'-8" ROUND		BEGA	1508HR	BLACK	

NOTES

I. PROVIDE REINFORCED CONCRETE BASE, ANCHOR BOLTS AND REQUIRED ACCESSORIES.

2. BID SHALL BE BASED UPON THE ABOVE LISTED FIXTURES TO MATCH PHASE IFIXTURES.

3. PROVIDE MATCHING BASE COVER FOR EACH FIXTURE.

4. ALL FIXTURES ARE 240 VOLT AND REQUIRE DOUBLE FUSING.

5. A CUSTOM HINGED POLE IS REQUIRED FOR FIXTURE TYPE A & B (45^ HINGED).

6. REFER TO SPECIFICATIONS FOR ADDITIONAL INFORMATION.

7. FIXTURES TYPE B TO BE INSTALLED 90° APART.




	GENERAL NOTES			
NUMBER	DESCRIPTION	DE		
I	THE TERM 'PROVIDE' SHALL MEAN FOR THE CONTRACTOR TO FURNISH AND INSTALL A COMPLETE OPERATING SYSTEM.	DE		
2	REFER TO PHASE IPUBLIC INFRASTRUCTURE DRAWINGS FOR ADDITIONAL INFORMATION ON TREE LIGHTING CONDUIT LOCATIONS.			
	KEY NOTES (SEE E14)			
NUMBER	DESCRIPTION			
	TU ELECTRIC TRANSFORMER WITH SINGLE PHASE TRANSFORMER FOR STREET LIGHTING. VERIFY POINT OF CONNECTION WITH TU ELECTRIC.	T ()		
2	PROVIDE 120/240 VOLT, I PHASE, 3 WIRE, W/GND PANELBOARD WITH MAIN CONTACTOR. CONNECT TO ELECTRIC UTILITY AT DESIGNATED SERVICE POINTS. SEE DETAIL ION SHEET E15.			
3	STREET LIGHT FIXTURE TYPE A. INSTALL CONCRETE BASE, POLE, FIXTURE AND CONNECTIONS. REFER TO SHEET ST5 FOR POLE BASE DETAIL.			
4	CIRCUIT TO STREET LIGHTS OF 3 #8 - 2"C UNLESS NOTED OTHER WISE ON CIRCUIT SCHEDULE.			
5	ROUTE CIRCUITRY THROUGH CONDUITS AND PULL BOXES. MAKE SPLICE IN MAIN FEEDERS USING HIGH COMPRESSION SPLICE FITTING.			
(E)	PHOTO ELECTRIC CELL ON TOP OF POLE FACING NORTH.			
7	LOCATE EXISTING CAPPED CONDUIT AND EXTEND TO NEW FIXTURE(S). INSTALL WIRE BACK TO EXISTING FIXTURE AND CONNECT CIRCUIT.	The second secon		
8	CAP CONDUIT FOR FUTURE EXTENSION.			
	ELECTRICAL LEGEND			
SYMB	DESCRIPTION			
	2" CONDUIT FOR STREET LIGHTING CIRCUITS FROM PANELBOARD TO EACH PULL BOX AND TO EACH STREET LIGHT FIXTURE.			
	HH PULL BOX. (12" W x 12" D x 18" L)			
RI	CONDUIT IDENTIFICATION FOR NEW MAIN FEEDERS.			
R-2,	CIRCUIT NUMBERS FROM PANELS AT SERVICE POINTS INDICATED IN DRAWING EI4.			
-	HOME RUN TO PANEL. PROVIDE CONDUIT AND WIRE FROM PULL BOX TO PANELBOARD.			
•	STREET LIGHT FIXTURE TYPE 'A'.			
*	STREET LIGHT FIXTURE TYPE 'B'.			
Ļ				

GENERAL ELECTRICAL NOTES FOR THIS PROJECT WHICH APPLY TO DRAWING EI4:

I. LOCATIONS OF ALL LIGHT FIXTURES, PULL BOXES AND ROUTING OF CONDUITS SHALL BE IDENTIFIED ON THE SITE BY STAKES AND PAINT PRIOR TO ANY EXCAVATION. REQUIREMENTS FOR CONDUIT ROUTING ARE PROVIDED ON DRAWINGS AND SPECIFICATIONS. OWNER WILL REVIEW AT THE SITE AND PROVIDE DIRECTIONS ON FIELD ADJUSTMENTS OF UP TO 10 FOOT FROM LOCATIONS SHOWN ON THE DRAWINGS.

2. CONTRACTOR SHALL COORDINATE STORM WATER, WASTEWATER, WATER, IRRIGATION AND ELECTRICAL CONDUIT TRENCHING AND INSTALLATION TO MINIMIZE THE DISTURBANCE OF EXISTING TREE ROOTS.

3. ALL PULL BOXES ARE 12" X 18" X 12" DEEP CONCRETE BOX WITH BOLT ON CONCRETE COVER SIMILAR TO T.U. SUBSURFACE SECONDARY BOX. INSTALL CONDUITS NEAR CORNER OF BOX TO ALLOW CONDUCTORS TO LOOP THROUGH BOX.

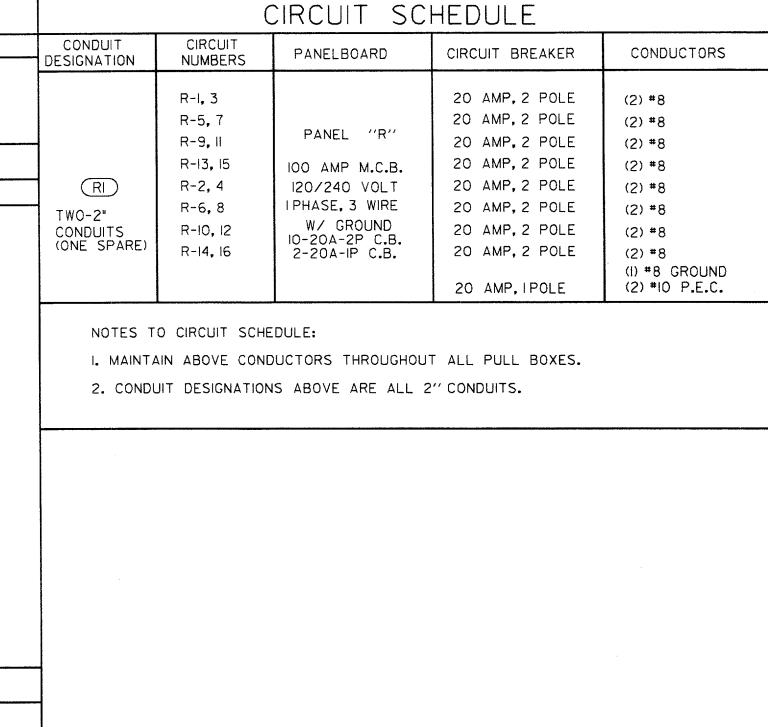



DATE	DESCRIPTION	REF NO.
		
. ,		
6/23/99	ISSUED FOR CONSTRUCTION	N/A
5/17/99	ISSUED FOR BID	N/A

STREET LIGHT NOTES & DETAILS

ADDISON CIRCLE

PHASE II-B PUBLIC INFRASTRUCTURE

TOWN OF ADDISON, TEXAS

Huitt - Zollars, Inc.
3131 Mckinney Ave., Suite 600, Dallas, TX 75204
Phone (214) 871-3311/Fax (214) 871-0757

DRAWN APPR. SCALE DATE PROJECT NO.

DEM N.T.S. MAR. 99 01-1822-50 EIS

RECORD DRAWING

DESIGN

HZI

HZI

\$\$DGN\$SPECIFICATION\$\$