

ADDISON ROAD

NOT IN CONTRACT

NOTES:

1. ALL TRAFFIC SIGN DESIGN, FABRICATION AND PLACEMENT SHALL CONFORM TO THE LATEST ISSUE OF THE "TEXAS MANUAL ON UNIFORM TRAFFIC CONTROL DEVICES FOR STREETS AND HIGHWAYS".
2. STREET NAME SIGNS ARE TO BE MOUNTED PER TABLE ON THIS DRAWING.
3. PRIOR TO FINAL INSTALLATION OF SIGNS, CONTRACTOR SHALL REVIEW PLACEMENT WITH THE DIRECTOR OF PUBLIC WORKS TO ENSURE PROPER VISIBILITY RELATIVE TO COMPLETION OF OTHER IMPROVEMENTS.

STREET NAME SIGNS			
SIGN NO./ LOCATION	STREET NAME	BLOCK NO.	MOUNTING
①	MORRIS AVE.	4900	NEW SIGN POLE
	ARTIST WAY	15700	
②	GOODMAN AVE.	4900	NEW SIGN POLE
	ARTIST WAY	15700	
NOT IN CONTRACT			

RECORD DRAWING


BENCHMARKS:

BM#5
"I" CUT ON 8' INLET ON NORTH CURB LINE OF GOODMAN AVE. ±75' EAST OF PASCHAL PLACE. ELEV. 629.98

BM#6
"I" CUT AT C/O OF 8' INLET AT THE SOUTHWEST CORNER OF MORRIS AVE. AND WITT PLACE. ELEV. 627.29

BM#7
"I" CUT AT WEST CORNER OF ADDISON THEATRE CENTRE PARKING LOT, SECOND ENTRANCE NORTH OF ADDISON RD. ELEV. 637.66

THE SEAL APPEARING ON THIS DOCUMENT WAS AUTHORIZED BY DAVID E. MEYERS, P.E. 81512

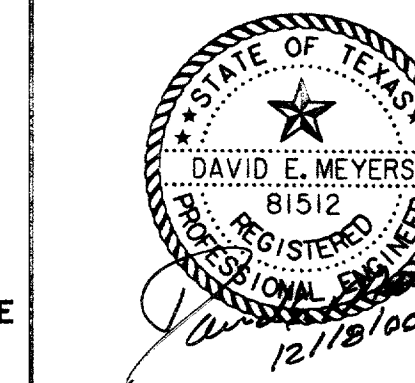

U.S. POST OFFICE

DATE	DESCRIPTION	REF NO.
6/23/99	ISSUED FOR CONSTRUCTION	N/A
5/17/99	ISSUED FOR BID	N/A

SIGNAGE AND STRIPING PLAN

ADDISON CIRCLE

PHASE II-B PUBLIC INFRASTRUCTURE

TOWN OF ADDISON, TEXAS

Hill - 2011, Inc.
3131 McKinney Ave., Suite 600, Dallas, TX 75204
Phone (214) 871-3311/Fax (214) 871-0757

DESIGN	DRAWN	APPR.	SCALE	DATE	PROJECT NO.	NO.
HZI	HZI	DEM	1"=50'	MAR. 99	01-1822-50	P6

P:\proj\01182250\dm\AUC35M04.DGN
 P:\proj\01182250\dm\AUC35M04.DGN
