

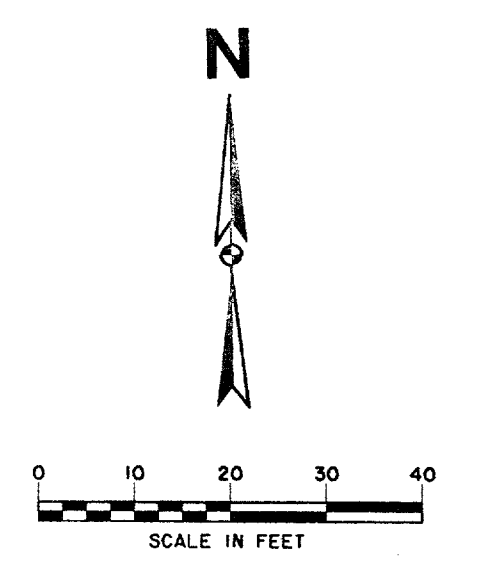


H:\PROJECTS\2009\ADDISON\ADDISON.dwg
 PLOT DATE: 03/13/2010 10:00:00
 PLOT BY: J. ZOLLERS
 H:\PROJECTS\2009\ADDISON\ADDISON.dwg
 PLOT DATE: 03/13/2010 10:00:00
 PLOT BY: J. ZOLLERS

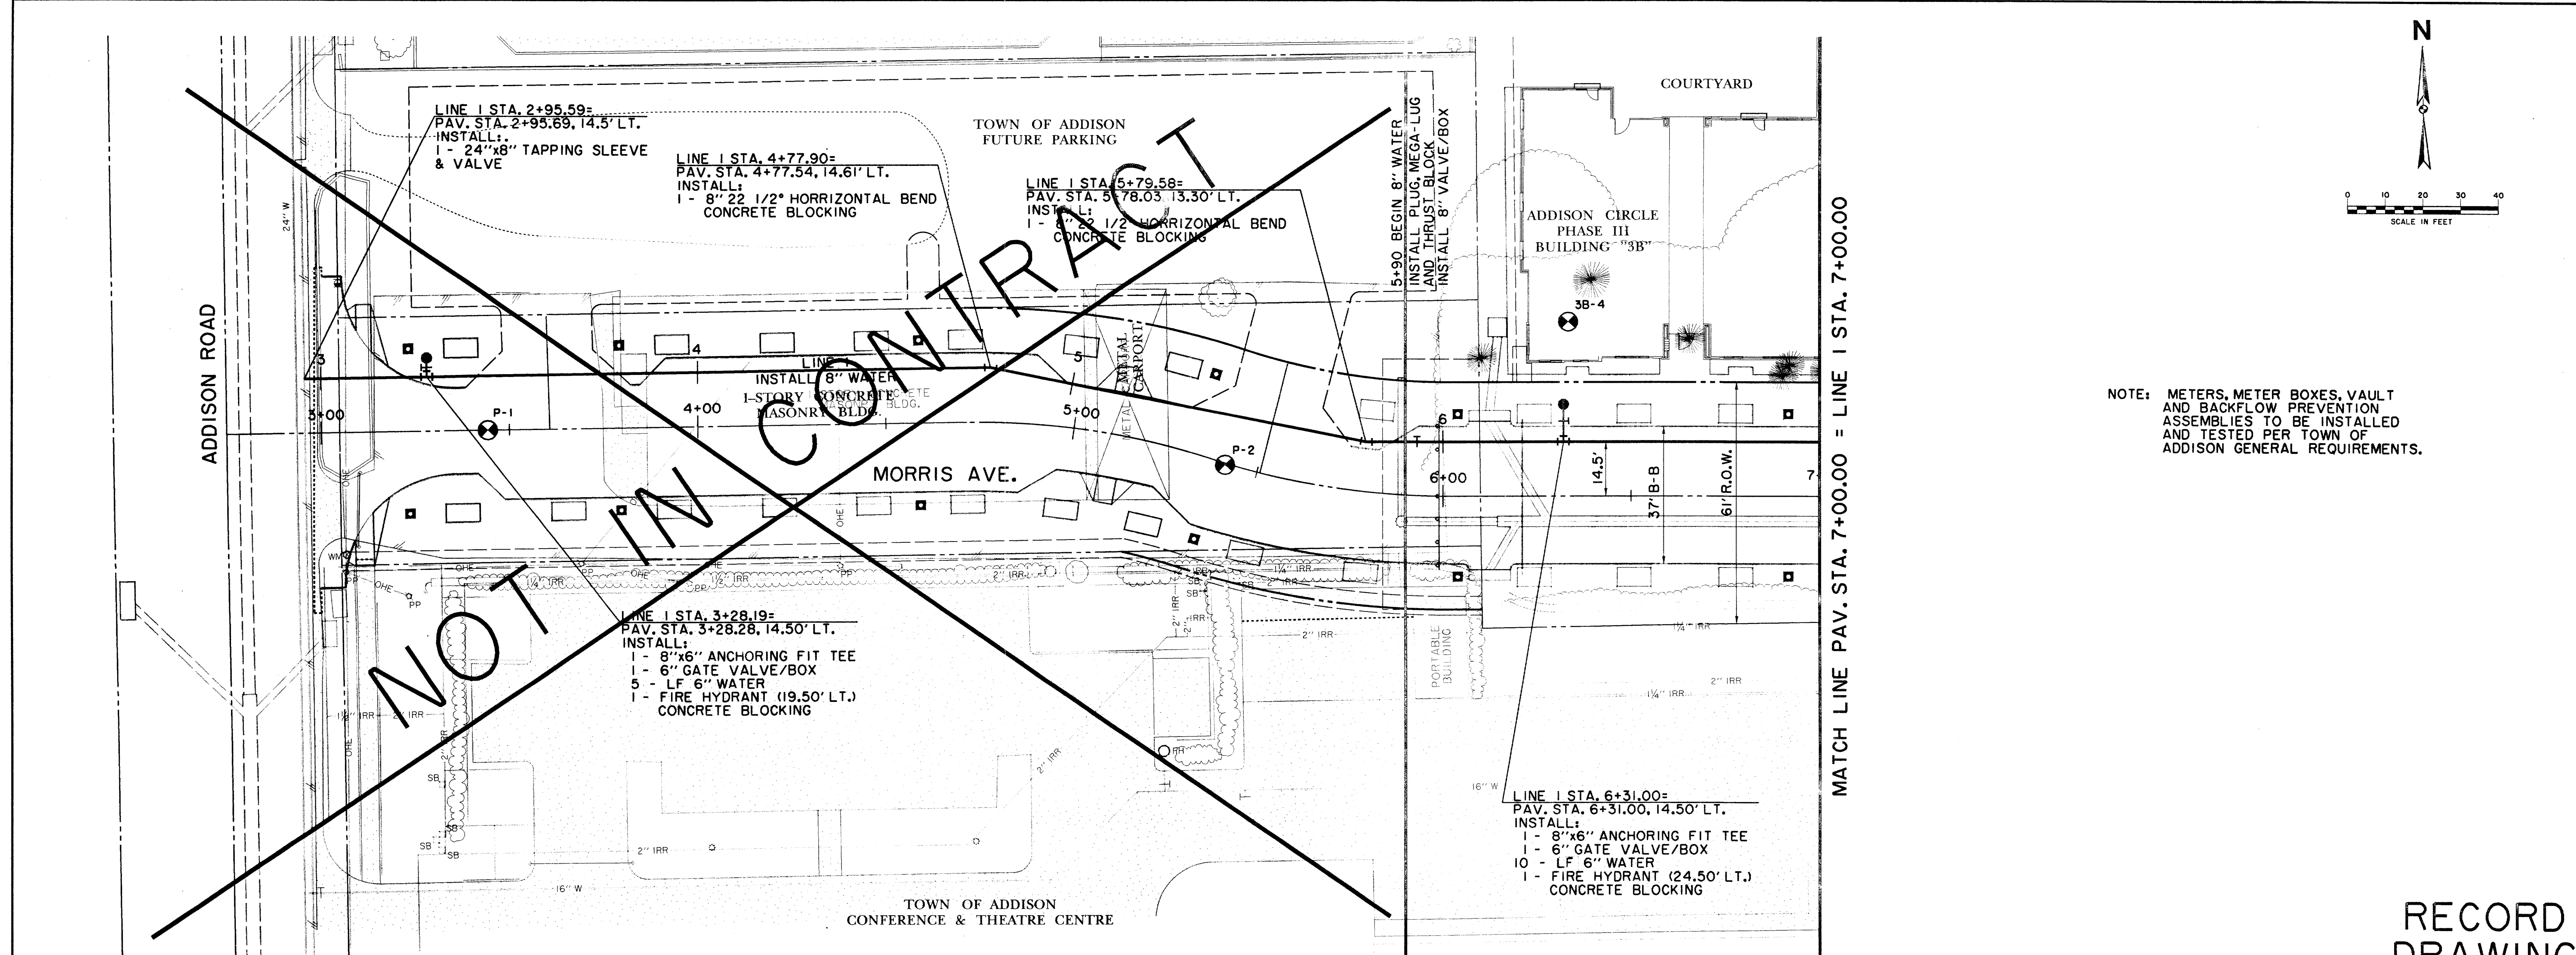

NOTE: METERS, METER BOXES, VAULT AND BACKFLOW PREVENTION ASSEMBLIES TO BE INSTALLED AND TESTED PER TOWN OF ADDISON GENERAL REQUIREMENTS.

RECORD DRAWING

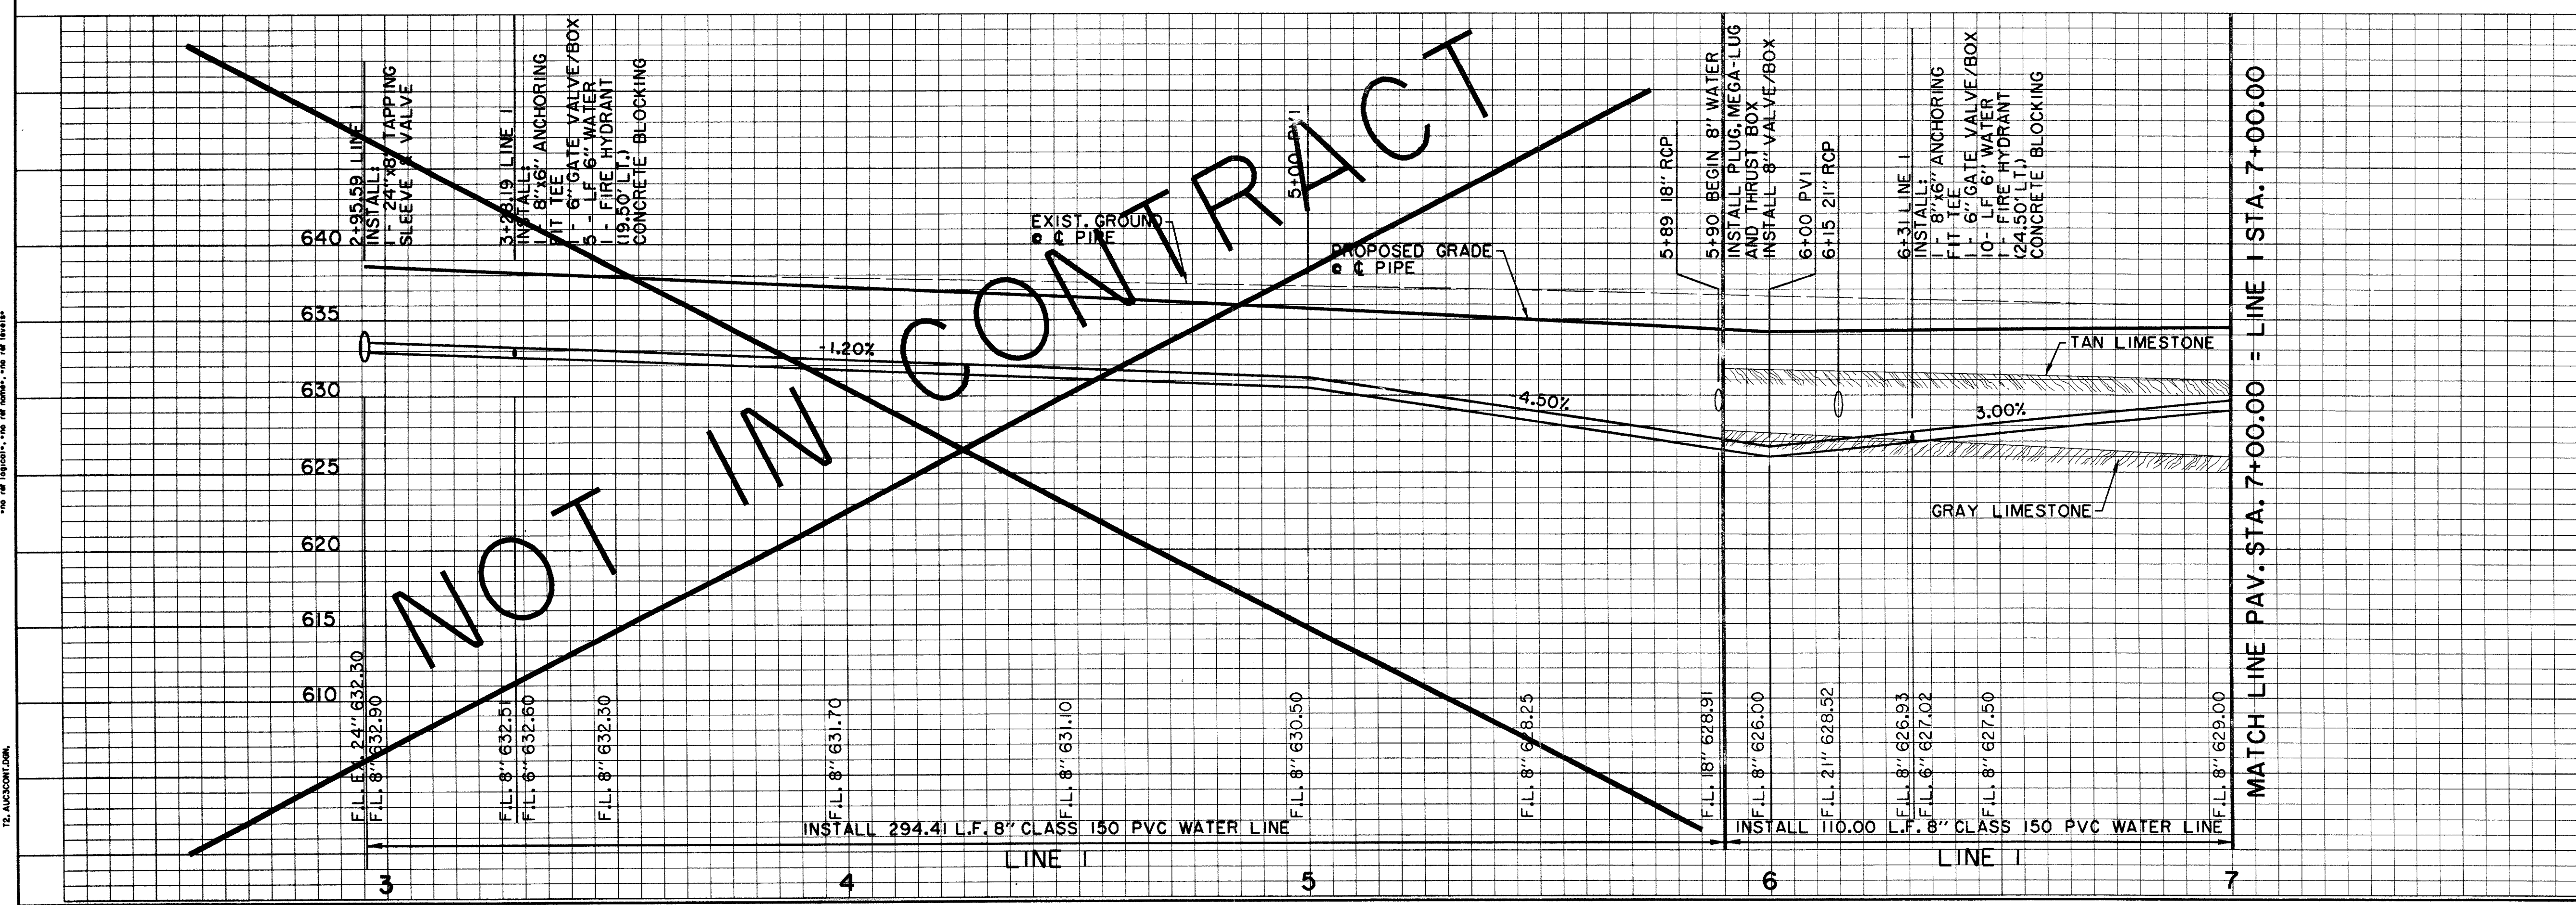

DATE	DESCRIPTION	REF NO.
6/23/99	ISSUED FOR CONSTRUCTION	N/A
5/17/99	ISSUED FOR BID	N/A

BENCHMARKS:	
BM#5	"I" CUT ON 8" INLET ON NORTH CURB LINE OF GOODMAN AVE. 75' EAST OF PASCHAL PLACE. ELEV. 629.98
BM#6	"I" CUT AT C OF 8" INLET AT THE SOUTHWEST CORNER OF MORRIS AVE. AND WITT PLACE. ELEV. 627.29
BM#7	"I" CUT AT WEST CORNER OF ADDISON THEATRE CENTRE PARKING LOT, SECOND ENTRANCE NORTH OF ADDISON RD. ELEV. 637.66

WATER PLAN & PROFILE	
LINE I - MORRIS AVE.	
ADDISON CIRCLE	
PHASE II-B PUBLIC INFRASTRUCTURE	
TOWN OF ADDISON, TEXAS	
DESIGN	HZI
DRAWN	HZI
APPR.	DEM
SCALE	H ₁ 1"=20' V ₁ 1"=6'
DATE	MAR. 99
PROJECT NO.	01-1822-50
NO.	W2

