
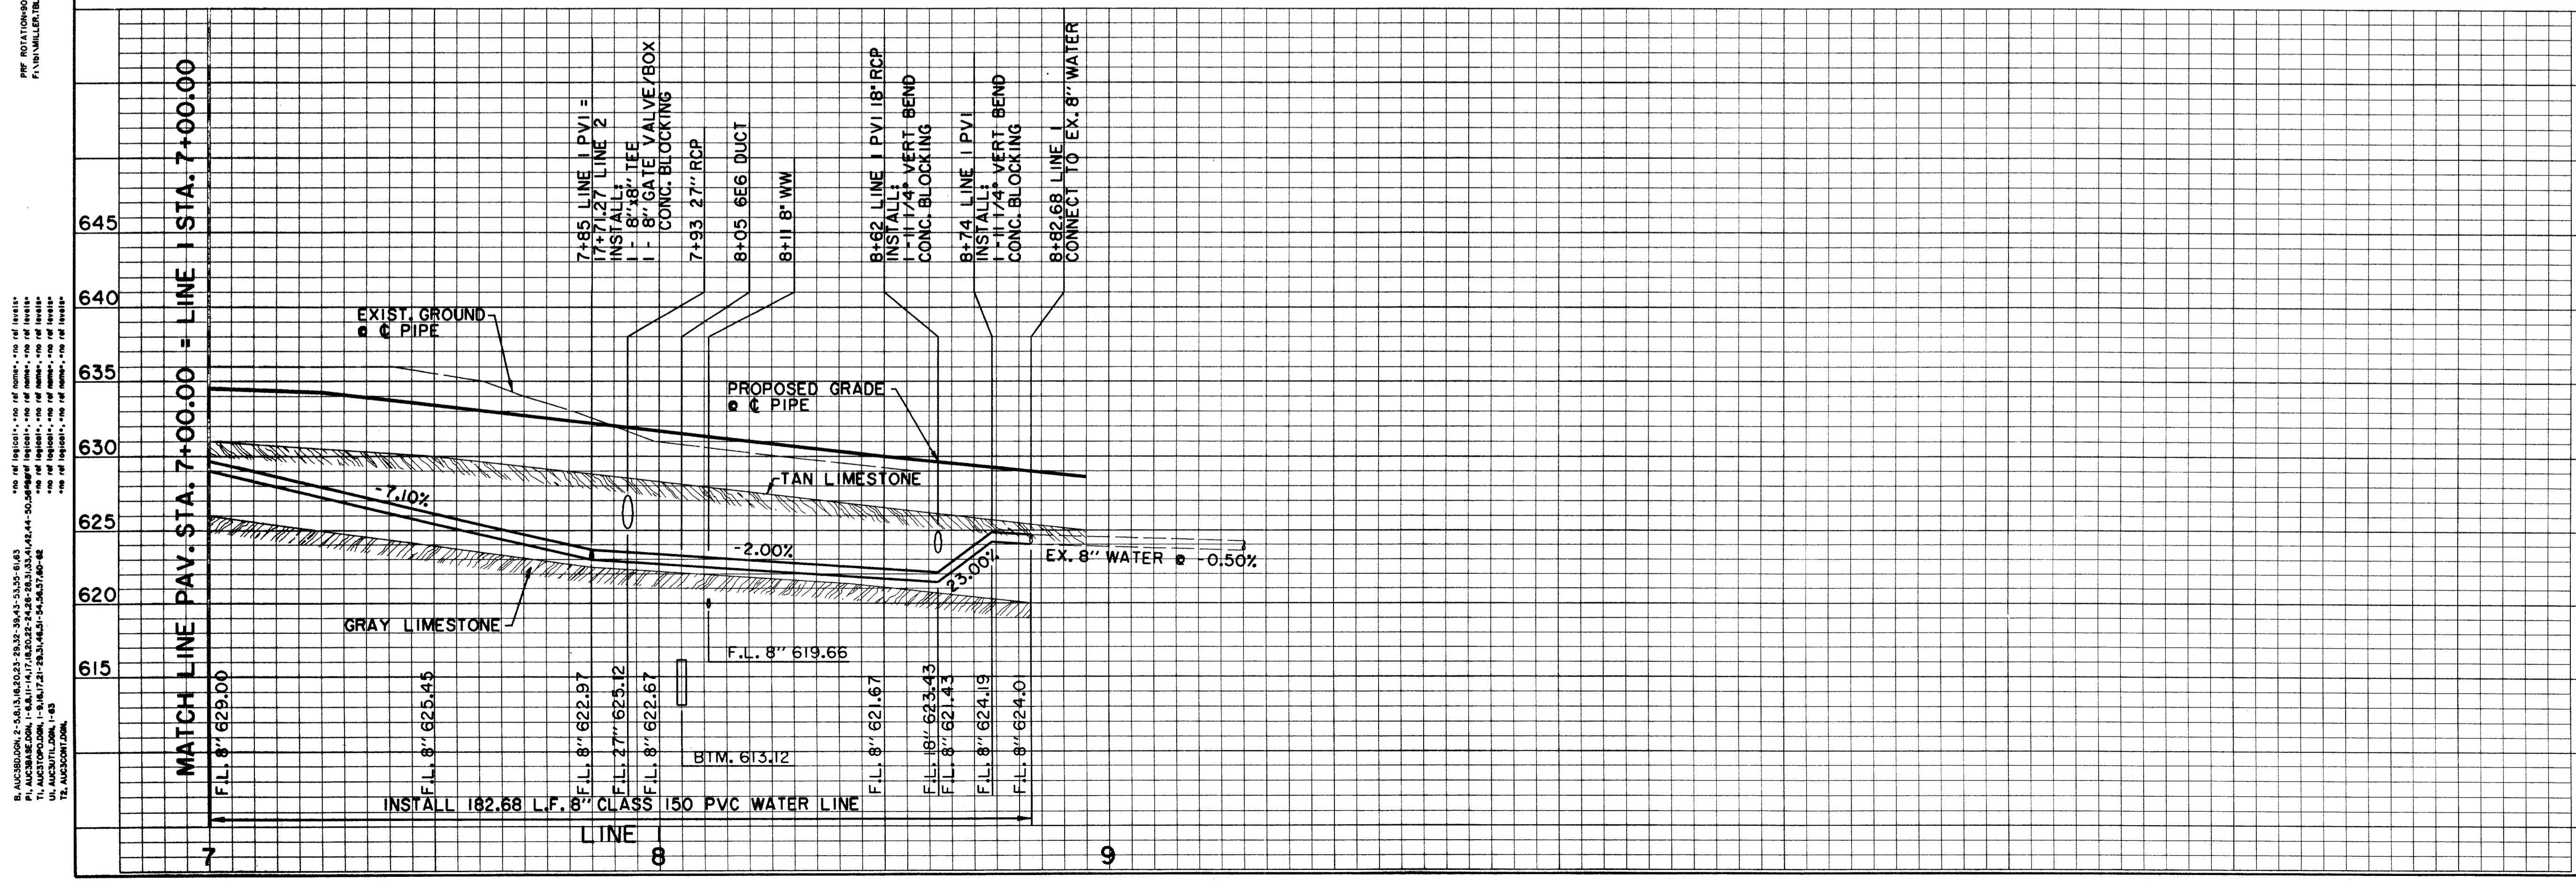



NOTE: METERS, METER BOXES, VAULT AND BACKFLOW PREVENTION ASSEMBLIES TO BE INSTALLED AND TESTED PER TOWN OF ADDISON GENERAL REQUIREMENTS.

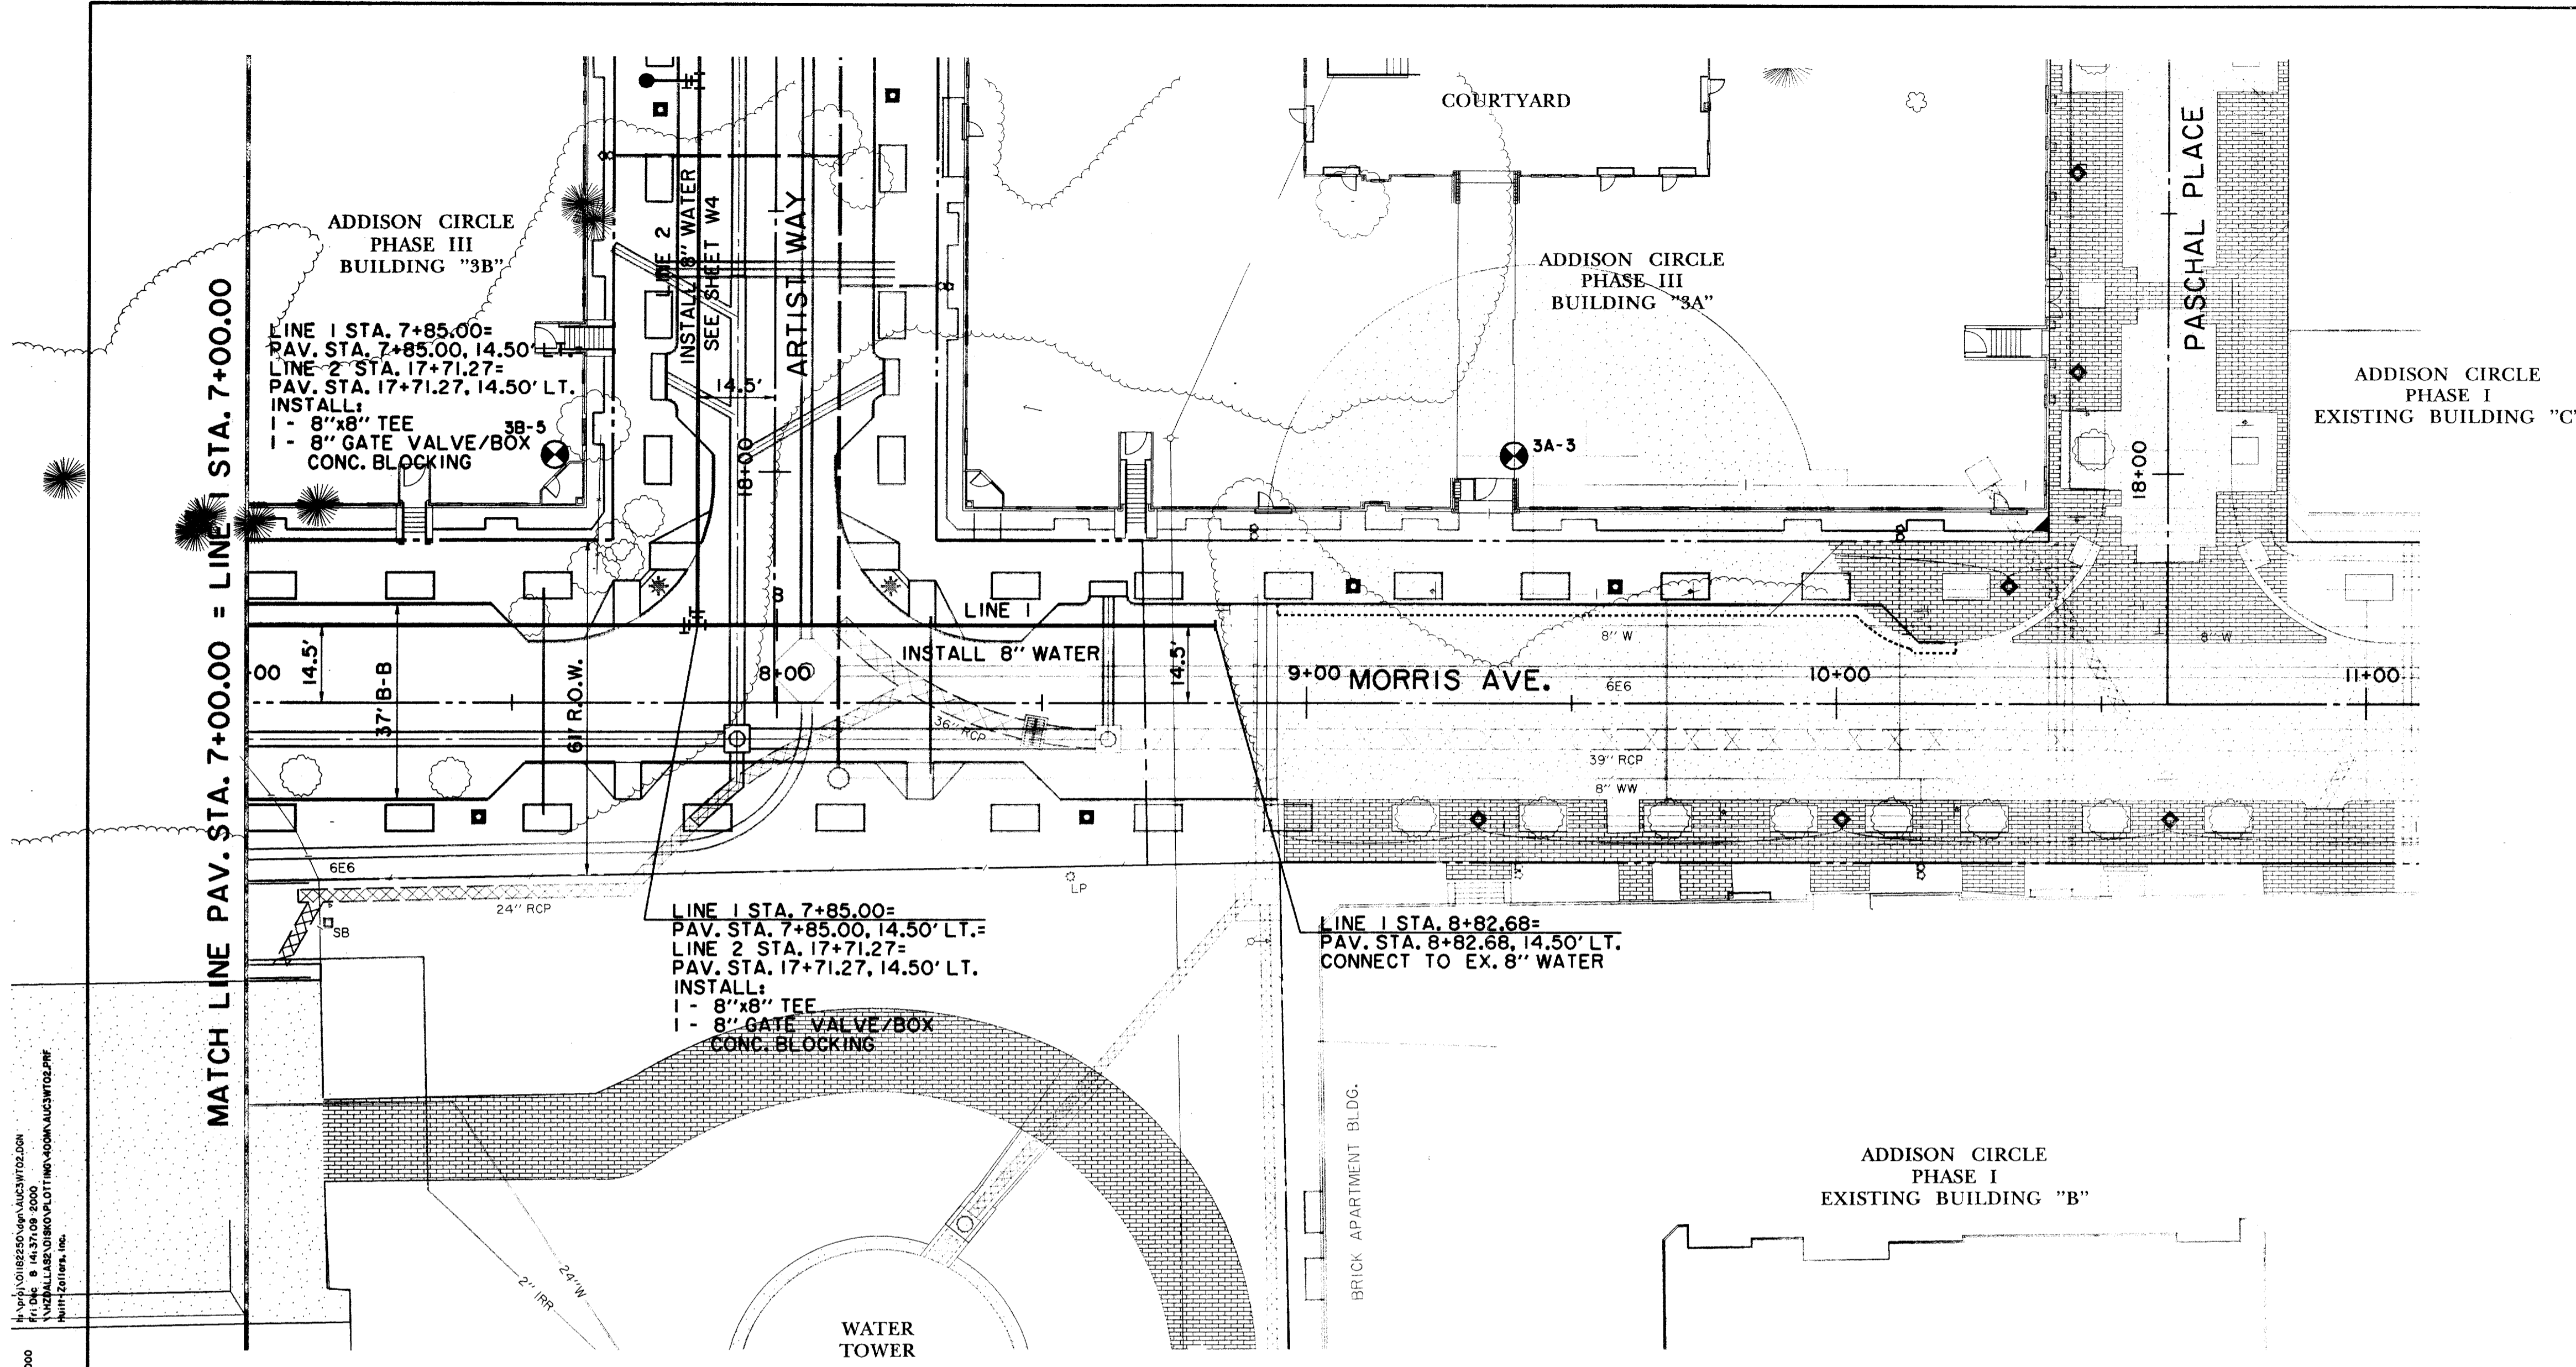

RECORD DRAWING

BENCHMARKS: BM#5 "C" CUT ON 8" INLET ON NORTH CURB LINE OF GOODMAN AVE. ±75' EAST OF PASCHAL PLACE. ELEV. 629.98 BM#6 "C" CUT AT C OF 8" INLET AT THE SOUTHWEST CORNER OF MORRIS AVE. AND WITT PLACE. ELEV. 627.29 BM#7 "C" CUT AT WEST CORNER OF ADDISON THEATRE CENTRE PARKING LOT, SECOND ENTRANCE NORTH OF ADDISON RD. ELEV. 637.66			THE SEAL APPEARING ON THIS DOCUMENT WAS AUTHORIZED BY 			
645						
640						
635						
630						
625						
620	6/23/99 ISSUED FOR CONSTRUCTION	N/A				
	5/17/99 ISSUED FOR BID	N/A				
615	WATER PLAN & PROFILE LINE 1 - MORRIS AVE. ADDISON CIRCLE PHASE II-B PUBLIC INFRASTRUCTURE TOWN OF ADDISON, TEXAS					
<small>HUTT Zoltgras, Inc. 3131 McKinney Ave., Suite 600, Dallas, TX 75204 Phone (214) 871-3311/Fax (214) 871-0757</small>						
DESIGN	DRAWN	APPR.	SCALE	DATE	PROJECT NO.	NO.
HZI	HZI	DEM	H: 1"=20' V: 1"=6'	MAR. 99	01-1822-50	W3

1. 10/11/2008 2:54:13 PM 182250.dwg
 2. 10/11/2008 2:54:13 PM 182250.dwg
 3. 10/11/2008 2:54:13 PM 182250.dwg
