


ADDISON ROAD

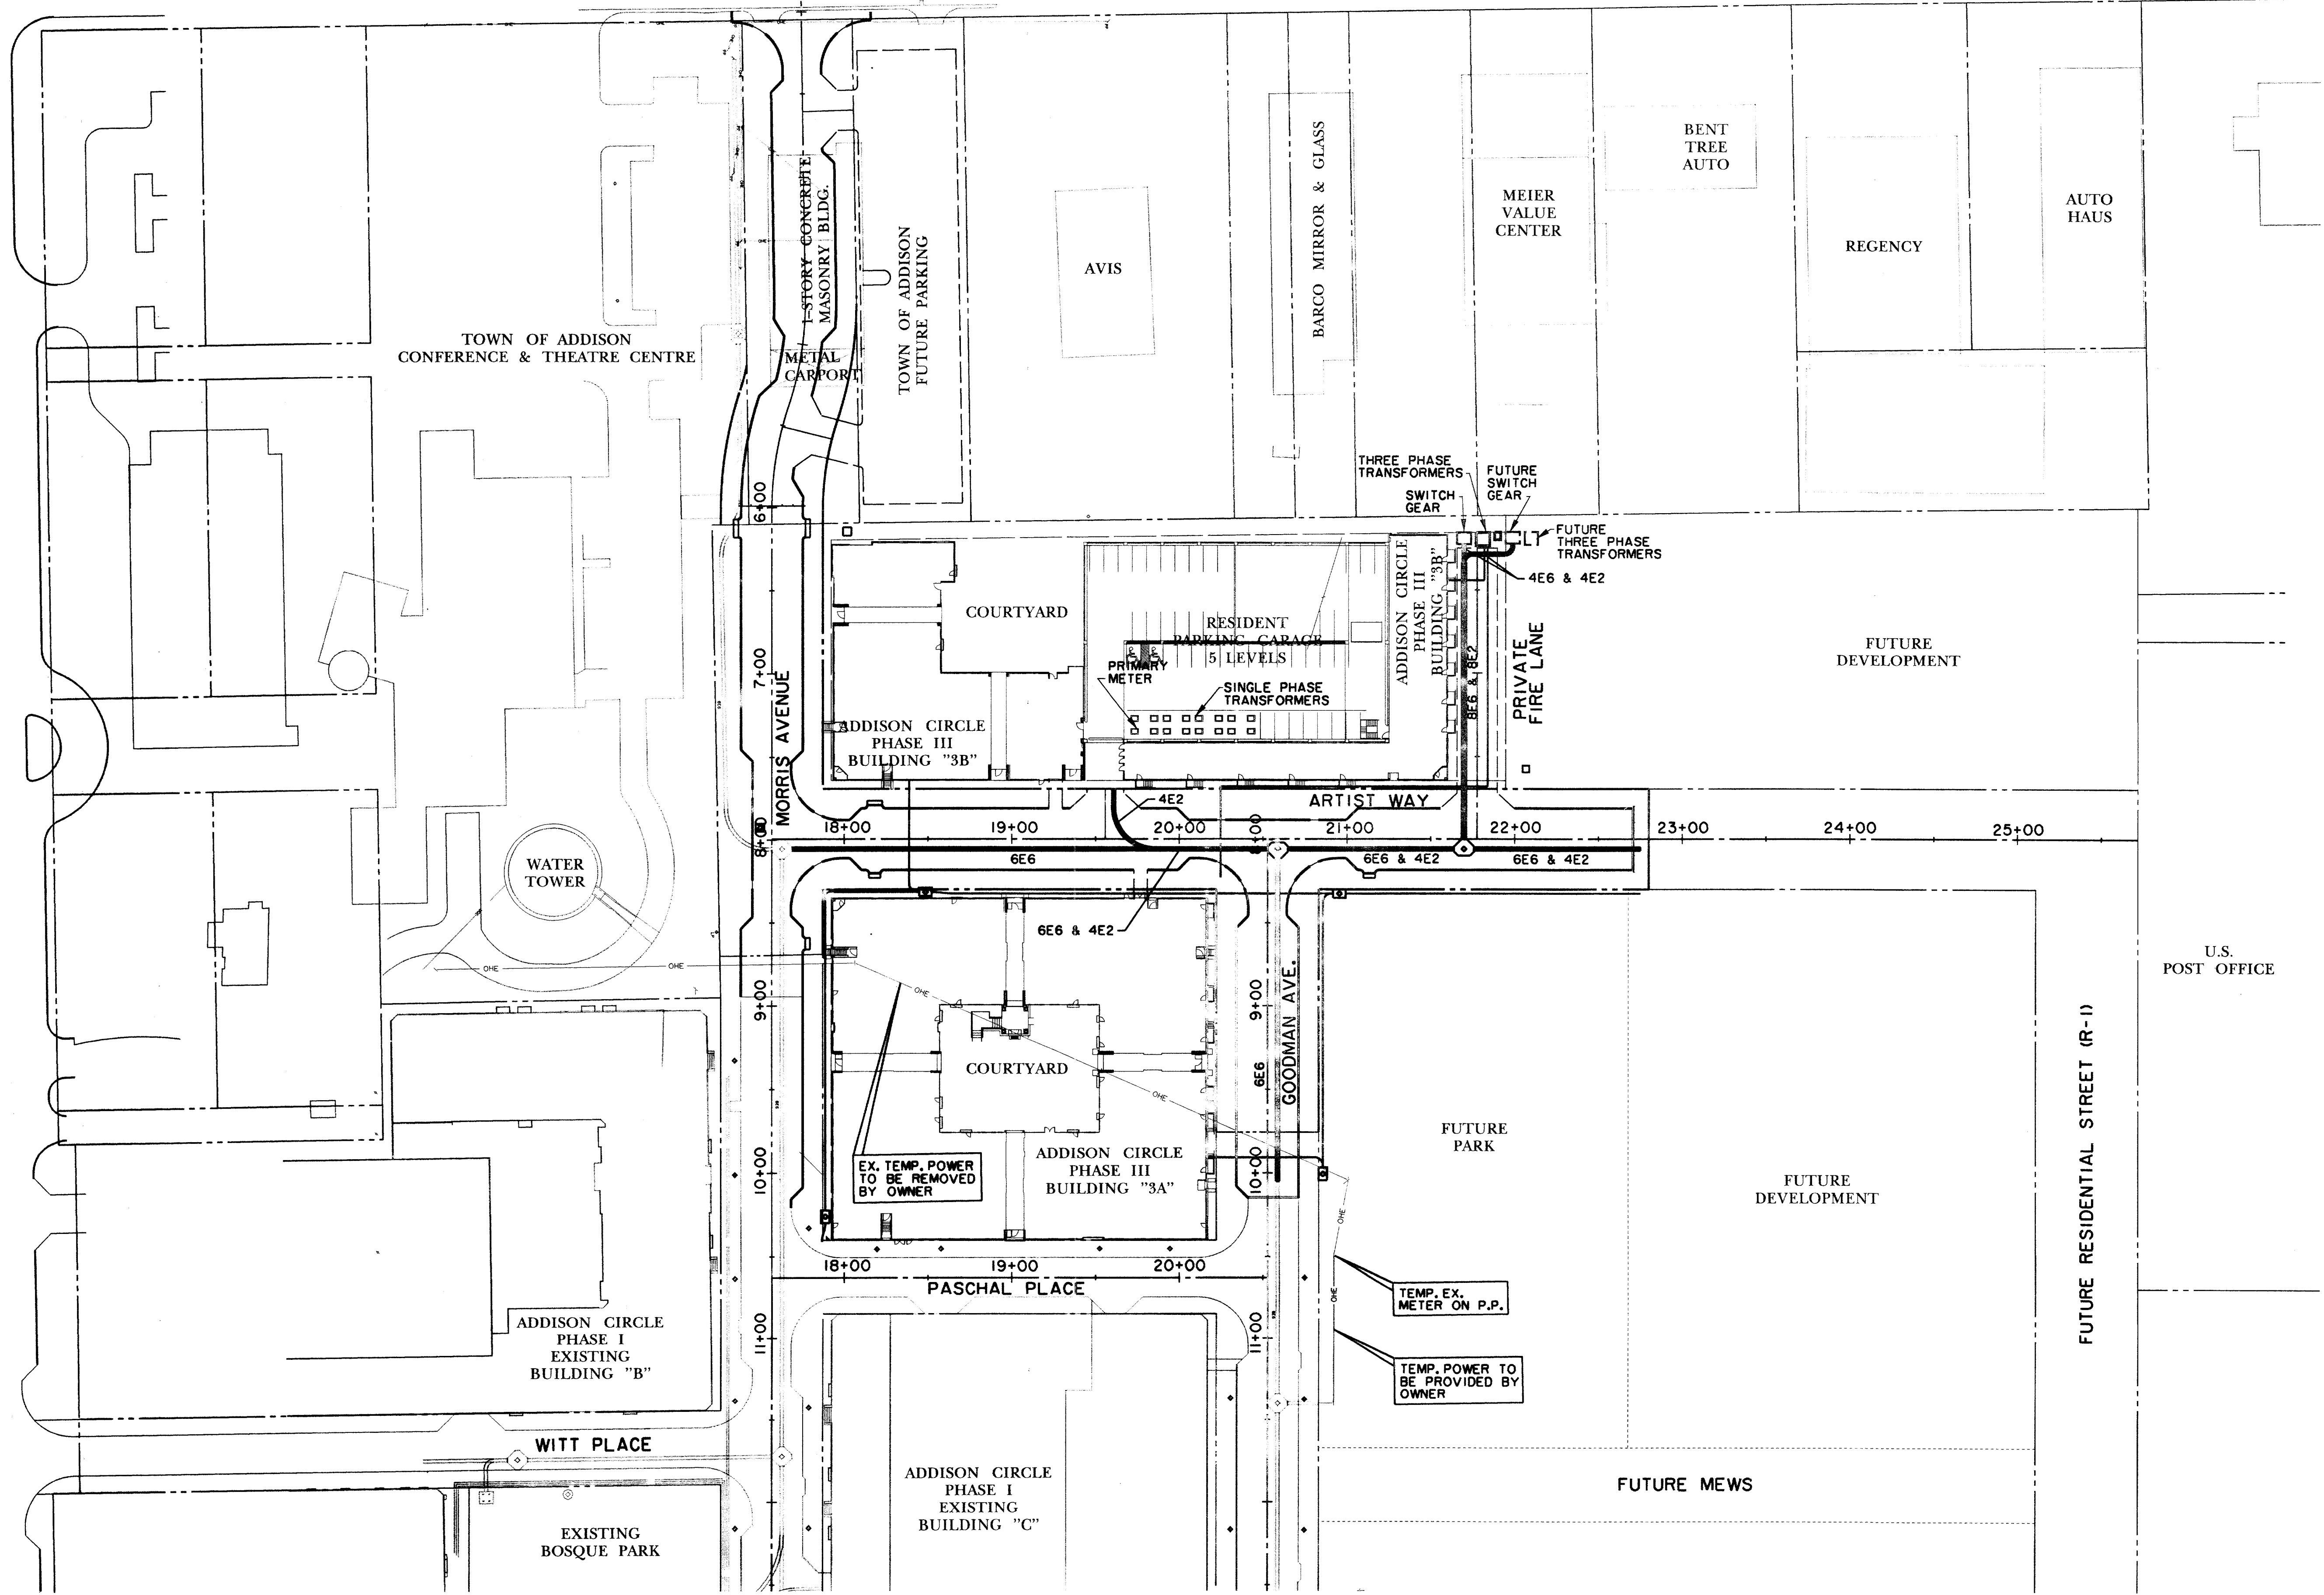

RECORD  
DRAWING

**BENCHMARKS:**

BM#5  
"I" CUT ON 8' INLET ON NORTH CURB LINE OF GOODMAN AVE. 175' EAST OF PASCHAL PLACE. ELEV. 629.98

BM#6  
"I" CUT AT C OF 8' INLET AT THE SOUTHWEST CORNER OF MORRIS AVE. AND WITT PLACE. ELEV. 627.29

BM#7  
"I" CUT AT WEST CORNER OF ADDISON THEATRE CENTRE PARKING LOT, SECOND ENTRANCE NORTH OF ADDISON RD. ELEV. 637.66

THE SEAL APPEARING ON THIS DOCUMENT WAS AUTHORIZED BY DAVID E. MEYERS, P.E. 81512

DATE	DESCRIPTION	REF NO.
6/23/99	ISSUED FOR CONSTRUCTION	N/A
5/17/99	ISSUED FOR BID	N/A

**ELECTRICAL SITE PLAN**

**ADDISON CIRCLE**

**PHASE II-B PUBLIC INFRASTRUCTURE**

**TOWN OF ADDISON, TEXAS**

Huff - Zolgers, Inc.  
3131 McKinney Ave., Suite 600, Dallas, TX 75204  
Phone (214) 871-3311/Fax (214) 871-0757

DESIGN	DRAWN	APPR.	SCALE	DATE	PROJECT NO.	NO.
HZI	HZI	DEM	1"=50'	MAR. 99	01-1822-50	EI

P:\PROJECTS\182250\ADDISON\ADDISON.DWG  
 PLOT DATE: 3/18/99 10:00 AM  
 PLOT SCALE: 1"=50'  
 PLOT SIZE: 11.00 x 17.00  
 PLOT ORIGIN: 10.00, 10.00  
 PLOT END: 27.00, 27.00  
 PLOT TITLE: ELECTRICAL SITE PLAN  
 PLOT BY: HZI  
 PLOT CHECKED: DEM  
 PLOT APPROVED: HZI  
 PLOT DATE: 3/18/99 10:00 AM