

THIS PLAN ILLUSTRATES THE TOTAL AREA OF EXISTING PAVEMENT AND THE LOCATIONS OF EXISTING STORM DRAINAGE FACILITIES TO BE REMOVED. THESE ELEMENTS WILL REQUIRE REMOVAL INCREMENTALLY AS NECESSARY FOR PROPER STAGING AND SEQUENCING OF CONSTRUCTION AND MAY THEREFORE REQUIRE ADDITIONAL SAW CUTTING THAN WHAT IS INDICATED.

**NOT IN CONTRACT**

ADDISON ROAD

TOWN OF ADDISON CONFERENCE & THEATRE CENTRE

EXISTING IRRIGATION IN THIS AREA TO BE MODIFIED. (SEE IRRIGATION PLANS)

REMOVE EX. SHRUBS; HOLD AND REPLANT AT TOWN OF ADDISON DIRECTION

REMOVE EX. CONC. PVM'T. (TYP.)

RELOCATE EX. PORTABLE BLDG. AT TOWN OF ADDISON DIRECTION

REMOVE EX. CONC. PVM'T. UNDER THIS CONTRACT

REMOVE, SALVAGE AND RESET EXIST. FENCE. COORDINATE WITH TOWN OF ADDISON

WATER TOWER

SAWED BLOCKOUT GROOVE (TYP.)

ADDISON CIRCLE PHASE I EXISTING BUILDING "B"

WITT PLACE

EXISTING BOSQUE PARK

SAWED BLOCKOUT GROOVE (TYP.)

TOWN OF ADDISON FUTURE PARKING

MORRIS AVENUE

ADDISON CIRCLE PHASE III BUILDING "3B"

REMOVE EX. INLET (TYP.)

REMOVE EX. GUARD RAIL

REMOVE EX. CONC. PVM'T. (TYP.) COURTYARD

REMOVE EX. PIPE TO PROPERTY LINE REMOVE EX. INLET (TYP.)

ADDISON CIRCLE PHASE III BUILDING "3A"

PASCHAL PLACE

ADDISON CIRCLE PHASE I EXISTING BUILDING "C"

AVIS

REMOVE EX. SHRUBS UNDER THIS CONTRACT HOLD AND REPLANT AT TOWN OF ADDISON DIRECTION

COURTYARD

RESIDENT PARKING GARAGE 5 LEVELS

GOODMAN AVE.

REMOVE EX. GUARD RAIL

FUTURE MEWS

BARCO MIRROR & GLASS

MEIER VALUE CENTER

BENT TREE AUTO

REGENCY

AUTO HAUS

ADDISON CIRCLE PHASE III BUILDING "3B"

PRIVATE FIRE LANE

FUTURE DEVELOPMENT

ARTIST WAY

CLEAR EXISTING TREES WITHIN RIGHT-OF-WAY AND DISPOSE OF OFF-SITE

FUTURE PARK

FUTURE DEVELOPMENT

U.S. POST OFFICE

FUTURE RESIDENTIAL STREET (R-1)

**LEGEND**


CONCRETE REMOVAL

PIPE REMOVAL

INLET REMOVAL

**RECORD DRAWING**

THE SEAL APPEARING ON THIS DOCUMENT WAS AUTHORIZED BY DAVID E. MEYERS, P.E. 81512

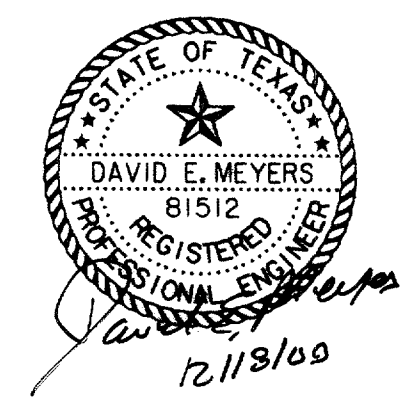

DATE	DESCRIPTION	REF NO.
6/23/99	ISSUED FOR CONSTRUCTION	N/A
5/17/99	ISSUED FOR BID	N/A

DEMOLITION PLAN						
ADDISON CIRCLE						
PHASE II-B PUBLIC INFRASTRUCTURE						
TOWN OF ADDISON, TEXAS						
<small>Hull = 201109, Inc. 3131 McKinney Ave., Suite 600, Dallas, TX 75204 Phone (214) 871-3311 / Fax (214) 871-0757</small>						
DESIGN	DRAWN	APPR.	SCALE	DATE	PROJECT NO.	NO.
HZI	HZI	DEM	1"=50'	MAR. 99	01-1822-50	<b>P4</b>

W:\PROJ\182250\AUC3DEM.DGN  
 P:\182250\182250.DWG  
 11/13/08

"no of inlets", "no of manholes", "no of trees"  
 "no of inlets", "no of manholes", "no of trees"  
T:\AUC3DEM.DGN  
 U:\AUC3DEM.DGN  
 P:\AUC3DEM.DGN  
 11/13/08