

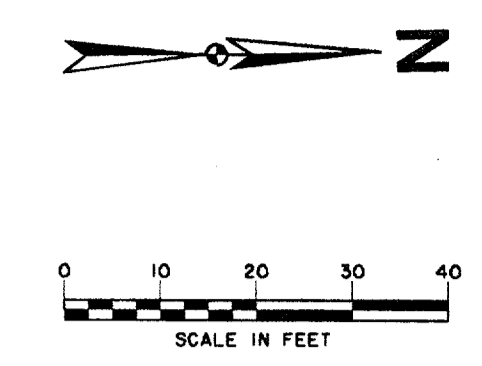


PROJECT NO. 01182250\AUC3PV03.DWG
DATE: 01/18/99
DRAWN BY: HZI
CHECKED BY: DEM
SCALE: 1"=20'
TOWN OF ADDISON, TEXAS

NO. OF STATIONS: 11
NO. OF POINTS: 11
NO. OF BEAMS: 11
NO. OF SLOPES: 3
NO. OF VERTICAL CURVES: 2
NO. OF TRANSITIONS: 2
NO. OF MATCH LINES: 2

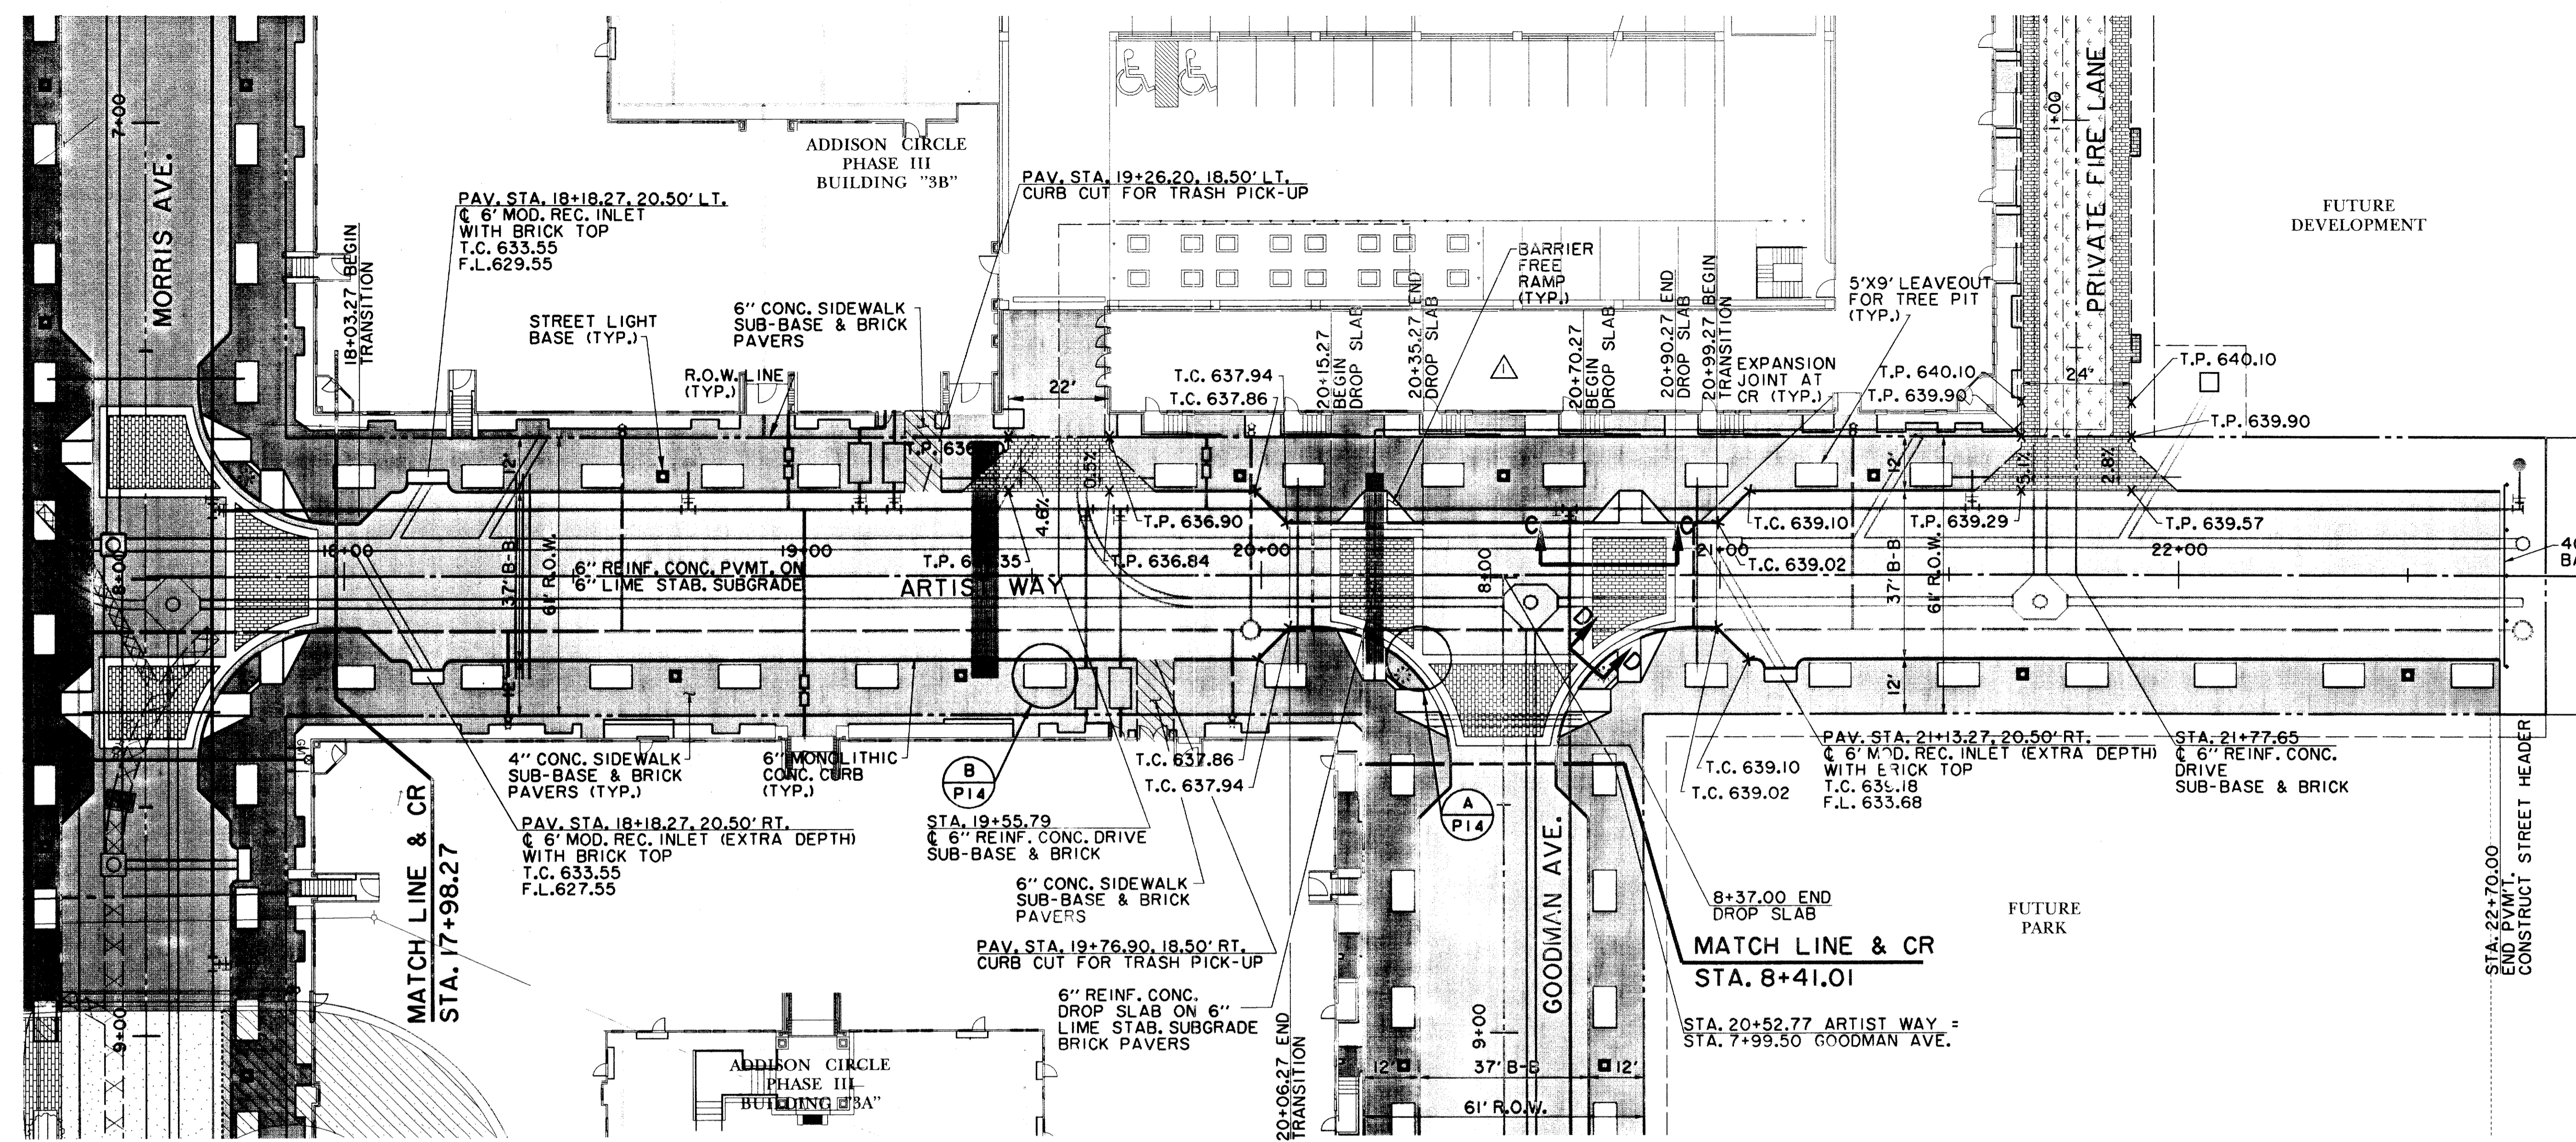

RECORD DRAWING

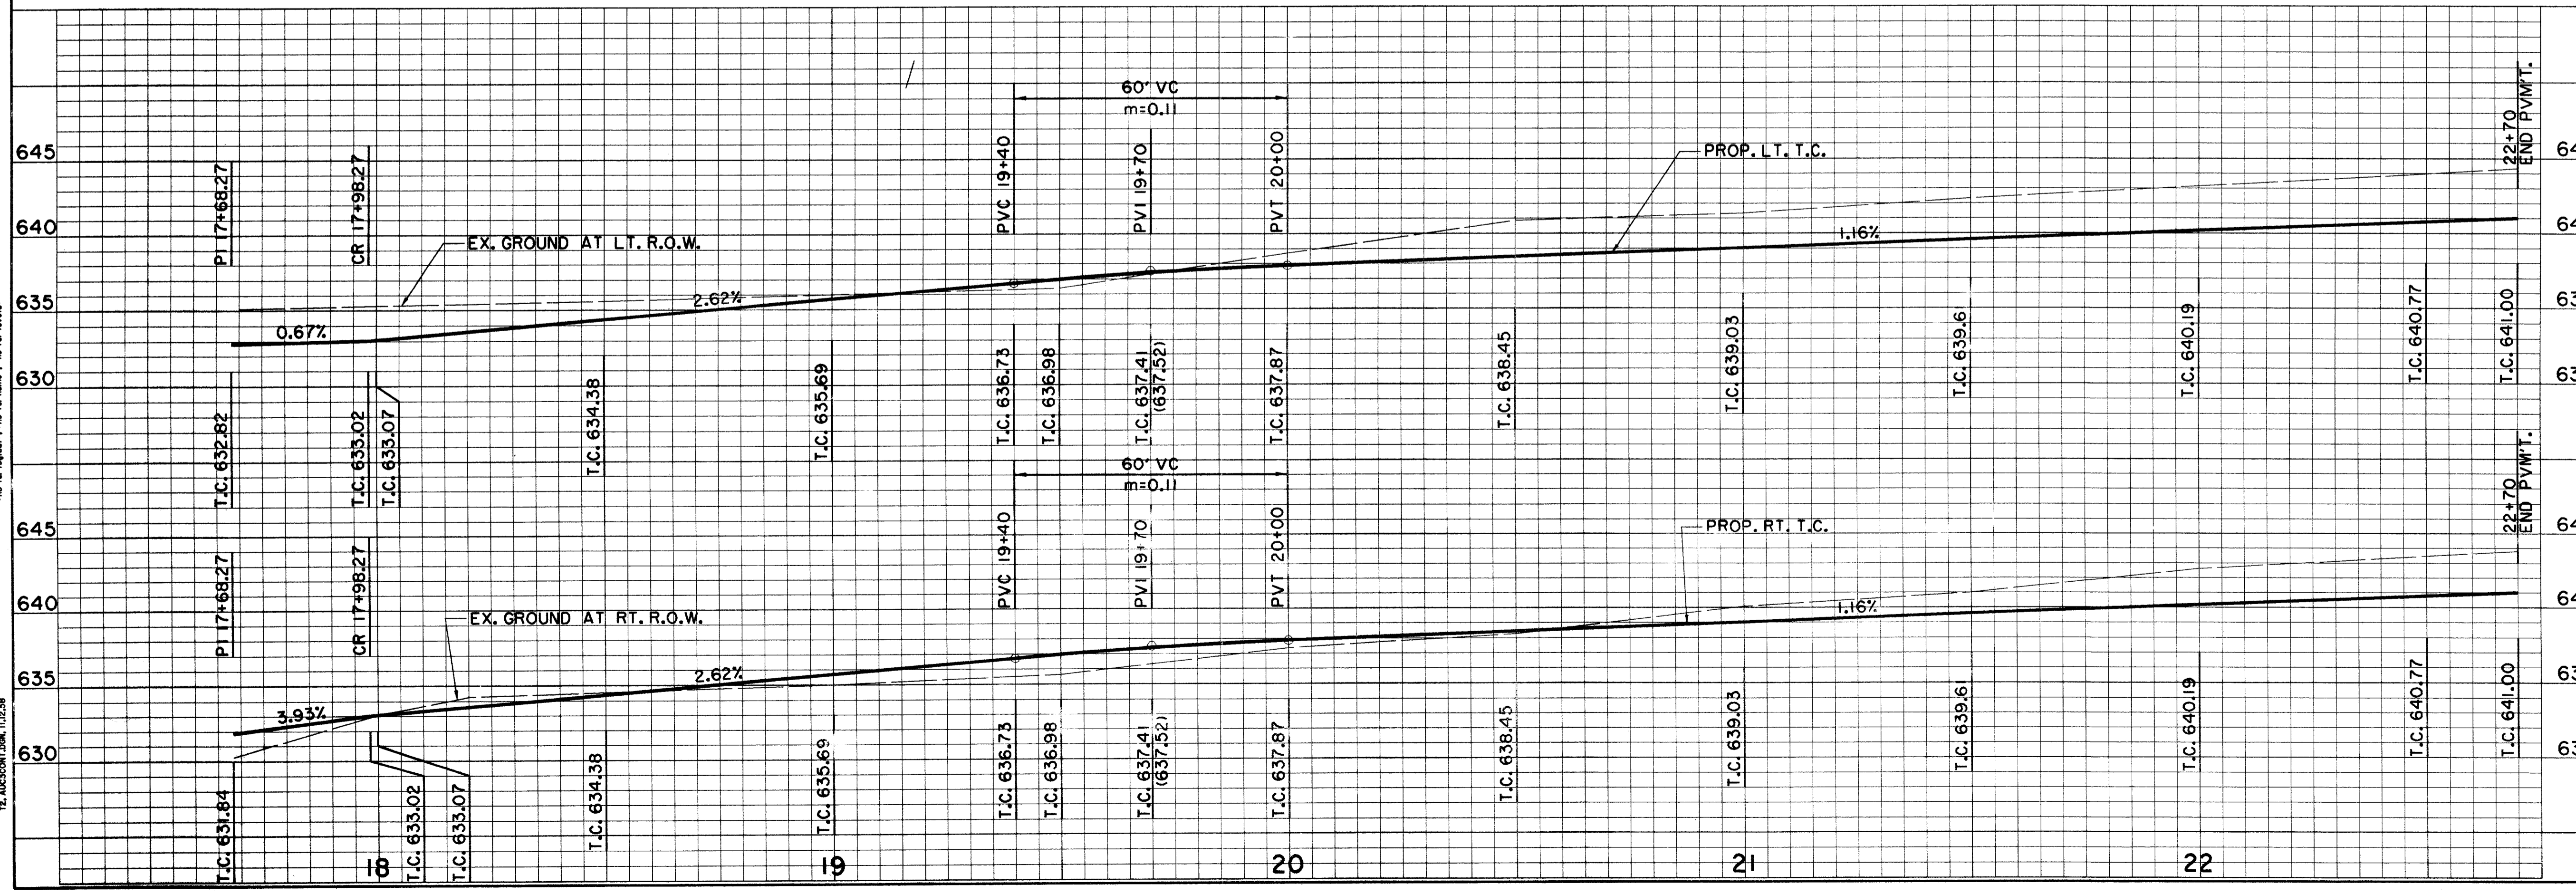

BENCHMARKS:		
BM#5 1" CUT ON 8" INLET ON NORTH CURB LINE OF GOODMAN AVE. ±75' EAST OF PASCHAL PLACE. ELEV. 629.98		
BM#6 1" CUT AT C/O OF 8" INLET AT THE SOUTHWEST CORNER OF MORRIS AVE. AND WITT PLACE. ELEV. 627.29		
BM#7 1" CUT AT WEST CORNER OF ADDISON THEATRE CENTRE PARKING LOT, SECOND ENTRANCE NORTH OF ADDISON RD. ELEV. 637.66		
DATE	DESCRIPTION	REF. NO.
6/23/99	ISSUED FOR CONSTRUCTION	N/A
6/2/99	ADDENDUM #1	▲
5/17/99	ISSUED FOR BID	N/A
PAVING PLAN & PROFILE ARTIST WAY STA. 17+98.27 TO STA. 22+70.00		
ADDISON CIRCLE		
PHASE II-B PUBLIC INFRASTRUCTURE		
TOWN OF ADDISON, TEXAS		
HUI - 20118250, Inc. 3131 McKinney Ave., Suite 600, Dallas, TX 75204 Phone (214) 871-3311/Fax (214) 871-0757		
DESIGN	DRAWN	APPR.
HZI	HZI	DEM
SCALE	DATE	PROJECT NO.
H ₁ 1"=20' V ₁ 1"=6'	MAR. 99	01-1822-50
NO.		P9

THE SEAL APPEARING ON THIS DOCUMENT WAS AUTHORIZED BY DAVID E. MEYERS, P.E. 81512

DAVID E. MEYERS
REGISTERED PROFESSIONAL ENGINEER
NO. 81512
12/18/80