


RECORD DRAWING

THE SEAL APPEARING ON THIS DOCUMENT WAS AUTHORIZED BY KAREN W. KOERTH, L.A. 1594

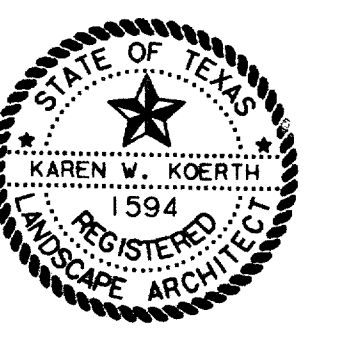

DATE	DESCRIPTION	REF. NO.
6/23/99	ISSUED FOR CONSTRUCTION	N/A
6/2/99	ADDENDUM #1	N/A
5/17/99	ISSUED FOR BID	N/A

PLANTING & FURNITURE PLAN
ARTIST WAY & GOODMAN AVE.
ADDISON CIRCLE
PHASE II-B PUBLIC INFRASTRUCTURE
TOWN OF ADDISON, TEXAS

DESIGN	DRAWN	APPR.	SCALE	DATE	PROJECT NO.	NO.
HZI	HZI	DEM	H: 1"=20' V: 1"=6'	MAR. 99	01-1822-50	PF2

1. ALL DIMENSIONS UNLESS OTHERWISE NOTED.
 2. ALL PLANTINGS TO BE INSTALLED AS SHOWN.
 3. ALL PLANTINGS TO BE INSTALLED AS SHOWN.
