




P1 5'x9' TREE WELL PLANTING
SCALE: 1/4"=1'-0"

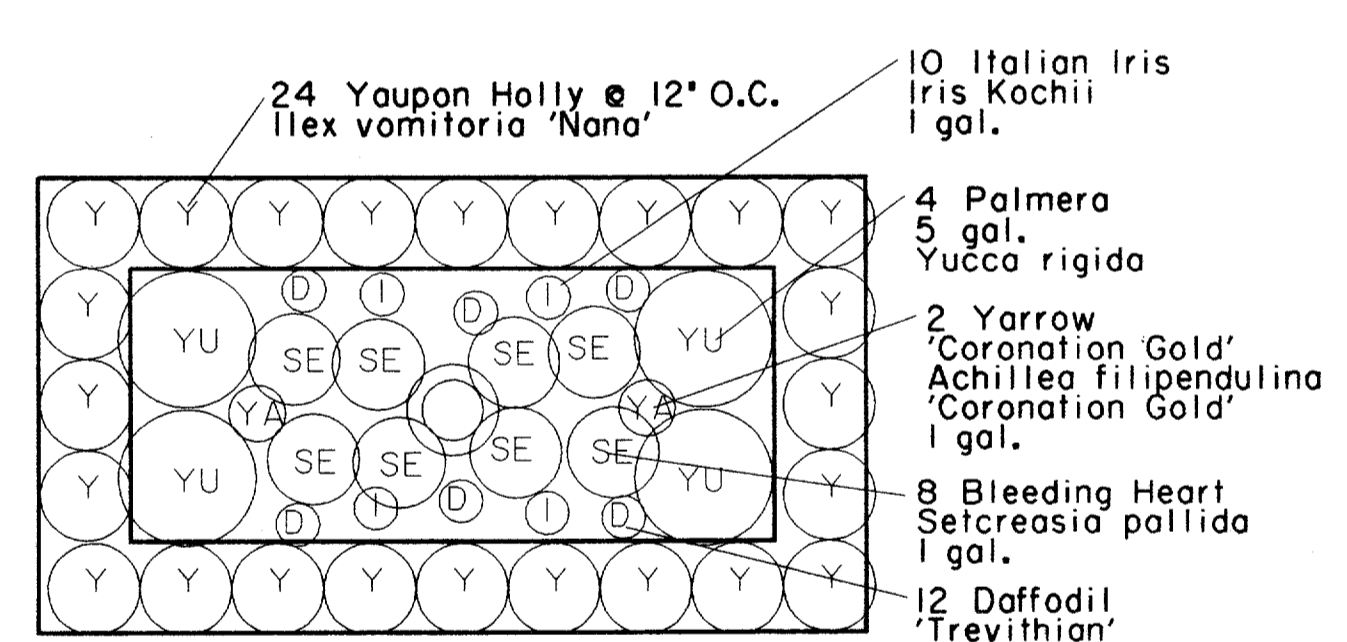


P3 5'x9' TREE WELL PLANTING
SCALE: 1/4"=1'-0"

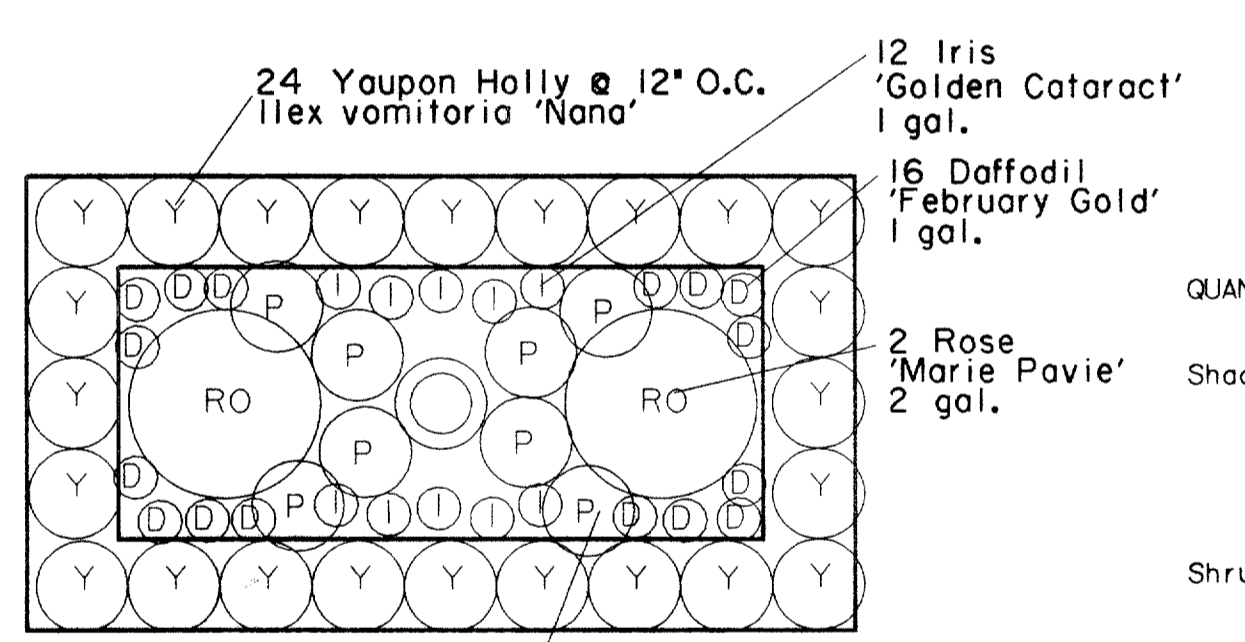

P5 5'x9' TREE WELL PLANTING
SCALE: 1/4"=1'-0"

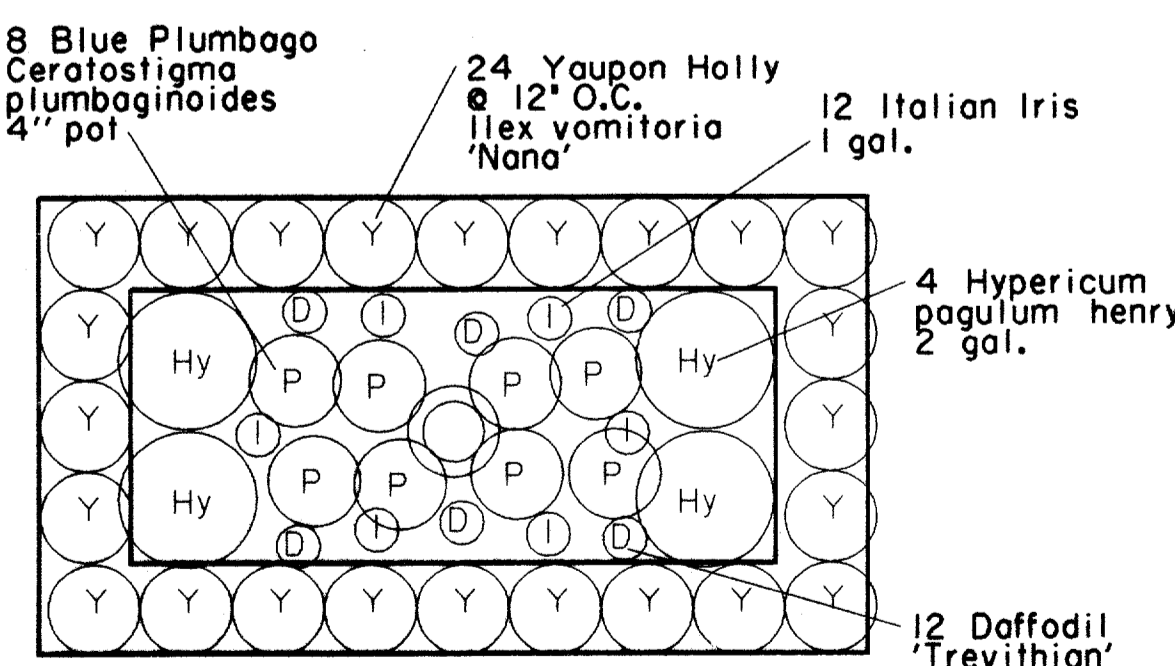

P2 5'x9' TREE WELL PLANTING
SCALE: 1/4"=1'-0"

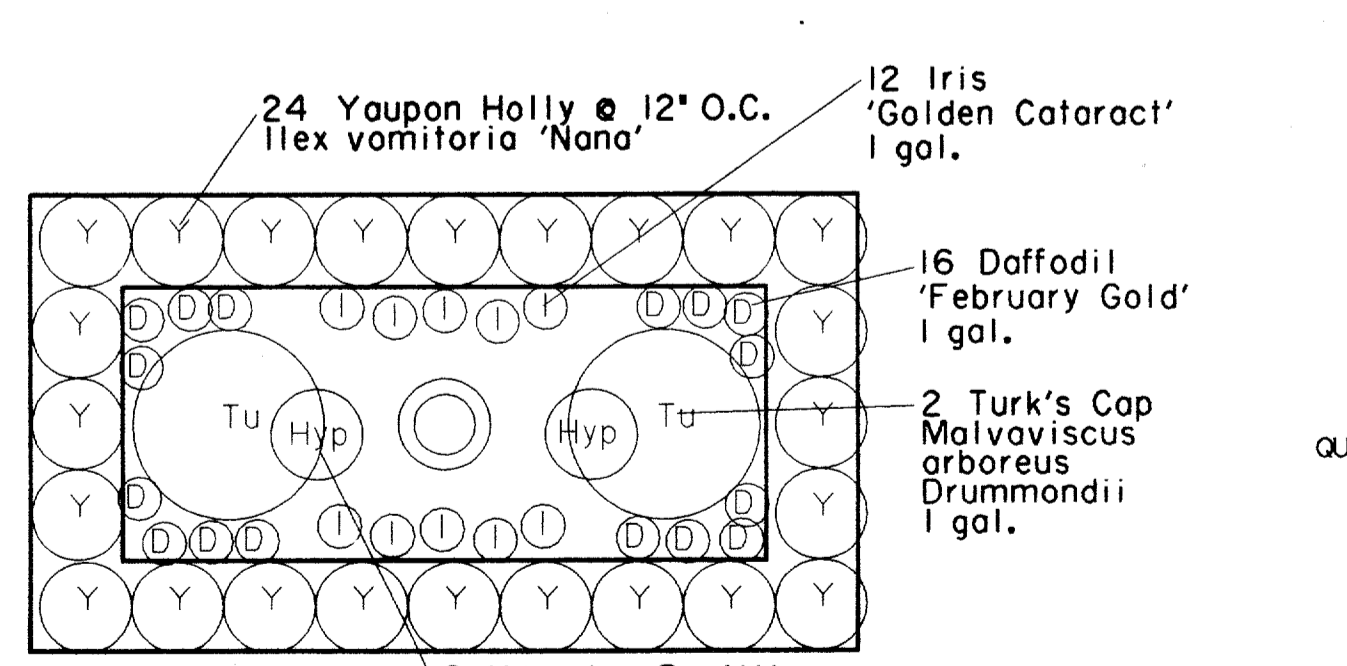

P4 5'x9' TREE WELL PLANTING
SCALE: 1/4"=1'-0"

ADDISON CIRCLE PHASE III
FURNITURE SCHEDULE


QUANTITY	ITEM	DESCRIPTION	SOURCE
21	Bench B	5' Bowery Bench CDBB-805-60-F Color: Standard Black	Canterbury International 1-800-935-7111
3	Bench C	6' Expo Bench (3 Supports) Black Gloss Finish	Robinson Iron Pat Calhoun
15	Trash Receptacle B	Utilrium Custom metal pole mount trash receptacle, 20: ht., 9" dia., Black powder coat finish	Pat Calhoun Caneline Representative: Resource Consulting Services 972-492-2428
13	Bike Rack	Bike Rib, Model BR2-3 (imbedded) Black Powder Coat Finish	Function First Bike Security 602-322-9626

ADDISON CIRCLE PHASE II-B
PLANT LIST

QUANTITY	COMMON NAME	BOTANICAL NAME	SIZE/REMARKS
Shade Trees			
38	Live Oak	Quercus virginiana	200 GAL., 5"-6" C
26	Bald Cypress	Taxodium distichum	200 GAL., 5"-6" CA
Shrubs			
1224	Dwarf Yaupon Holly	Ilex vomitoria 'nana'	1 GAL., 8"-10" H
44	Hypericum	Hypericum pagulum 'henryi'	2 GAL., 14"-18" HT
36	Rose 'Marie Pavie'	Rosa sp., Marie Pavie'	2-GAL., 12"-14" HT
34	Dallas' Rosemary	Rosmarinus officinalis 'Dallas'	3 gal., 18"-24" H
Perennials/Ground Cover			
18	Yarrow 'Coronation Gold'	Achillea filipendulina 'Coronation Gold'	1-GAL-FULL
232	Blue Plumbago	Ceratostigma plumbaginoides	4" POT-FULL
2248	sf. Common Bermuda	Cynodon dactylon	SOD
18	Hyperion Daylily	Hemerocallis 'Hyperion'	1-GAL-FULL
204	Houttuynia	Houttuynia cordata 'variagata'	4" POT-FULL
204	Iris 'Madonna'	Iris albicans 'Madonna'	1-GAL-FULL
222	Italian Iris	Iris kochii	1-GAL-FULL
324	Iris 'Golden Cataract'	Iris kochii 'Golden Cataract'	1-GAL-FULL
18	Turk's Cap	Malvaviscus arboreus Drummondii	1-GAL-FULL
432	Daffodil 'February Gold'	Narcissus x 'February Gold'	1-GAL-FULL
204	Daffodil 'Grand Primo'	Narcissus x 'Grand Primo'	1-GAL-FULL
240	Daffodil Trevithian	Narcissus x 'Trevithian'	1-GAL-FULL
72	Bleeding Heart	Setcreasea pallida	1-GAL-FULL
36	Palmera	Yucca rigida	5-GAL., 12"-14" HT., 8"-10" SPREAD

RECORD DRAWING

THE SEAL APPEARING ON THIS DOCUMENT WAS AUTHORIZED BY KAREN W. KOERTH, L.A. 1594

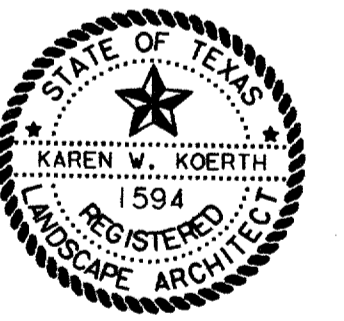

DATE	DESCRIPTION	REF NO.
6/23/99	ISSUED FOR CONSTRUCTION	N/A
6/2/99	ADDENDUM #1	▲
5/17/99	ISSUED FOR BID	N/A

PLANTING & FURNITURE PLAN - DETAILS
PASCHAL PLACE

ADDISON CIRCLE
PHASE II-B PUBLIC INFRASTRUCTURE
TOWN OF ADDISON, TEXAS

3131 McKinney Ave., Suite 600, Dallas, TX 75204
Phone (214) 871-3311/Fax (214) 871-0757

DESIGN	DRAWN	APPR.	SCALE	DATE	PROJECT NO.	NO.
HZI	HZI	DEM	1"=20'	MAR. 99	01-1822-50	PF3

P:\99\01182250\AUG31\01\AUG31.DWG
 PLOT DATE: 03/03/2000 10:00:00 AM
 PLOT SCALE: 1/4"=1'-0"
 PLOT SHEET: 1 OF 1
 PLOT BY: HZI
 PLOT FOR: HZI