



SUBSURFACE DRAIN SYSTEM DETAIL (SECTION PARALLEL TO CURB) N.T.S.

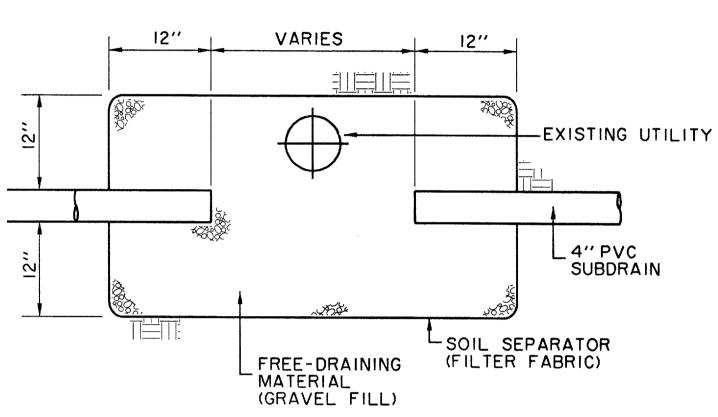

INSTALLATION OF SUBDRAIN AT UTILITY CONFLICT N.T.S.


## DRILL HOLE IN CONC. INLET BOX & GROUT PVC SUBDRAIN PIPE IF A SECTION OF PVC HAS NOT BEEN CAST INLET BOX WITH BOX. 4" PVC SUBDRAIN PIPE 1.5 CU FT CONCRETE PVC SUBDRAIN PIPE CONNECTION TO INLET BOX

N.T.S.

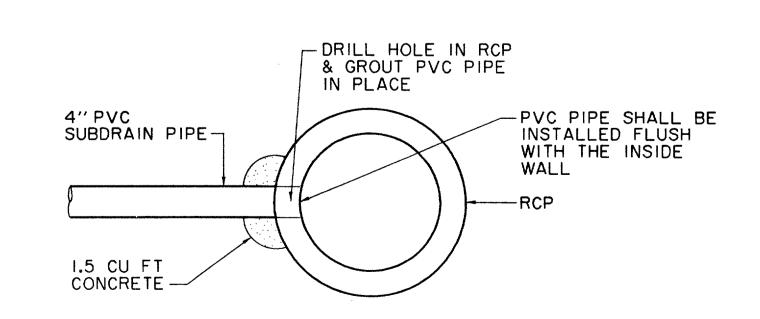

PVC SUBDRAIN PIPE CONNECTION TO STORM DRAINAGE PIPE N.T.S.

## RECORD DRAWING

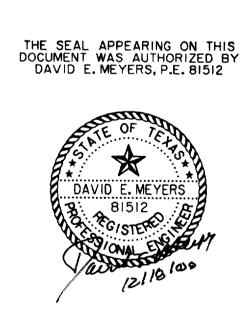

DATE	DESCRIPTION	REF NO.
· · · · · · · · · · · · · · · · · · ·		
6/23/99	ISSUED FOR CONSTRUCTION	N/A
5/17/99	ISSUED FOR BID	N/A

## SUDDITAIN DETAILS

## ADDISON CIRCLE

PHASE II-B PUBLIC INFRASTRUCTURE TOWN OF ADDISON, TEXAS

Huitt - Zollars, Inc. 3131 Mckinney Ave., Suite 600, Dallas, TX 75204 Phone (214) 871-3311/Fax (214) 871-0757

DRAWN APPR. SCALE DATE PROJECT NO. DESIGN N.T.S. MAR. 99 01-1822-50 ST6 HZI DEM

h:\proj\01182250\dgn\AUC3TY06.DGN