



B:\PROJECTS\10182250\DWG\AUG3D067.DWG  
 Title Block & Information  
 P:\M\WLL\B.L. TEL. # 972.781.3000  
 HAILI - ZOLLARS, INC.

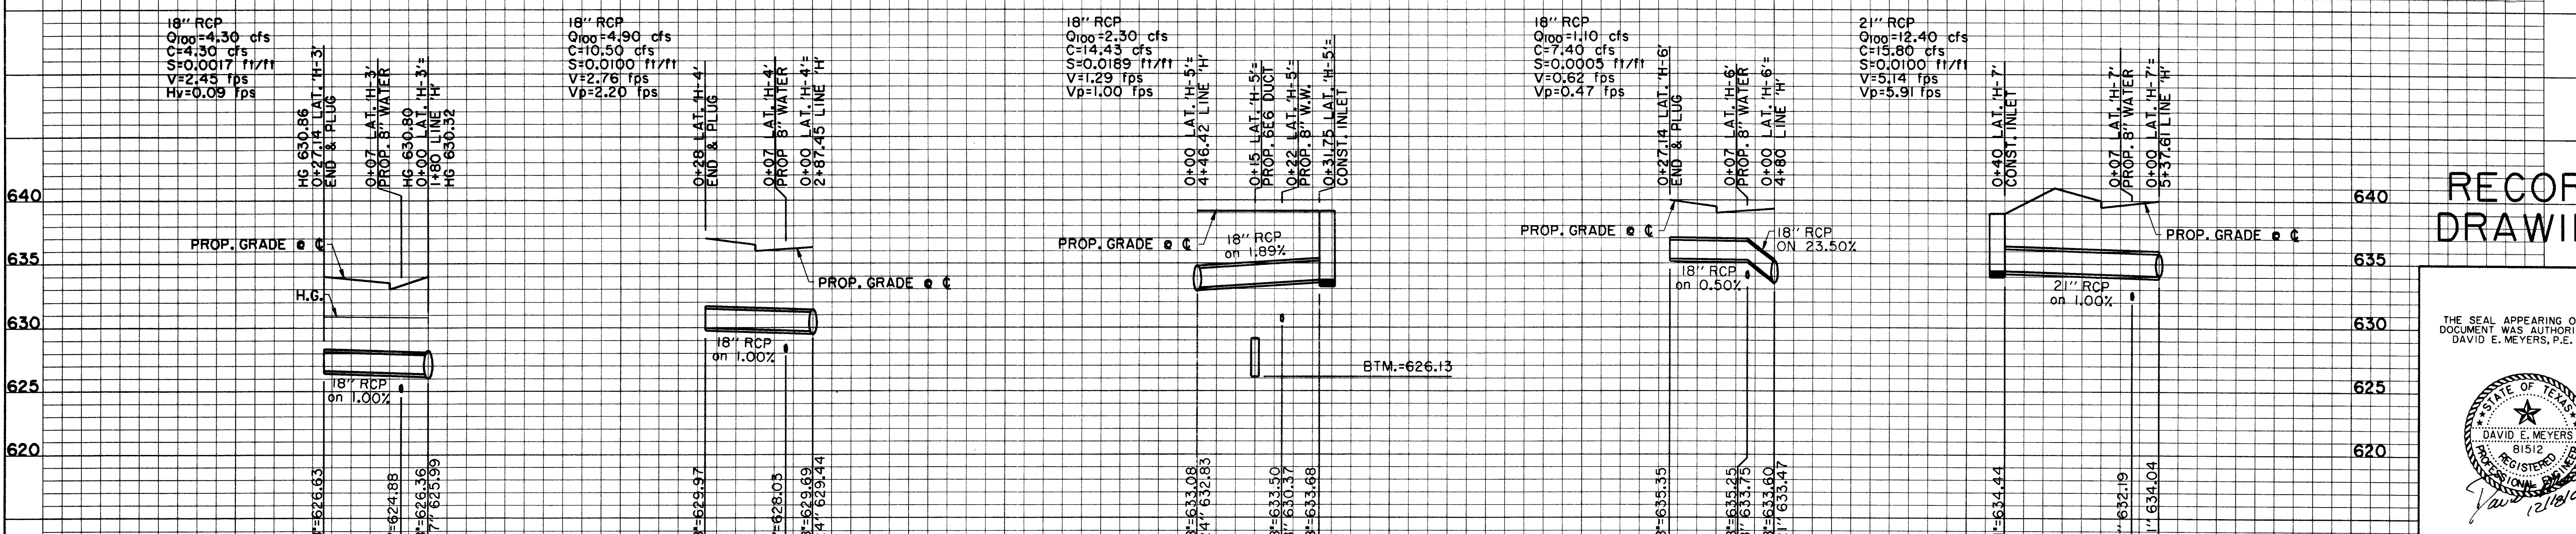

# RECORD DRAWING

THE SEAL APPEARING ON THIS DOCUMENT WAS AUTHORIZED BY DAVID E. MEYERS, P.E. 81512

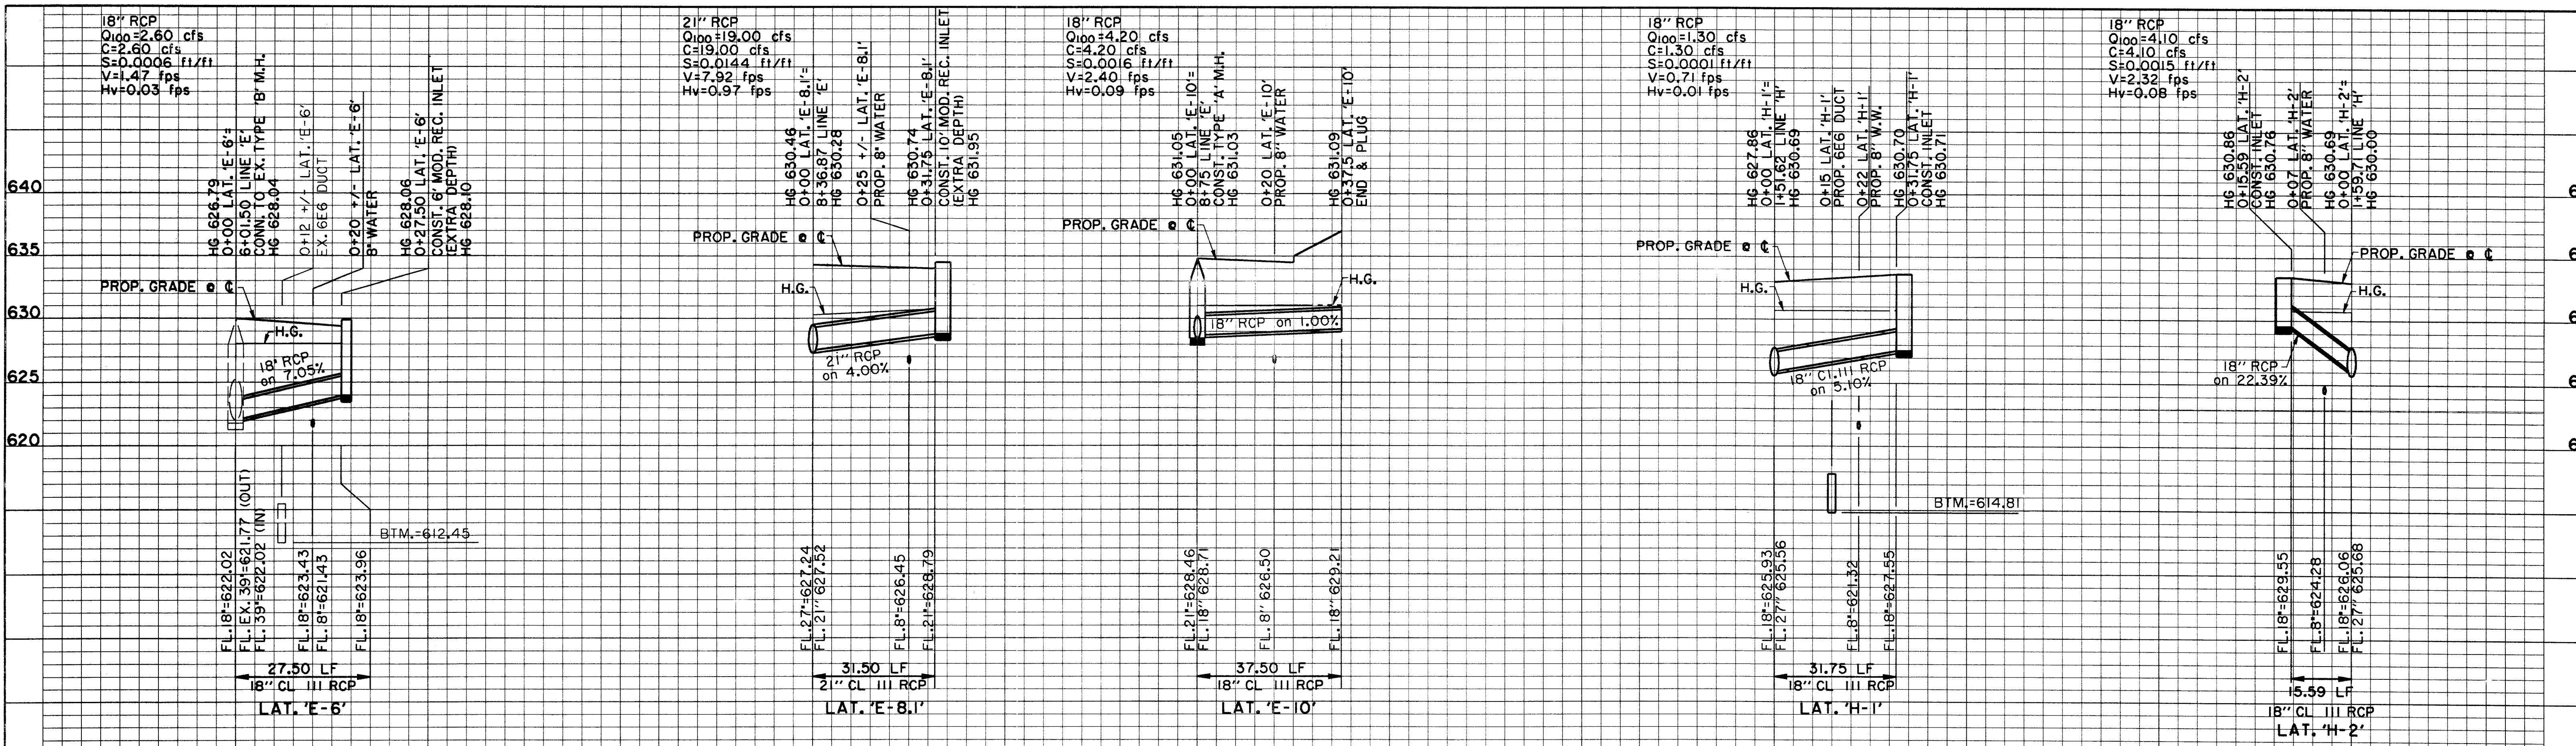

DATE	DESCRIPTION	REF NO.				
6/23/99	ISSUED FOR CONSTRUCTION	N/A				
5/17/99	ISSUED FOR BID	N/A				
<b>STORM WATER LATERAL PROFILES</b> <b>LATERALS E &amp; H</b> <b>ADDISON CIRCLE</b> <b>PHASE II-B PUBLIC INFRASTRUCTURE</b> <b>TOWN OF ADDISON, TEXAS</b>						
DESIGN	DRAWN	APPR.	SCALE	DATE	PROJECT NO.	NO.
HZI	HZI	DEM	N.T.S.	MAR. 99	01-1822-50	<b>SW7</b>