

# CONSTRUCTION PLANS FOR **PARKVIEW AT ADDISON CIRCLE**

## AN ADDITION TO THE TOWN OF ADDISON, TEXAS

DEVELOPER:

CITYHOMES

3209 North Fitzhugh Avenue

Dallas, Texas 75204

(214)219-2900

ENGINEER:

BROCKETTE · DAVIS · DRAKE


4144 North Central Expressway, Suite 1100

Dallas, Texas 75204

Tel: (214) 824-3647

### Index Of Drawings

- C1 COVER SHEET
- C2, C3 FINAL PLAT
- C4 DRAINAGE AREA MAP
- C5, C6 GRADING PLAN
- C7 PAVING PLAN & PROFILE  
SEABOLT DRIVE  
BREEDLOVE DRIVE
- C8 PAVING PLAN & PROFILE  
PARKVIEW DRIVE  
CALLOWAY DRIVE
- C9 PAVING PLAN & PROFILE  
PARKVIEW SOUTH DRIVE  
PARKVIEW NORTH DRIVE  
PARKVIEW DRIVE
- C10A QUORUM DRIVE IMPROVEMENTS
- C10B QUORUM DRIVE IMPROVEMENTS
- C11 PAVING PLAN (PRIVATE ONSITE)
- C12 STORM SEWER PLAN
- C13, C14, C15 STORM SEWER PROFILES
- C16 WATER PLAN
- C17 SANITARY SEWER PLAN
- C18, C19 SANITARY SEWER PROFILES
- C20 TXU DUCTBANK PLAN
- C21 TXU DUCTBANK PROFILE
- C22 TRAFFIC SIGNS & PAVEMENT MARKING PLAN
- C23 TRAFFIC CONTROL PLAN - QUORUM DRIVE
- C24 TRAFFIC CONTROL PLAN - MORRIS AVENUE
- C25 GENERAL NOTES
- C26 EROSION CONTROL PLAN
- C27 EROSION CONTROL DETAILS
- C28, C29 PAVING DETAILS
- C30, C31, C32 DRAINAGE DETAILS
- C33 WATER DETAILS
- C34 WASTEWATER DETAILS
- C35 - C42 TU ELECTRIC DUCTBANK DETAILS

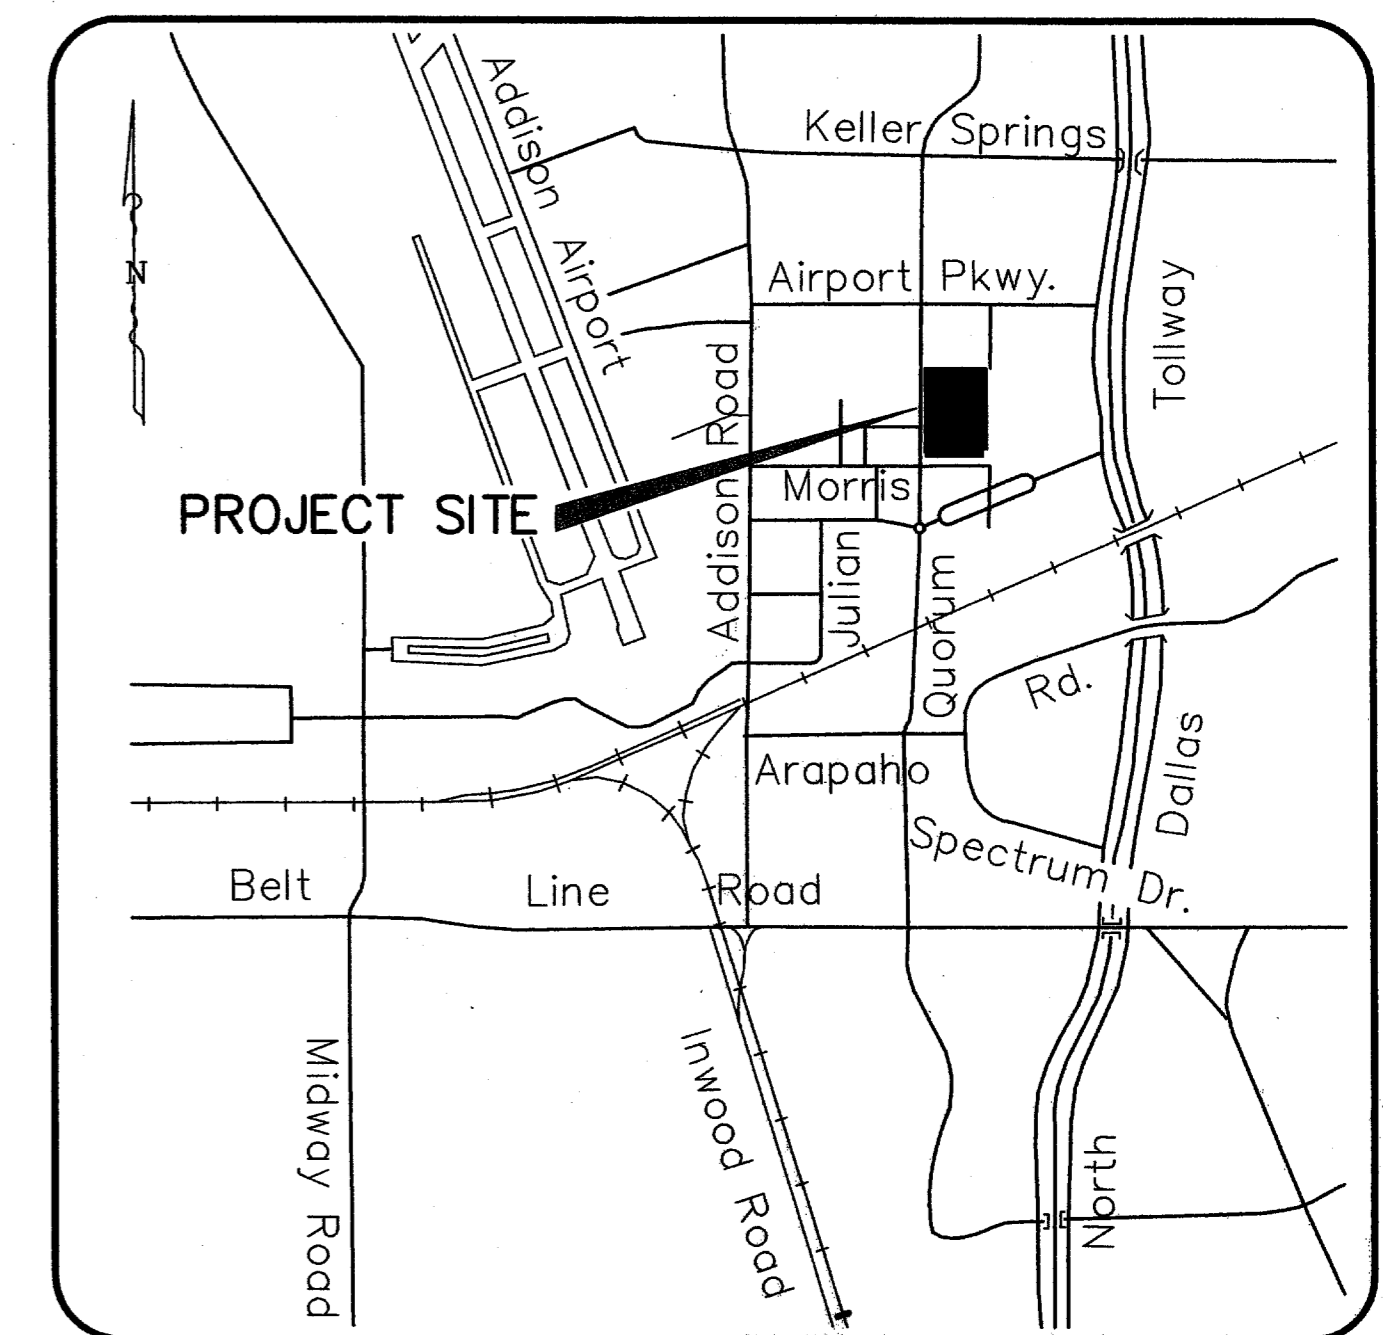

Location Map  
NTS

PARKVIEW AT ADDISON CIRCLE by CENTEX 2004

© Copyright 2003 Brockette/Davis/Drake, Inc. All Rights Reserved. No part of this document may be reproduced, stored in a retrieval system, or transmitted in any form or by any means, electronic, mechanical, photocopying, recording, or by any information storage and retrieval system, without the written authorization of Brockette/Davis/Drake, Inc. is prohibited.

**AS-BUILT**  
NOVEMBER 4, 2004

NOTE:  
THESE PLANS HAVE BEEN REVISED  
TO CONFORM WITH CONSTRUCTION  
RECORDS PROVIDED BY CONTRACTOR.

