


- GENERAL NOTES:**
1. ALL PERMANENT PAVEMENT MARKINGS SHALL BE INSTALLED AS SPECIFIED BY THE CITY OF ADDISON STANDARD DETAILS & SPECIFICATIONS FOR BOTH INSTALLATION TECHNIQUES AND MATERIALS.
  2. ANY PERMANENT PAVEMENT LANE DELINEATION MARKINGS THAT ARE MISSING OR DAMAGED SHALL BE REPLACED BY THE CONTRACTOR AT HIS OWN EXPENSE UPON COMPLETION OF THE PAVEMENT CONSTRUCTION WITHIN THE PUBLIC RIGHT OF WAY BETWEEN MORRIS AVE. AND AIRPORT PARKWAY ON QUORUM DRIVE.

**LEGEND**

8" REINFORCED CONC. PAVEMENT ON 6" LIME STABILIZED SUBGRADE

**NOTE:**  
ALL ADA ACCESSIBLE ROUTES SHALL HAVE MAXIMUM 2% CROSS SLOPES AND MAXIMUM 5% LONGITUDINAL SLOPE.

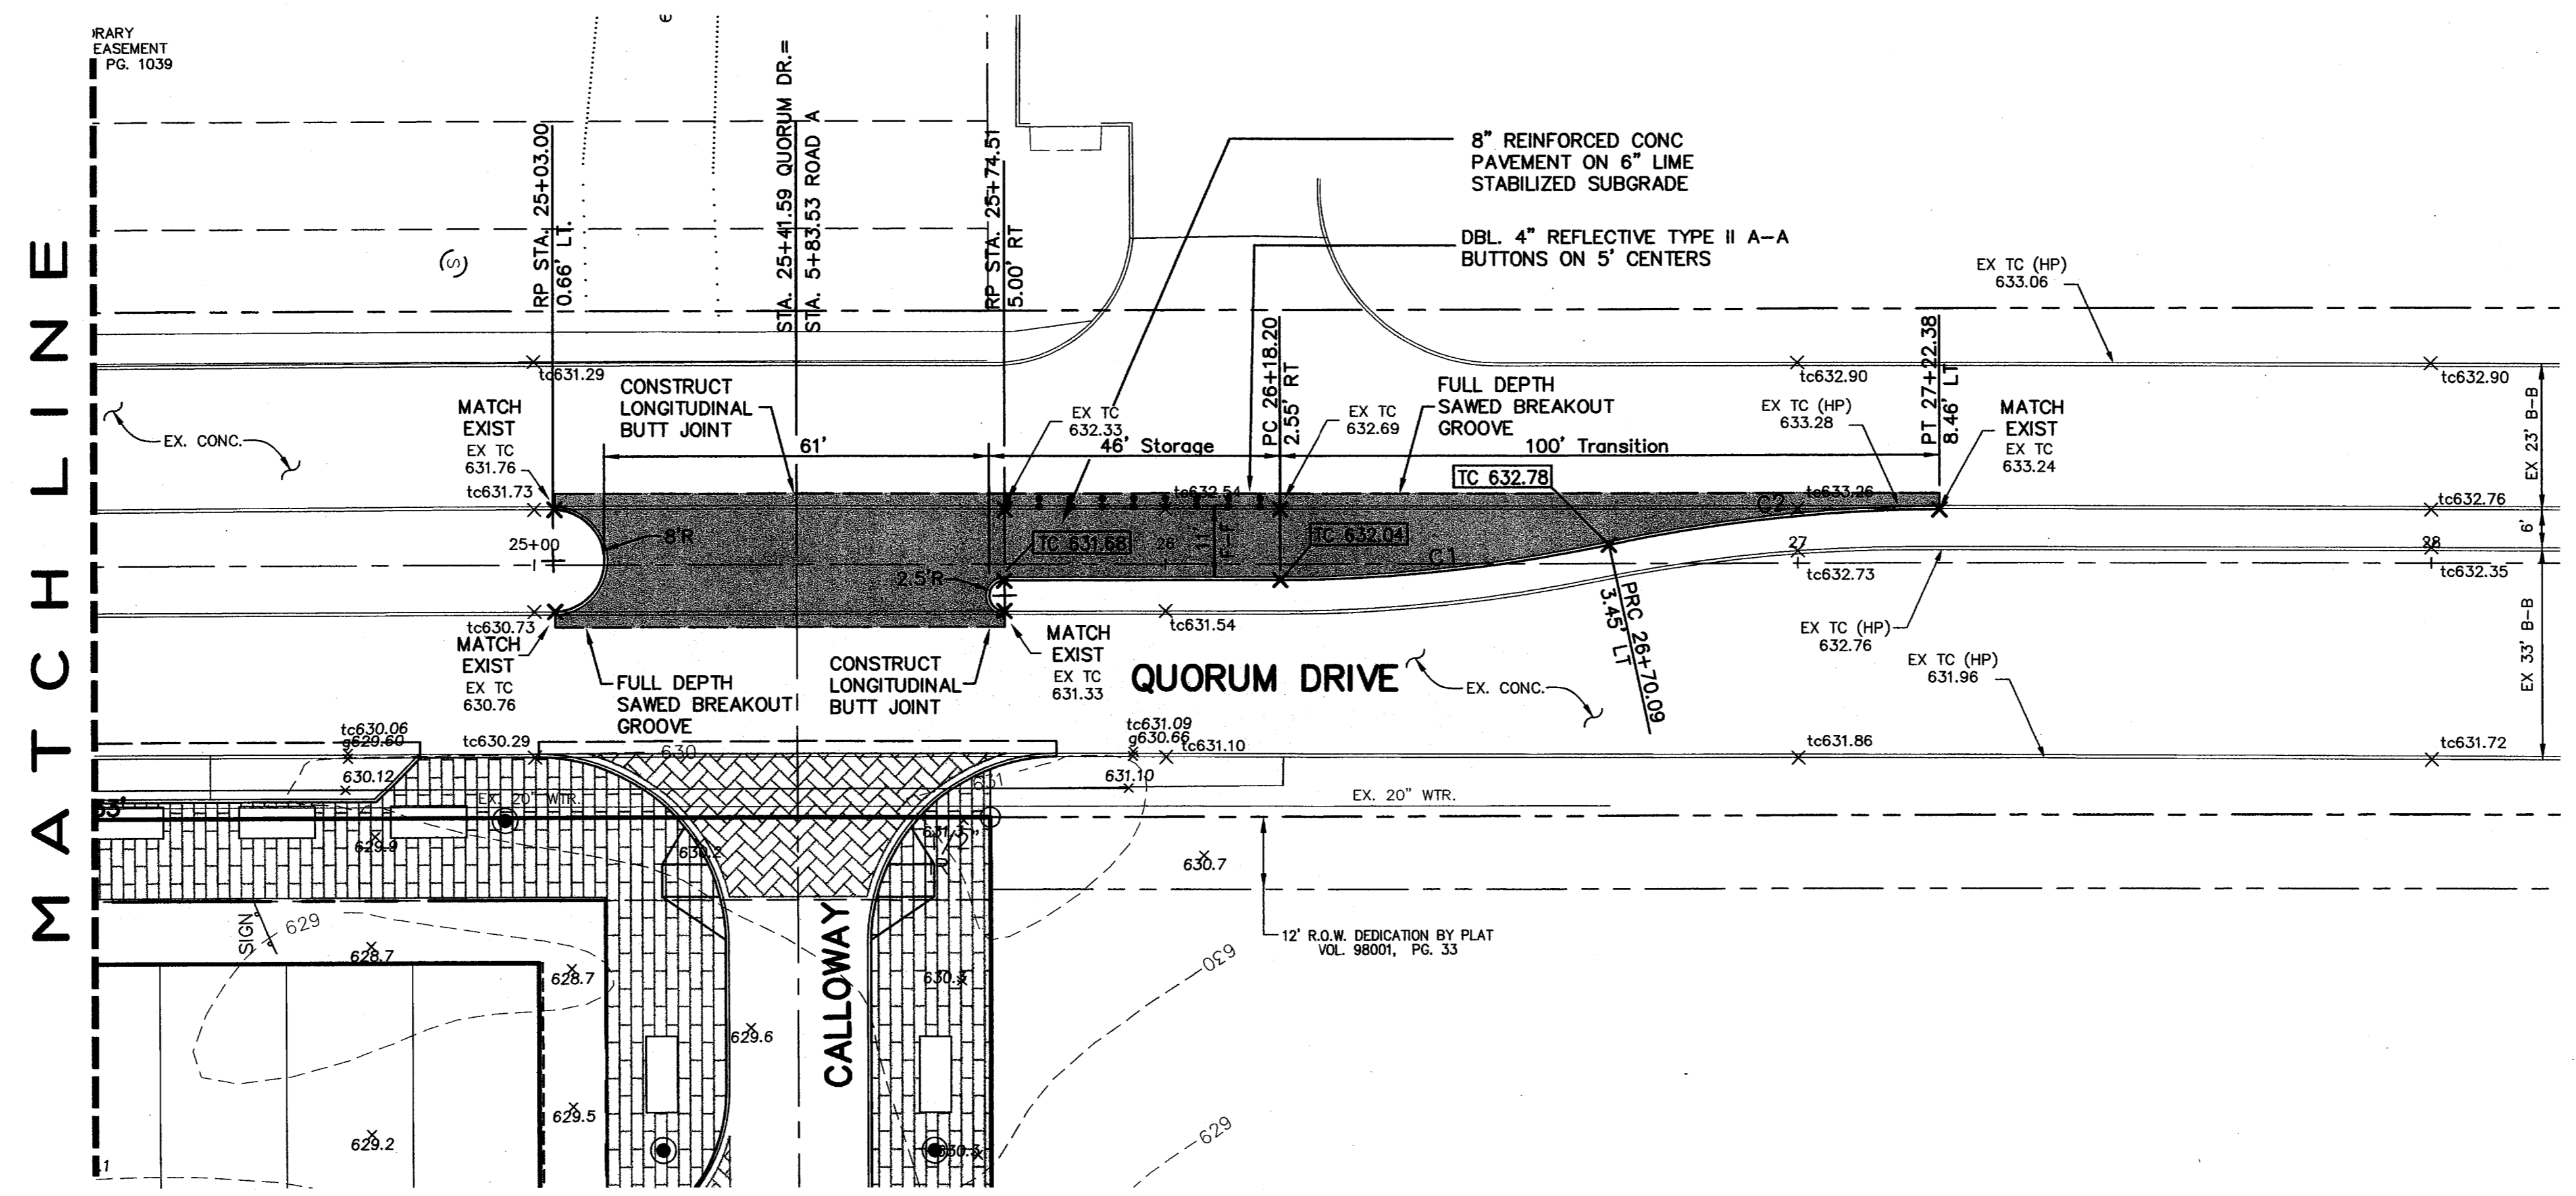


**NOTE:**  
INSTALL BRICK PAVERS PER DETAIL ON SHEET C29

**BENCHMARK:**  
"1" CUT ON EAST SIDE OF 6" INLET NORTH SIDE OF MORRIS AVENUE, 200' +/- EAST OF THE CENTERLINE OF QUORUM DRIVE.  
ELEVATION : 616.41

CURVE	DELTA	RADIUS	ARC	TANGENT	CHORD BEARING	CHORD LENGTH
C1	DELTA 12°00'15"	R 250.00'	ARC 52.38'	TAN. 26.29'	CH N 05°07'41" W	CH. DIST. 52.28'
C2	DELTA 12°03'02"	R 250.00'	ARC 52.58'	TAN. 26.39'	CH N 05°06'18" W	CH. DIST. 52.48'
C3	DELTA 12°01'44"	R 250.00'	ARC 52.49'	TAN. 26.34'	CH N 05°08'25" W	CH. DIST. 52.39'
C4	DELTA 12°04'31"	R 250.00'	ARC 52.69'	TAN. 26.44'	CH N 05°07'02" W	CH. DIST. 52.59'

**AS-BUILT**  
NOVEMBER 4, 2004

**NOTE:**  
THESE PLANS HAVE BEEN REVISED TO CONFORM WITH CONSTRUCTION RECORDS PROVIDED BY CONTRACTOR.

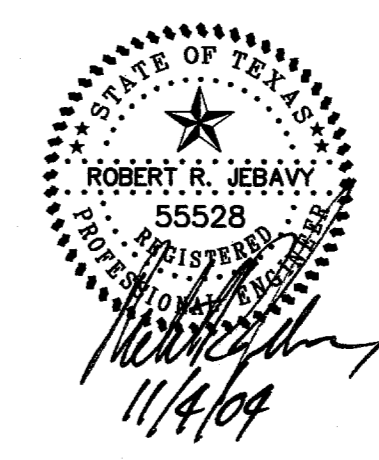

**QUORUM DRIVE IMPROVEMENTS**  
PARKVIEW AT ADDISON CIRCLE  
TOWN OF ADDISON, TEXAS  
DALLAS COUNTY

BROCKETTE · DAVIS · DRAKE , inc.  
consulting engineers  
Civil & Structural Engineering · Surveying  
4144 North Central Expressway, Suite 1100 Dallas, Texas 75204  
(214)824-3647, fax (214) 824-7064

DESIGNED	DRAWN	DATE	SCALE	NOTES	FILE	NO.
RRJ	BDD	04/04	1"=20'	BDD	C03393	C10A

Copyright 2003 Brockette/Davis/Drake, Inc. All Rights Reserved.  
 This drawing is the property of Brockette/Davis/Drake, Inc.  
 Any modification or use of this drawing without the express  
 written authorization of Brockette/Davis/Drake, Inc. is prohibited.