

**CAUTION!!!**  
 EXISTING PHONE, FIBER OPTICS, GAS, ELECTRICAL & CATV LINES IN PROJECT AREA. CONTRACTOR SHALL VERIFY LOCATION OF ALL UTILITIES PRIOR TO CONSTRUCTION. NOTIFY THE FOLLOWING UTILITY COMPANIES AT LEAST 48 HOURS PRIOR TO CONSTRUCTION.

TEXAS ONE CALL: 1-800-245-4545  
 COMCAST CABLEVISION: 1-214-320-7396  
 SOUTHWESTERN BELL TELE: 1-800-233-2133  
 T.X.U. ELECTRIC CO: 1-800-242-9113  
 T.X.U. GAS CO: 1-800-344-8337

- LEGEND**
- Existing Curb
  - Proposed Curb
  - - - Sawcut
  - E J - Expansion Joint
  - - - Proposed R.O.W.
  - 6" - 3600 PSI, Compressive Strength, Reinforced Conc. Pavement @ 28 Days, W/ 6" Lime Stabilized Subgrade.
  - ▨ BRICK PAVERS - SIDEWALK PAVERS
  - ▩ BRICK PAVERS - VEHICULAR PAVERS

**NOTE:**  
 ALL ADA ACCESSIBLE ROUTES SHALL HAVE MAXIMUM 2% CROSS SLOPES AND MAXIMUM 5% LONGITUDINAL SLOPE.


**NOTE:**  
 INSTALL BRICK PAVERS PER DETAIL ON SHEET C29

**BENCHMARK:**  
 "D" CUT ON EAST SIDE OF 6" INLET NORTH SIDE OF MORRIS AVENUE, 200' +/- EAST OF THE CENTERLINE OF QUORUM DRIVE.  
 ELEVATION: 616.41

PAVING PLAN (PRIVATE ONSITE)						
PARKVIEW AT ADDISON CIRCLE						
TOWN OF ADDISON, TEXAS						
DALLAS COUNTY						
BROCKETTE · DAVIS · DRAKE, inc.						
consulting engineers						
Civil & Structural Engineering · Surveying						
4144 North Central Expressway, Suite 1100 Dallas, Texas 75204						
(214) 824-3647, fax (214) 824-7064						
DESIGNED	DRAWN	DATE	SCALE	NOTES	FILE	NO.
RRJ	BDD	04/04	1"=40'	BDD	C03393	C11

**AS-BUILT**  
 NOVEMBER 4, 2004

**NOTE:**  
 THESE PLANS HAVE BEEN REVISED TO CONFORM WITH CONSTRUCTION RECORDS PROVIDED BY CONTRACTOR.

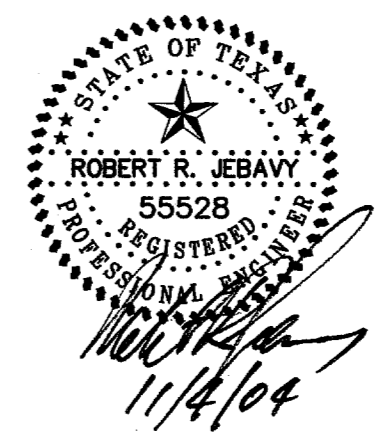

**NOTE:**  
 ALL DIMENSIONS ARE TO BACK OF CURB UNLESS OTHERWISE NOTED.

ADD 2' CURB AND BFR'S TO PARK AREA. 6/04/04

Copyright © 2003 Brockett/Davis/Drake, Inc. All Rights Reserved. No part of this drawing may be reproduced, stored in a retrieval system, or transmitted in any form or by any means, electronic, mechanical, photocopying, recording, or by any information storage and retrieval system, without the prior written authorization of Brockett/Davis/Drake, Inc. is prohibited.

TXU ELECTRIC COMPANY ESM.T.  
 VOL. 2000036, PG. 2913