


**CAUTION!!!**  
 CONTRACTOR SHALL VERIFY LOCATION  
 OF UTILITIES PRIOR TO DIGGING.  
 TEXAS ONE CALL: 1-800-245-4545

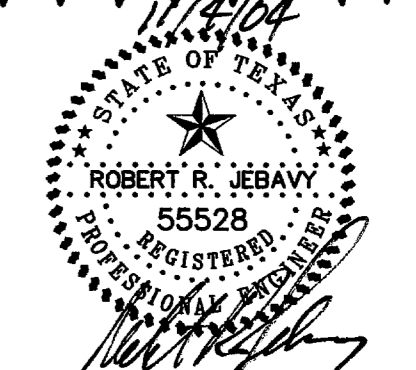

**BENCHMARK:**  
 "I" CUT ON EAST SIDE OF 6" INLET NORTH SIDE  
 OF MORRIS AVENUE, 200' +/- EAST OF THE  
 CENTERLINE OF QUORUM DRIVE.  
 ELEVATION : 616.41

**STORM SEWER PROFILES**  
 PARKVIEW AT ADDISON CIRCLE  
 TOWN OF ADDISON, TEXAS  
 DALLAS COUNTY

BROCKETTE · DAVIS · DRAKE , inc.  
 consulting engineers  
 Civil & Structural Engineering Surveying  
 4144 North Central Expressway, Suite 1100 Dallas, TEXAS 75204  
 (214)824-3647, fax (214) 824-7064

**AS-BUILT**  
 NOVEMBER 4, 2004

NOTE:  
 THESE PLANS HAVE BEEN REVISED  
 TO CONFORM WITH CONSTRUCTION  
 RECORDS PROVIDED BY CONTRACTOR.

- ▲ ADDED TELE. CONDUIT 6/23/04
- ▲ ADD TREE DRAIN STUB OUTS 6/04/04
- ▲ GRADE REVISIONS 5/20/04

DESIGNED	DRAWN	DATE	SCALE	NOTES	FILE	NO.
RRJ	BDD	04/04	H: 1"=40' V: 1"=6'	BDD	C03393	C13

Copyright 2000 Brockett, Davis, Drake, Inc. All Rights Reserved.  
 This drawing is the property of Brockett, Davis, Drake, Inc.  
 Any modification or use of this drawing without the express  
 written authorization of Brockett, Davis, Drake, Inc. is prohibited.