



© Copyright 2003 Brockette/Davis/Drake, Inc. All Rights Reserved. No part of this drawing may be reproduced, stored in a retrieval system, or used in any form without the express written authorization of Brockette/Davis/Drake, Inc. is prohibited.

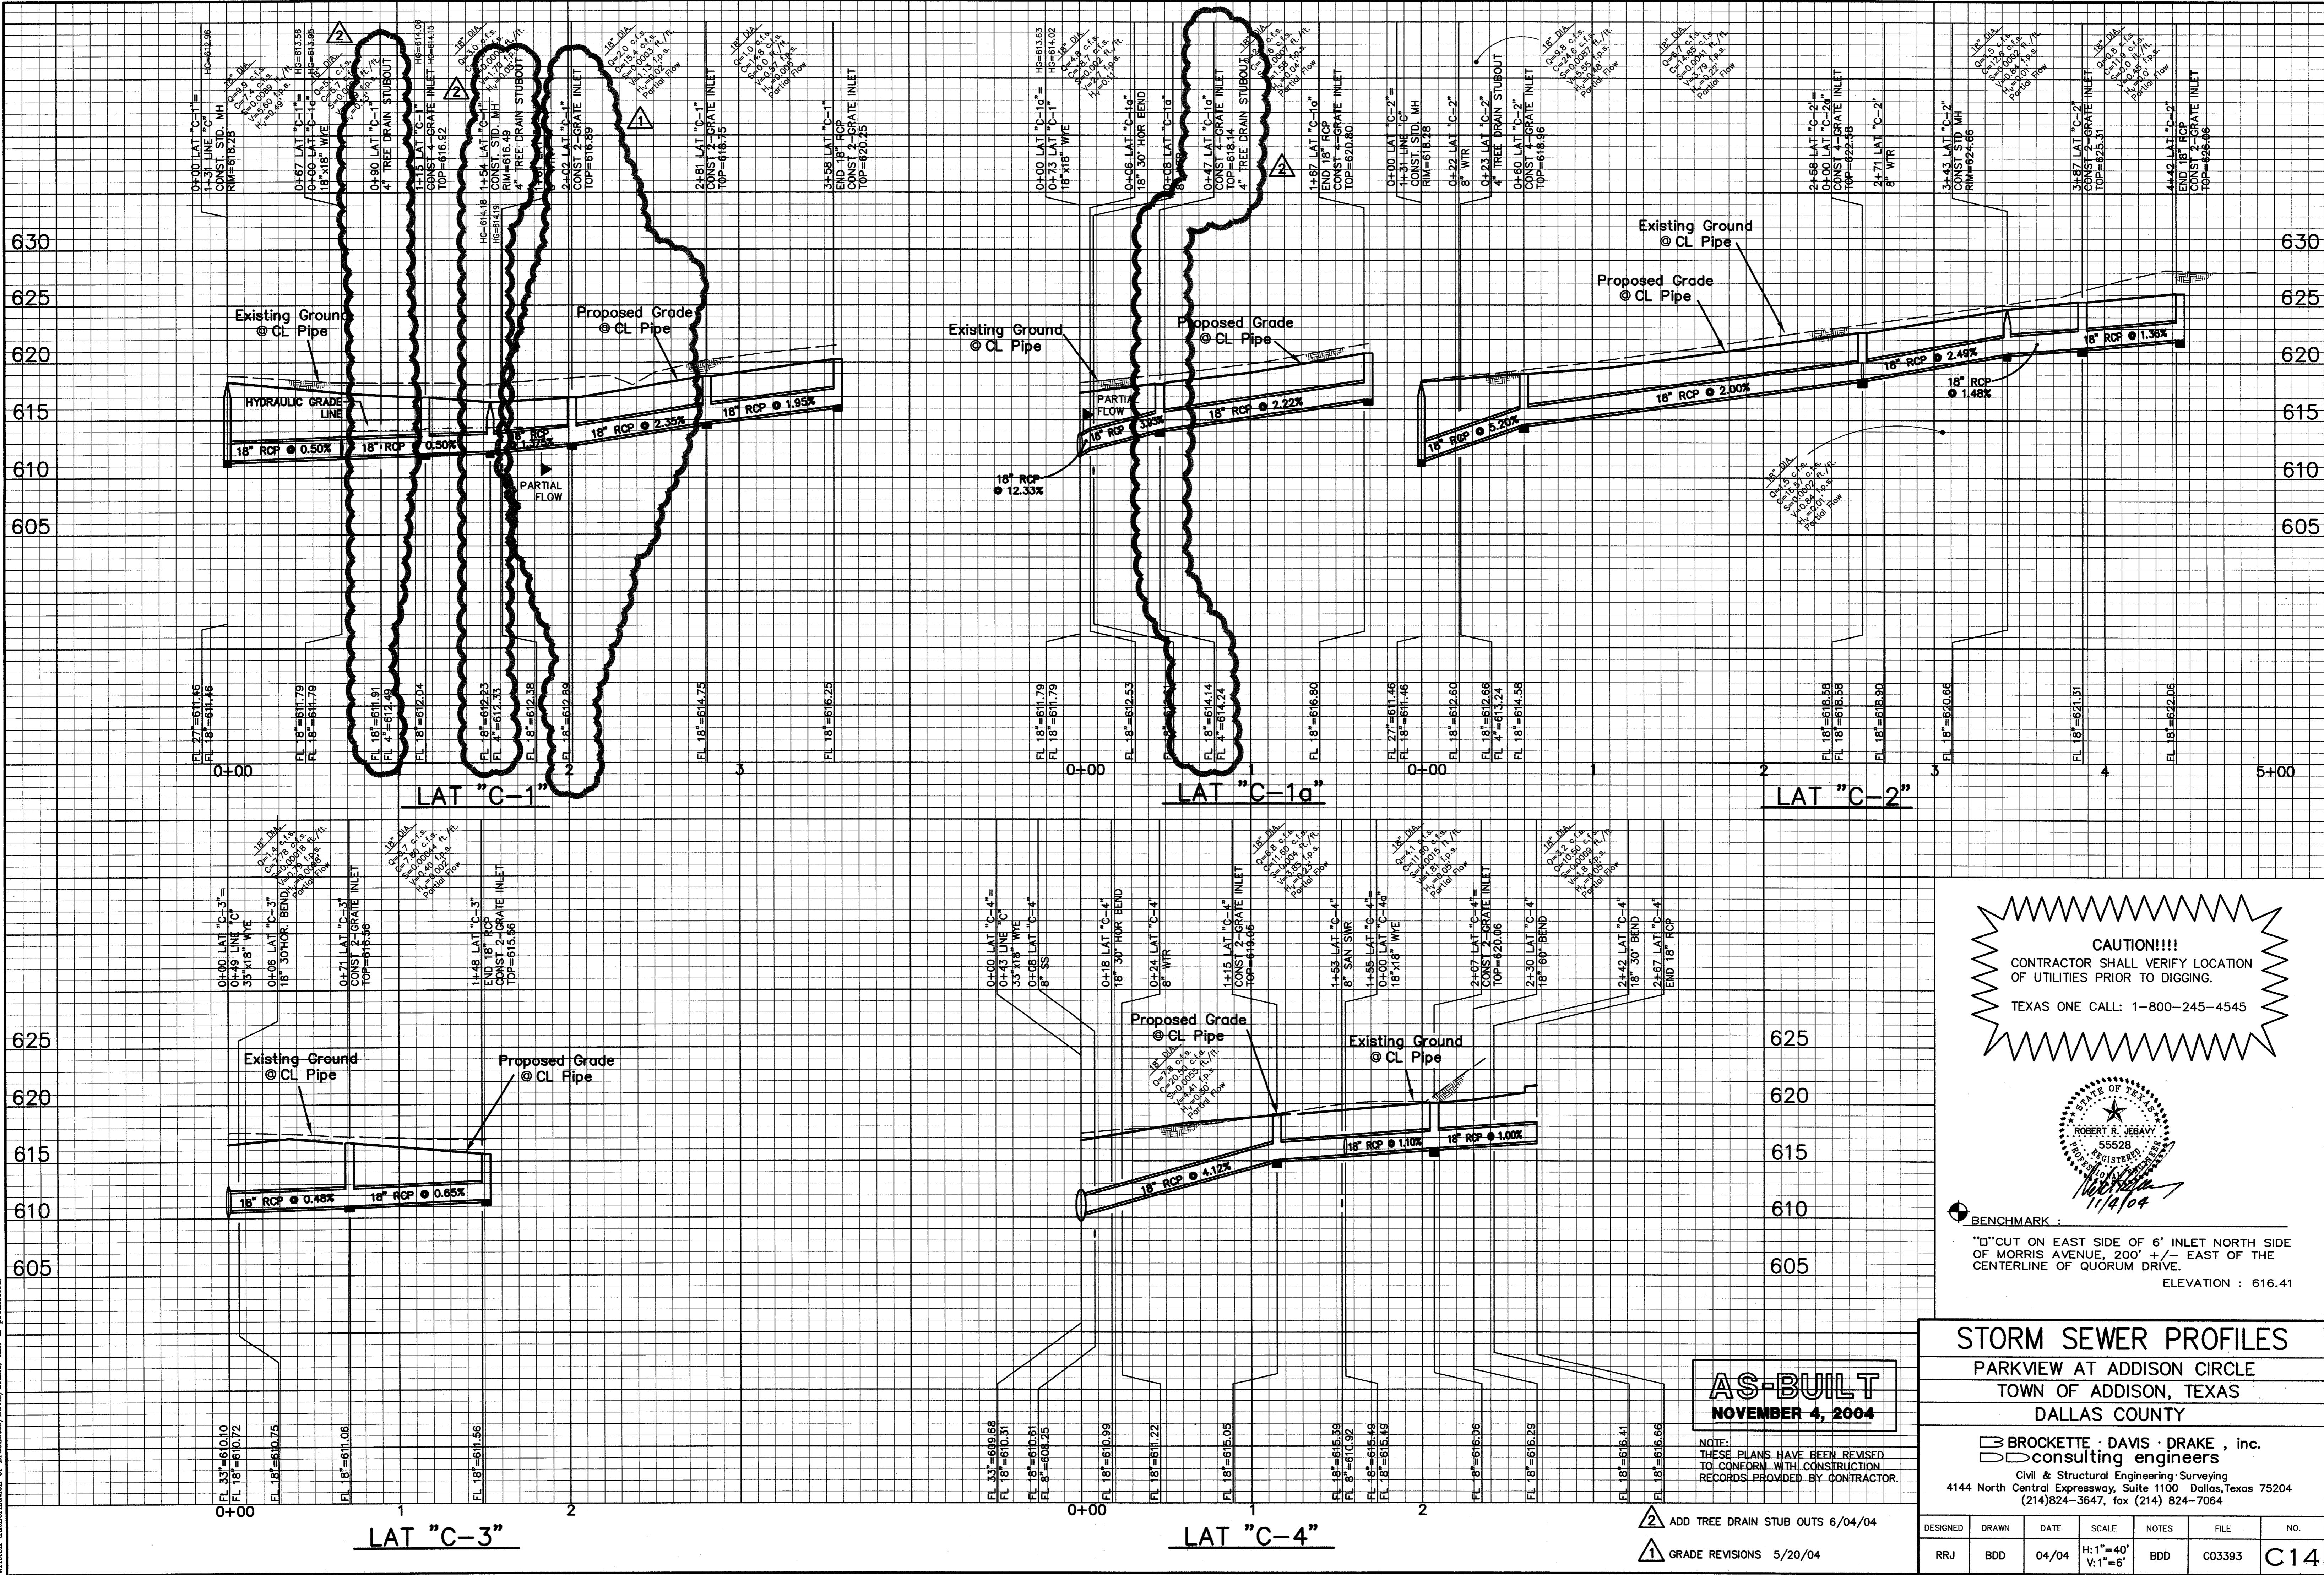

CAUTION!!!
 CONTRACTOR SHALL VERIFY LOCATION
 OF UTILITIES PRIOR TO DIGGING.
 TEXAS ONE CALL: 1-800-245-4545

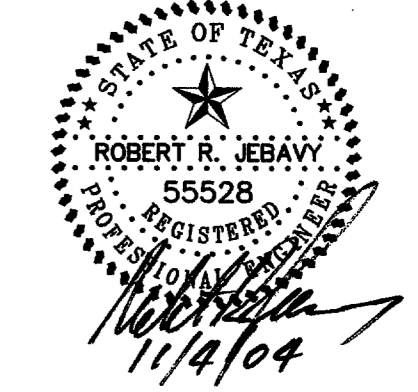

BENCHMARK:
 "D" CUT ON EAST SIDE OF 6" INLET NORTH SIDE
 OF MORRIS AVENUE, 200' +/- EAST OF THE
 CENTERLINE OF QUORUM DRIVE.
 ELEVATION: 616.41

STORM SEWER PROFILES
 PARKVIEW AT ADDISON CIRCLE
 TOWN OF ADDISON, TEXAS
 DALLAS COUNTY

AS-BUILT
 NOVEMBER 4, 2004

NOTICE:
 THESE PLANS HAVE BEEN REVISED
 TO CONFORM WITH CONSTRUCTION
 RECORDS PROVIDED BY CONTRACTOR.

DESIGNED	DRAWN	DATE	SCALE	NOTES	FILE	NO.
RRJ	BDD	04/04	H: 1"=40' V: 1"=6'	BDD	C03393	C14

- ▲ ADD TREE DRAIN STUB OUTS 6/04/04
- ▲ GRADE REVISIONS 5/20/04