


- WATER NOTES:**
1. ALL FITTINGS SHALL BE ANCHORED BY FLANGE, RESTRAINING GLAND, OR ANCHOR COUPLING.
 2. USE MEGA-LUG OR APPROVED EQUAL FOR RESTRAINING GLANDS.
 3. ALL 4" FIRE SERVICE CONNECTIONS TO BE MADE WITH 8"x4" TEE AND A 4" VALVE (FLANGED X MJ FITTINGS)

- LEGEND**
- Proposed R.O.W.
 - Existing Curb
 - Proposed Curb
 - xxxxxxx Existing Storm Sewer Line
 - Proposed Storm Sewer Line
 - Flow Arrow
 - Existing Water Line
 - Proposed Water Line
 - W - W - Proposed Water Service
 - Existing Sanitary Sewer Line
 - Proposed Sanitary Sewer Line
 - S - S - Proposed Sanitary Sewer Service
 - Existing Duct Bank
 - Existing Single Phase Overhead Primary
 - Existing Three Phase Underground Primary
 - Proposed 6E6 Duct Bank
 - Existing 4-Way Manhole
 - Proposed 4-Way Manhole

AS-BUILT
NOVEMBER 4, 2004

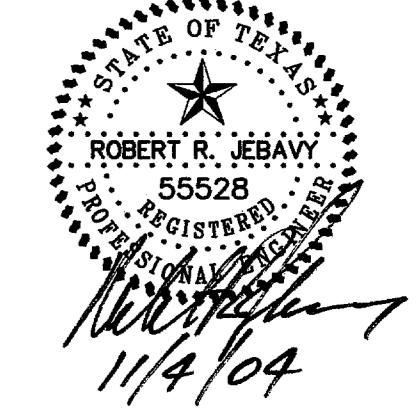

NOTE: THESE PLANS HAVE BEEN REVISED TO CONFORM WITH CONSTRUCTION RECORDS PROVIDED BY CONTRACTOR.

BENCHMARK:
"D" CUT ON EAST SIDE OF 6" INLET NORTH SIDE OF MORRIS AVENUE, 200' +/- EAST OF THE CENTERLINE OF QUORUM DRIVE.
ELEVATION: 616.41

WATER PLAN						
PARKVIEW AT ADDISON CIRCLE						
TOWN OF ADDISON, TEXAS						
DALLAS COUNTY						
BROCKETTE · DAVIS · DRAKE, Inc.						
consulting engineers						
Civil & Structural Engineering · Surveying						
4144 North Central Expressway, Suite 1100 Dallas, Texas 75204						
(214) 824-3647, fax (214) 824-7064						
DESIGNED	DRAWN	DATE	SCALE	NOTES	FILE	NO.
RRJ	BDD	04/04	1"=40'	BDD	C03393	C16

CAUTION!!!!
CONTRACTOR SHALL VERIFY LOCATION OF UTILITIES PRIOR TO DIGGING.
TEXAS ONE CALL: 1-800-245-4545

- 9 RELOCATED METER VAULTS 10/07/04
- 8 RELOCATED METER VAULTS 6/23/04

Copyright 2003 Brockette/Davis/Drake, Inc. All Rights Reserved. No part of these plans may be reproduced or transmitted in any form or by any means, electronic or mechanical, including photocopying, recording, or by any information storage and retrieval system, without the written authorization of Brockette/Davis/Drake, Inc. is prohibited.