

**CAUTION!!!**  
CONTRACTOR SHALL VERIFY LOCATION  
OF UTILITIES PRIOR TO DIGGING.  
TEXAS ONE CALL: 1-800-245-4545

**LEGEND**

- Proposed R.O.W.
- Existing Curb
- Proposed Curb
- XXXXXXXXXX Existing Storm Sewer Line
- Proposed Storm Sewer Line
- Flow Arrow
- Existing Water Line
- Proposed Water Line
- W-W- Proposed Water Service
- Existing Sanitary Sewer Line
- Proposed Sanitary Sewer Line
- Proposed 6" Sanitary Sewer Service
- Existing Duct Bank
- Existing Single Phase Overhead Primary
- Existing Three Phase Underground Primary
- Proposed 6E6 Duct Bank
- Existing 4-Way Manhole
- Proposed 4-Way Manhole

**BENCHMARK :**  
"D" CUT ON EAST SIDE OF 6" INLET NORTH SIDE  
OF MORRIS AVENUE, 200' +/- EAST OF THE  
CENTERLINE OF QUORUM DRIVE.  
ELEVATION : 616.41


**SANITARY SEWER PLAN**  
PARKVIEW AT ADDISON CIRCLE  
TOWN OF ADDISON, TEXAS  
DALLAS COUNTY

**BROCKETTE · DAVIS · DRAKE , inc.**  
consulting engineers  
Civil & Structural Engineering · Surveying  
4144 North Central Expressway, Suite 1100 Dallas, Texas 75204  
(214) 824-3647, fax (214) 824-7064

DESIGNED	DRAWN	DATE	SCALE	NOTES	FILE	NO.
RRJ	BDD	04/04	1"=40'	BDD	C03393	C17

**AS-BUILT**  
NOVEMBER 4, 2004

NOTE:  
THESE PLANS HAVE BEEN REVISED  
TO CONFORM WITH CONSTRUCTION  
RECORDS PROVIDED BY CONTRACTOR.

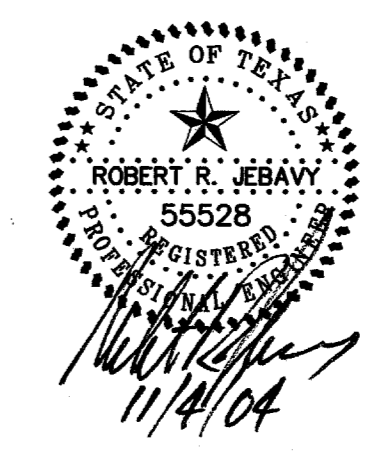

© Copyright 2003 Brockett/Davis/Drake, Inc. All Rights Reserved.  
No part of this drawing may be reproduced, stored in a retrieval system, or used in any form without the express written authorization of Brockett/Davis/Drake, Inc. is prohibited.

C03393 PLANS C017-SS-01