


- LEGEND**
- Proposed R.O.W.
 - Existing Curb
 - Proposed Curb
 - XXXXXX Existing Storm Sewer Line
 - ===== Proposed Storm Sewer Line
 - Flow Arrow
 - Existing Water Line
 - Proposed Water Line
 - W --- W --- Proposed Water Service
 - Existing Sanitary Sewer Line
 - Proposed Sanitary Sewer Line
 - S --- S --- Proposed Sanitary Sewer Service
 - ===== Existing Duct Bank
 - Existing Single Phase Overhead Primary
 - Existing Three Phase Underground Primary
 - ===== Proposed 8E6 Duct Bank
 - Existing 4-Way Manhole
 - Proposed 4-Way Manhole

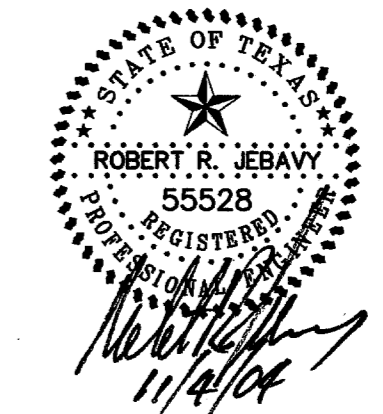

AS-BUILT
NOVEMBER 4, 2004

NOTE: THESE PLANS HAVE BEEN REVISED TO CONFORM WITH CONSTRUCTION RECORDS PROVIDED BY CONTRACTOR.

BENCHMARK:
"D" CUT ON EAST SIDE OF 6" INLET NORTH SIDE OF MORRIS AVENUE, 200' +/- EAST OF THE CENTERLINE OF QUORUM DRIVE.
ELEVATION: 616.41

CAUTION!!!!
CONTRACTOR SHALL VERIFY LOCATION OF UTILITIES PRIOR TO DIGGING.
TEXAS ONE CALL: 1-800-245-4545

DUCTBANK PLAN						
PARKVIEW AT ADDISON CIRCLE						
TOWN OF ADDISON, TEXAS						
DALLAS COUNTY						
BROCKETTE · DAVIS · DRAKE, inc. consulting engineers						
Civil & Structural Engineering · Surveying						
4144 North Central Expressway, Suite 1100 Dallas, Texas 75204						
(214)824-3647, fax (214) 824-7064						
DESIGNED	DRAWN	DATE	SCALE	NOTES	FILE	NO.
RRJ	BDD	04/04	1"=40'	BDD	C03393	C20

Copyright 2003 Brockette/Davis/Drake, Inc. All Rights Reserved.
 This drawing is the property of Brockette/Davis/Drake, Inc.
 Any modification or use of this drawing without the express
 written authorization of Brockette/Davis/Drake, Inc. is prohibited.