

- SIGNAGE & PAVEMENT MARKING NOTES:**
1. STOP LINES ARE TO BE 14" WIDE, WHITE, PAINTED LINES ON THE PAVEMENT WHICH EXTEND ACROSS THE ENTIRE APPROACH LANE. THE STOP LINES ARE TO BE OFF-SET 4' FROM AND PARALLEL TO THE NEAREST PEDESTRIAN CROSS WALK OR ROADWAY.
 2. STOP LINES SHALL BE USED IN CONJUNCTION WITH STOP SIGNS AND SHALL BE PLACED IN LINE WITH THE STOP SIGN.
 3. MATERIALS SHALL BE MET OR EXCEED THE REQUIREMENTS FOR SIGNS AND PAVEMENT MARKINGS AS SPECIFIED BY THE TOWN OF ADDISON AND THE DESIGN STANDARDS AND SPECIFICATIONS DEVELOPED BY THE TEXAS DEPT. OF TRANSPORTATION.

- LEGEND**
- Proposed R.O.W.
 - Existing Curb
 - - - Proposed Curb
 - 6"-3600 PSI, Compressive Strength, Reinforced Conc. Pavement @ 28 Days, W/ 6" Lime Stabilized Subgrade.

NOTE:
ALL ADA ACCESSIBLE ROUTES SHALL HAVE MAXIMUM 2% CROSS SLOPES AND MAXIMUM 5% LONGITUDINAL SLOPE.

BENCHMARK:
"D" CUT ON EAST SIDE OF 6" INLET NORTH SIDE OF MORRIS AVENUE, 200' +/- EAST OF THE CENTERLINE OF QUORUM DRIVE.
ELEVATION : 616.41


PERMANENT TRAFFIC SIGNS AND PAVEMENT MARKING PLAN
PARKVIEW AT ADDISON CIRCLE
TOWN OF ADDISON, TEXAS
DALLAS COUNTY

□ BROCKETTE · DAVIS · DRAKE, inc.
◇ consulting engineers
Civil & Structural Engineering Surveying
4144 North Central Expressway, Suite 1100 Dallas, Texas 75204
(214) 824-3647, fax (214) 824-7064

DESIGNED	DRAWN	DATE	SCALE	NOTES	FILE	NO.
RRJ	BDD	04/04	1"=40'	BDD	C03393	C22

AS-BUILT
NOVEMBER 4, 2004

NOTE:
THESE PLANS HAVE BEEN REVISED TO CONFORM WITH CONSTRUCTION RECORDS PROVIDED BY CONTRACTOR.

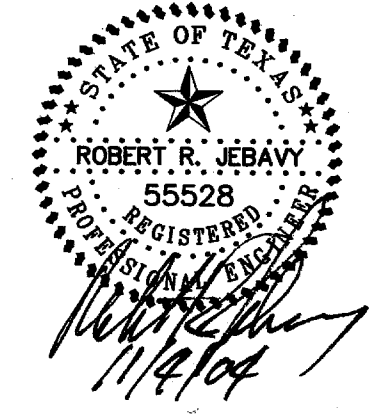

▲ ADD TRAFFIC SIGNS AND MOVE STOP BARS

© Copyright 2003 Brockett/Davis/Drake, Inc. All Rights Reserved.
 This project is the property of Brockett/Davis/Drake, Inc.
 Any modification or use of this plan without the written authorization of Brockett/Davis/Drake, Inc. is prohibited.

TXU ELECTRIC COMPANY ESMT.
VOL. 2000036, PG. 2913