




**VEHICULAR BRICK INSTALLATION  
IN VEHICULAR AREAS**

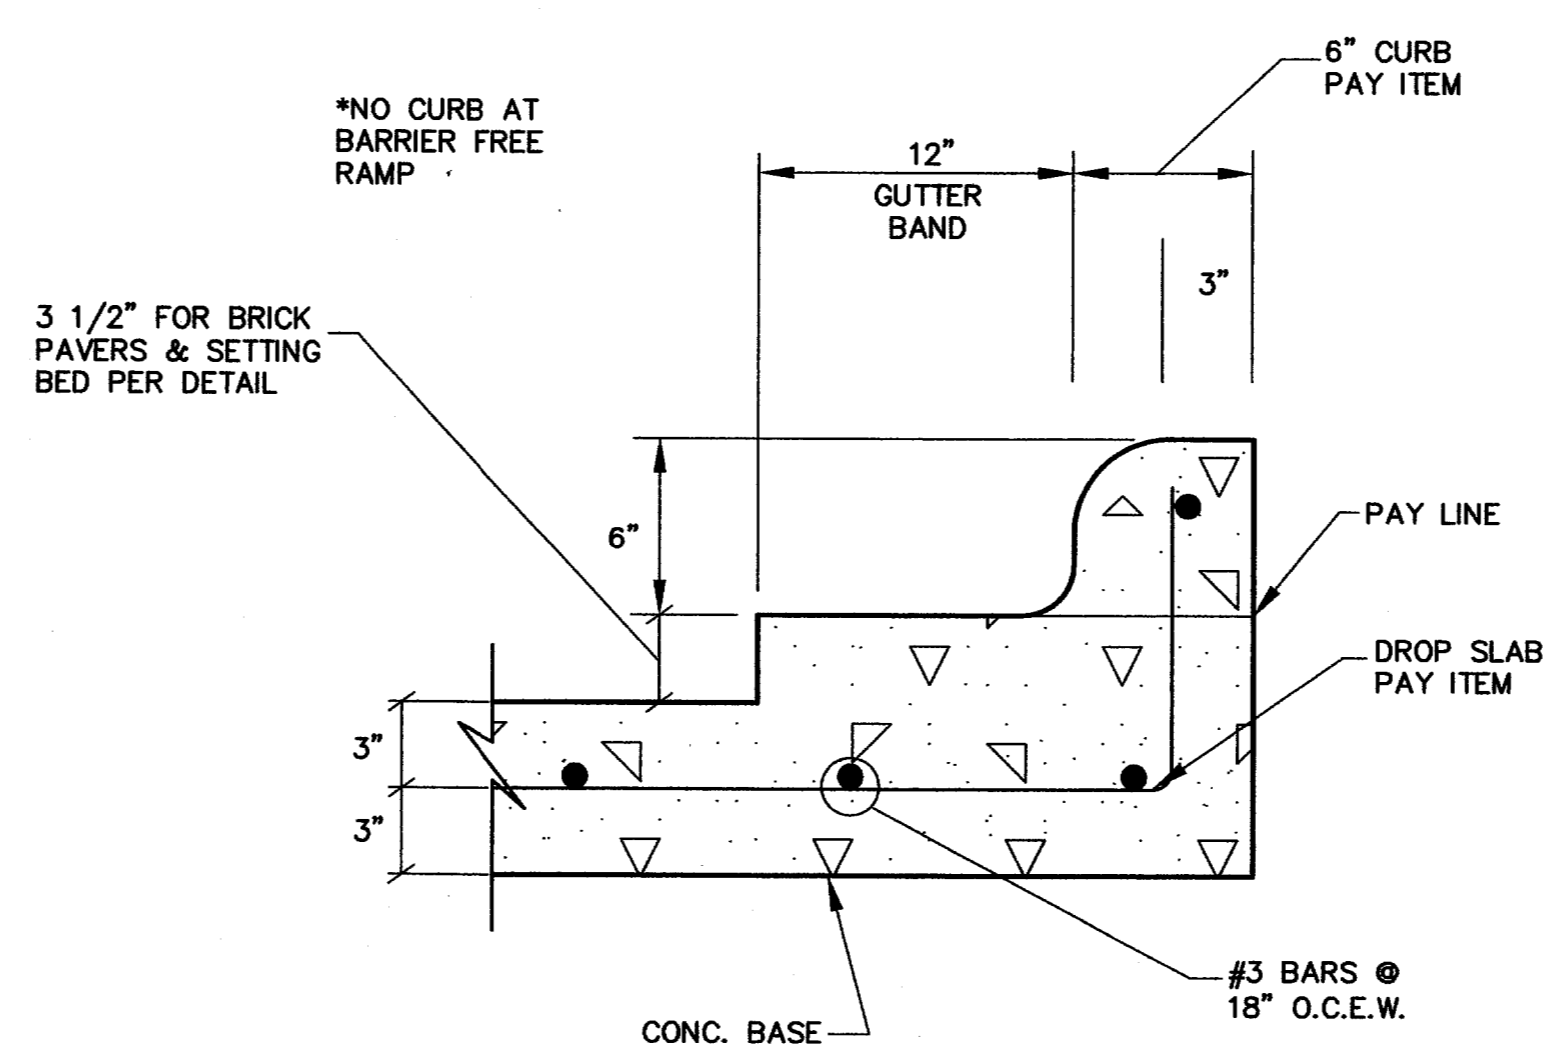


**SECTION THRU CURB AT DROP SLAB  
N.T.S.**

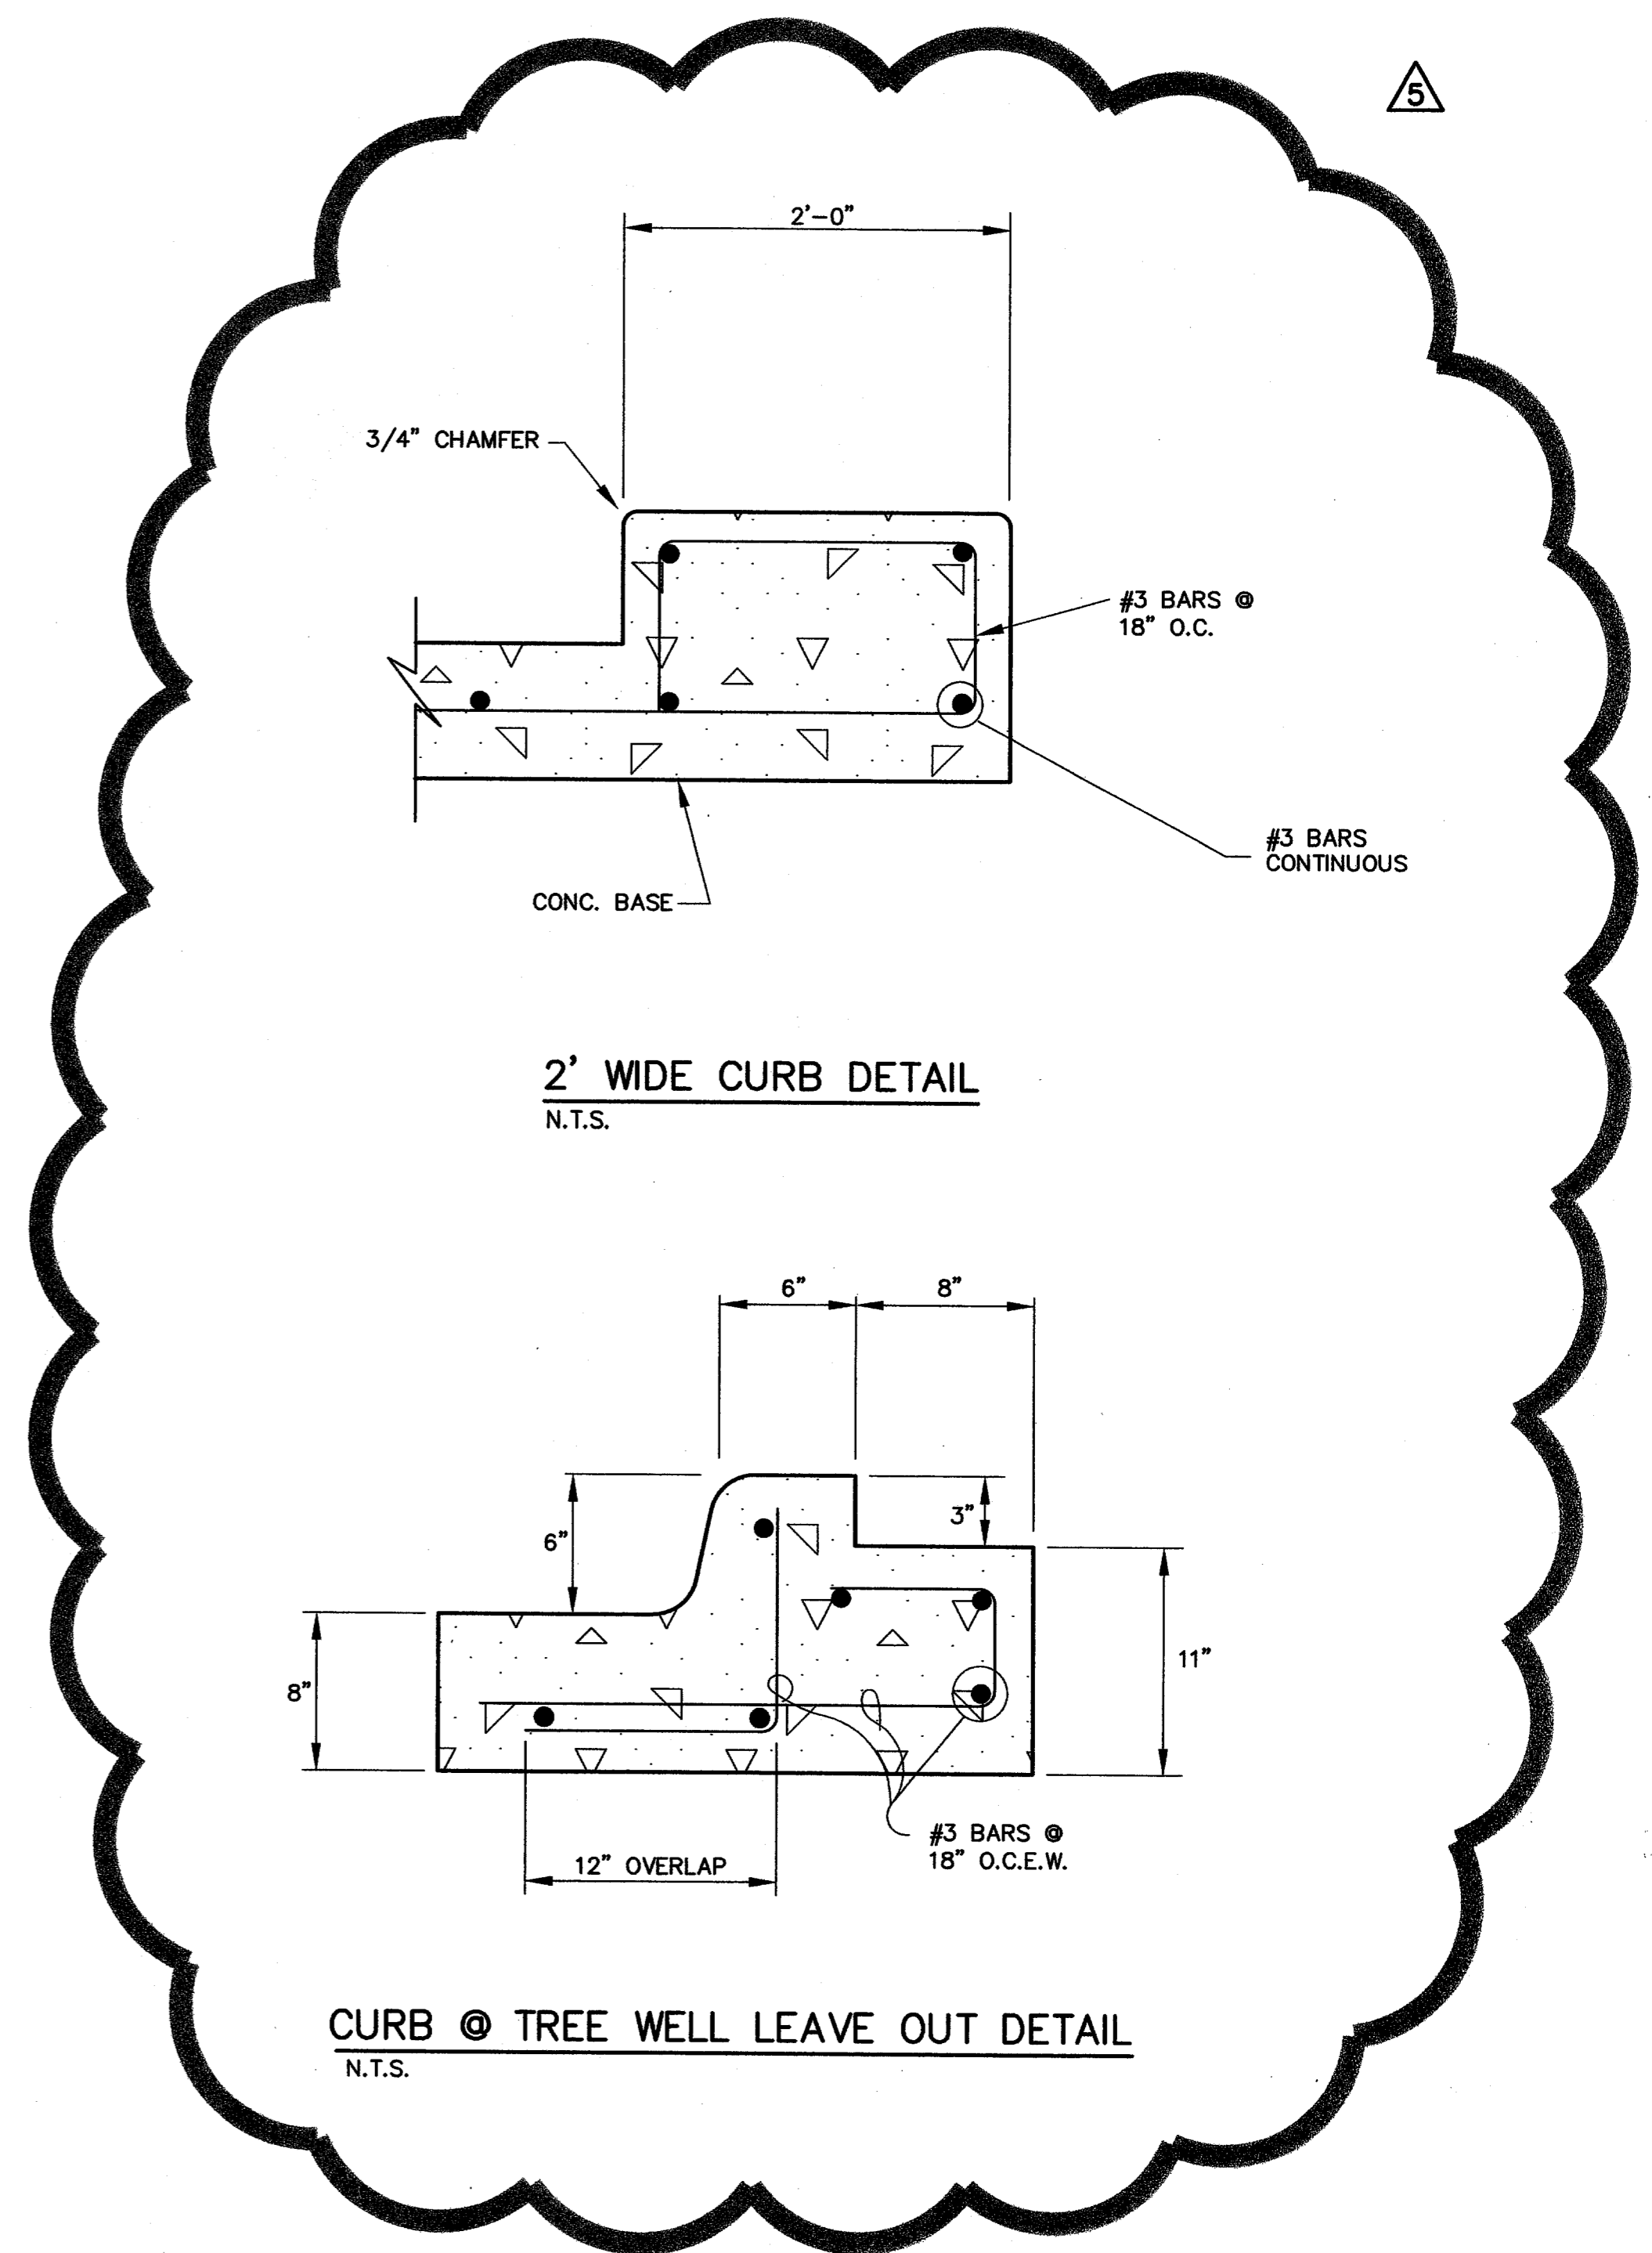

**2' WIDE CURB DETAIL  
N.T.S.**

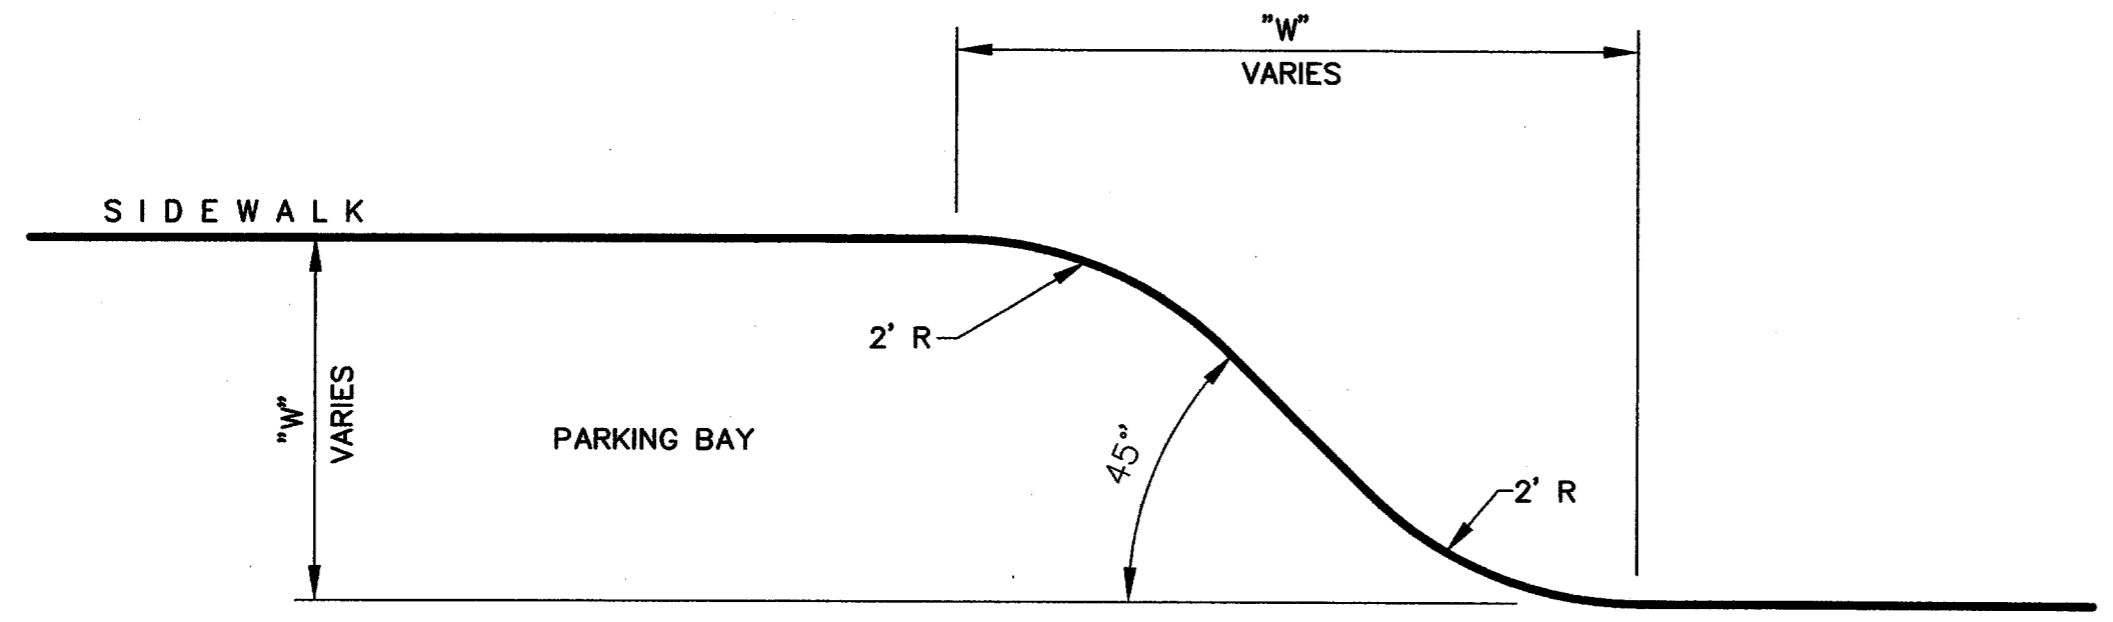

**PARKING TRANSITION DETAIL  
N.T.S.**

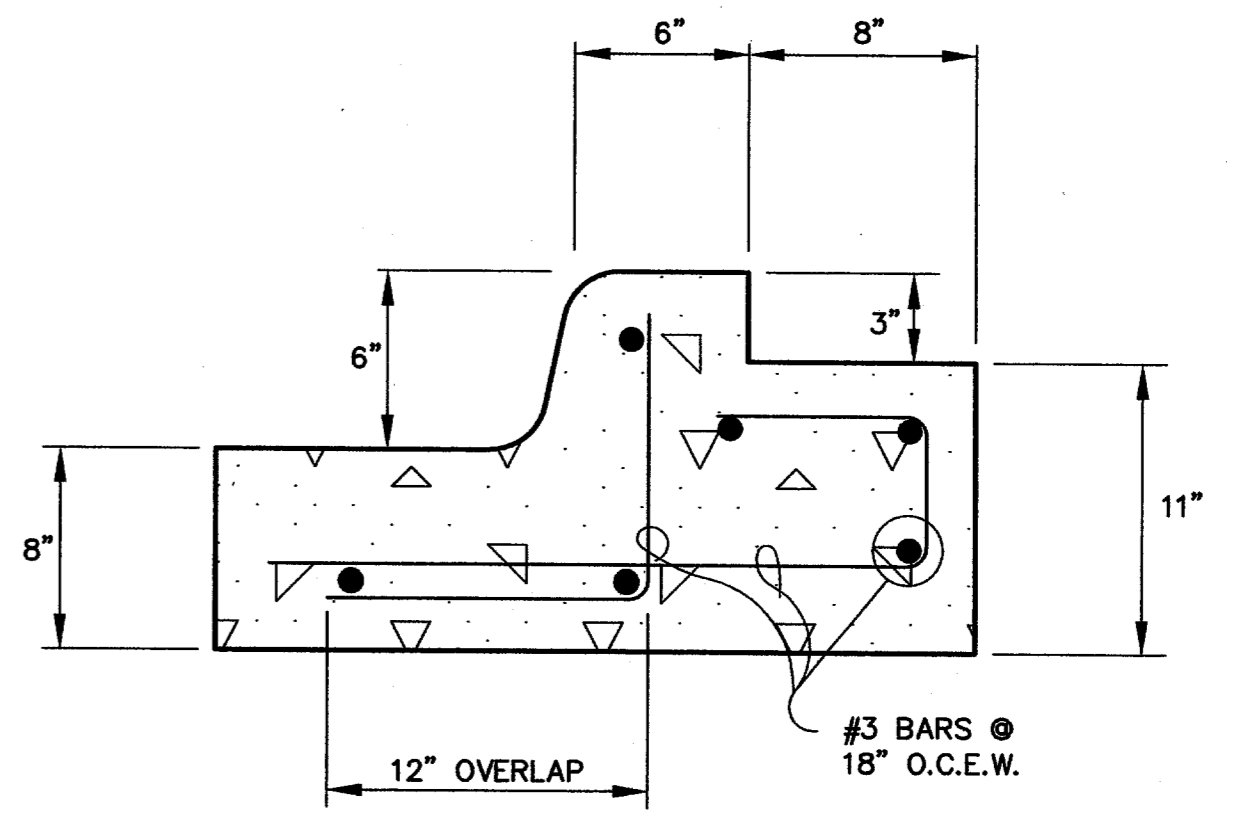


**CURB @ TREE WELL LEAVE OUT DETAIL  
N.T.S.**

Copyright 2003 Brockette/Davis/Drake, Inc. All Rights Reserved.  
 This drawing is the property of Brockette/Davis/Drake, Inc.  
 Any modification or use of this drawing without the express  
 written authorization of Brockette/Davis/Drake, Inc. is prohibited.

**AS-BUILT**  
NOVEMBER 4, 2004

NOTE:  
THESE PLANS HAVE BEEN REVISED  
TO CONFORM WITH CONSTRUCTION  
RECORDS PROVIDED BY CONTRACTOR.

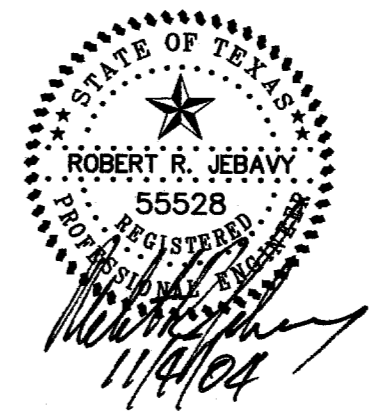

**NOTE:**  
ALL ADA ACCESSIBLE ROUTES SHALL HAVE  
MAXIMUM 2% CROSS SLOPES AND MAXIMUM  
5% LONGITUDINAL SLOPE.

PAVING DETAILS						
PARKVIEW AT ADDISON CIRCLE						
TOWN OF ADDISON, TEXAS						
DALLAS COUNTY						
BROCKETTE · DAVIS · DRAKE , inc. consulting engineers Civil & Structural Engineering · Surveying 4144 North Central Expressway, Suite 1100 Dallas, Texas 75204 (214)824-3647, fax (214) 824-7064						
DESIGNED	DRAWN	DATE	SCALE	NOTES	FILE	NO.
RRJ	BDD	04/04	AS SHOWN	BDD	C03393	C29

CO3393 PLANS CD-19-PAY-DETS-FV.DWG