

**HORIZONTAL BENDS**

DELTA		11.25'									22.50'									DELTA	
I.D. (IN.)	G FT.	EARTH			ROCK			G FT.	THRUST TONS	EARTH			ROCK			I.D. (IN.)					
		A. FT.	B. FT.	VOL. C.Y.	A. FT.	B. FT.	VOL. C.Y.			A. FT.	B. FT.	VOL. C.Y.	A. FT.	B. FT.	VOL. C.Y.						
4,6,8	0.4	1.0	1.5	0.1	1.0	1.0	0.8	2.0	1.5	1.5	0.1	1.0	1.0	0.1	4,6,8						
10,12	0.6	2.2	1.5	0.1	1.5	1.5	1.1	4.4	2.0	2.5	0.3	1.5	1.5	0.1	10,12						
16,18	0.8	5.0	2.0	0.3	1.5	2.0	1.6	9.9	3.0	3.5	0.6	2.0	2.5	0.3	16,18						
24	1.1	8.9	3.0	0.5	1.5	3.0	2.2	17.7	4.0	4.5	1.0	3.0	3.5	0.5	24						








  

DELTA		45'									90'									DELTA	
I.D. (IN.)	G FT.	EARTH			ROCK			G FT.	THRUST TONS	EARTH			ROCK			I.D. (IN.)					
		A. FT.	B. FT.	VOL. C.Y.	A. FT.	B. FT.	VOL. C.Y.			A. FT.	B. FT.	VOL. C.Y.	A. FT.	B. FT.	VOL. C.Y.						
4,6,8	0.4	3.9	2.0	0.2	1.5	1.5	0.4	5.0	5.0	1.5	0.4	2.0	2.0	0.2	4,6,8						
10,12	0.5	8.7	3.5	0.5	2.0	2.5	0.5	6.5	6.5	2.5	1.0	3.5	2.5	0.5	10,12						
16,18	0.6	19.5	4.5	1.2	3.0	3.5	0.6	9.0	9.0	4.0	2.4	4.5	4.0	1.0	16,18						
24	0.9	34.6	8.0	2.3	4.5	4.0	0.9	14.5	14.5	4.5	5.0	8.0	4.0	2.1	24						

I.D. (IN.)	THRUST TONS	EARTH			ROCK	
		C. FT.	A. FT.	VOL. C.Y.	A. FT.	VOL. C.Y.
4,6,8	5.1	1.5	2.5	0.3	2.0	0.2
10,12	11.3	1.5	3.5	0.6	2.5	0.3
16,18	25.5	2.0	5.5	1.6	4.0	0.9
24	45.2	2.5	7.0	3.1	5.0	1.7

**VERTICAL BENDS**

I.D. (IN.)	THRUST TONS	11.25'		22.50'		30'		45'		67.50'		90'		I.D. (IN.)
		THRUST TONS	VOL. C.Y.	THRUST TONS	VOL. C.Y.	THRUST TONS	VOL. C.Y.	THRUST TONS	VOL. C.Y.	THRUST TONS	VOL. C.Y.	THRUST TONS	VOL. C.Y.	
4,6,8	1.0	0.5	2.0	1.0	2.5	1.3	3.6	1.8	4.6	2.3	5.0	2.5	4,6,8	
10,12	2.2	1.1	4.3	2.2	5.7	2.8	8.0	4.0	10.5	5.2	11.3	5.7	10,12	
16,18	5.0	2.5	9.7	4.9	12.7	6.4	18.0	9.0	23.5	11.8	25.5	12.7	16,18	
24	8.2	4.4	17.3	8.7	22.6	11.3	32.0	16.0	41.8	20.9	45.2	22.6	24	

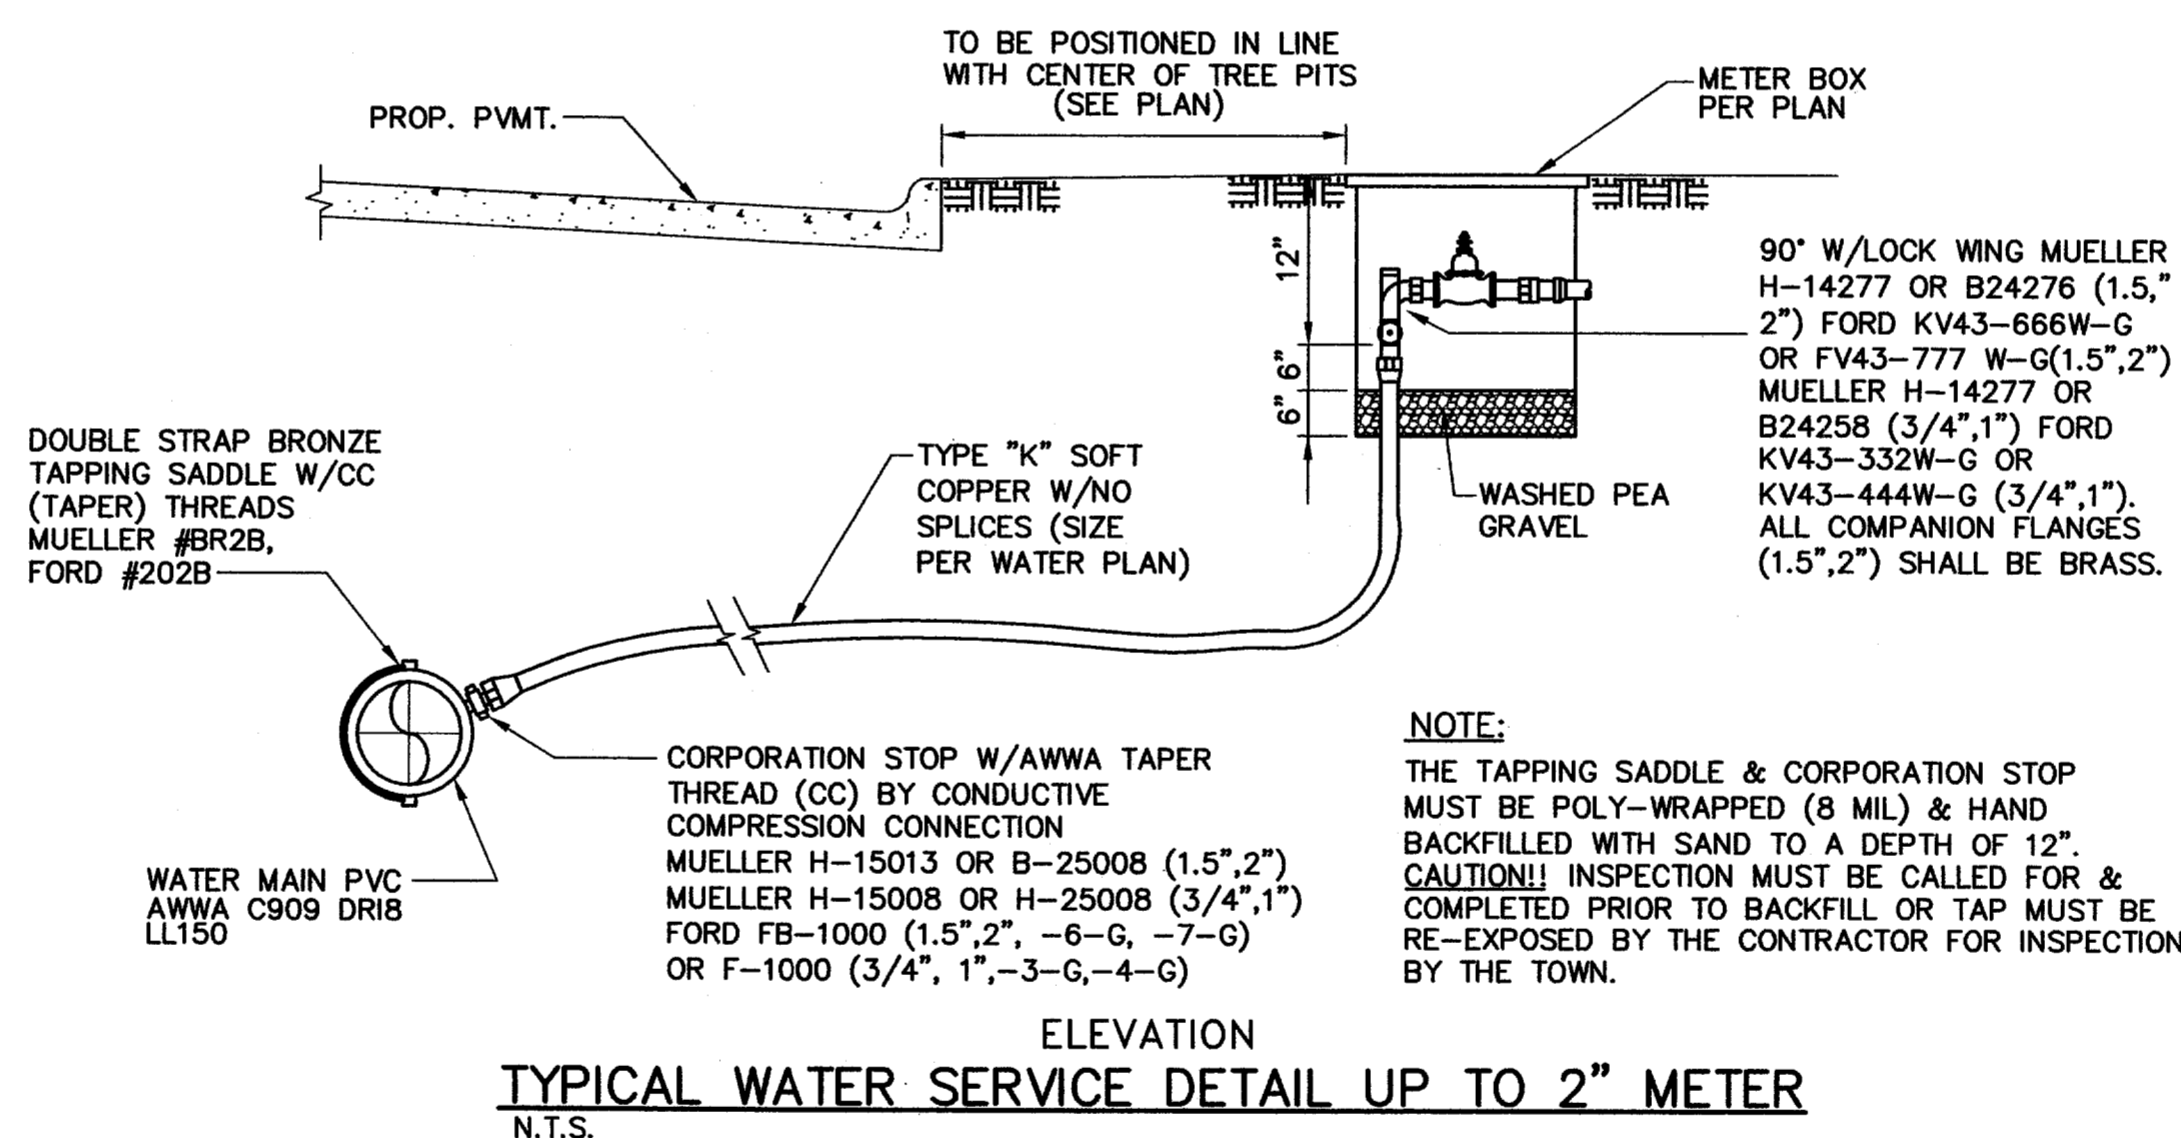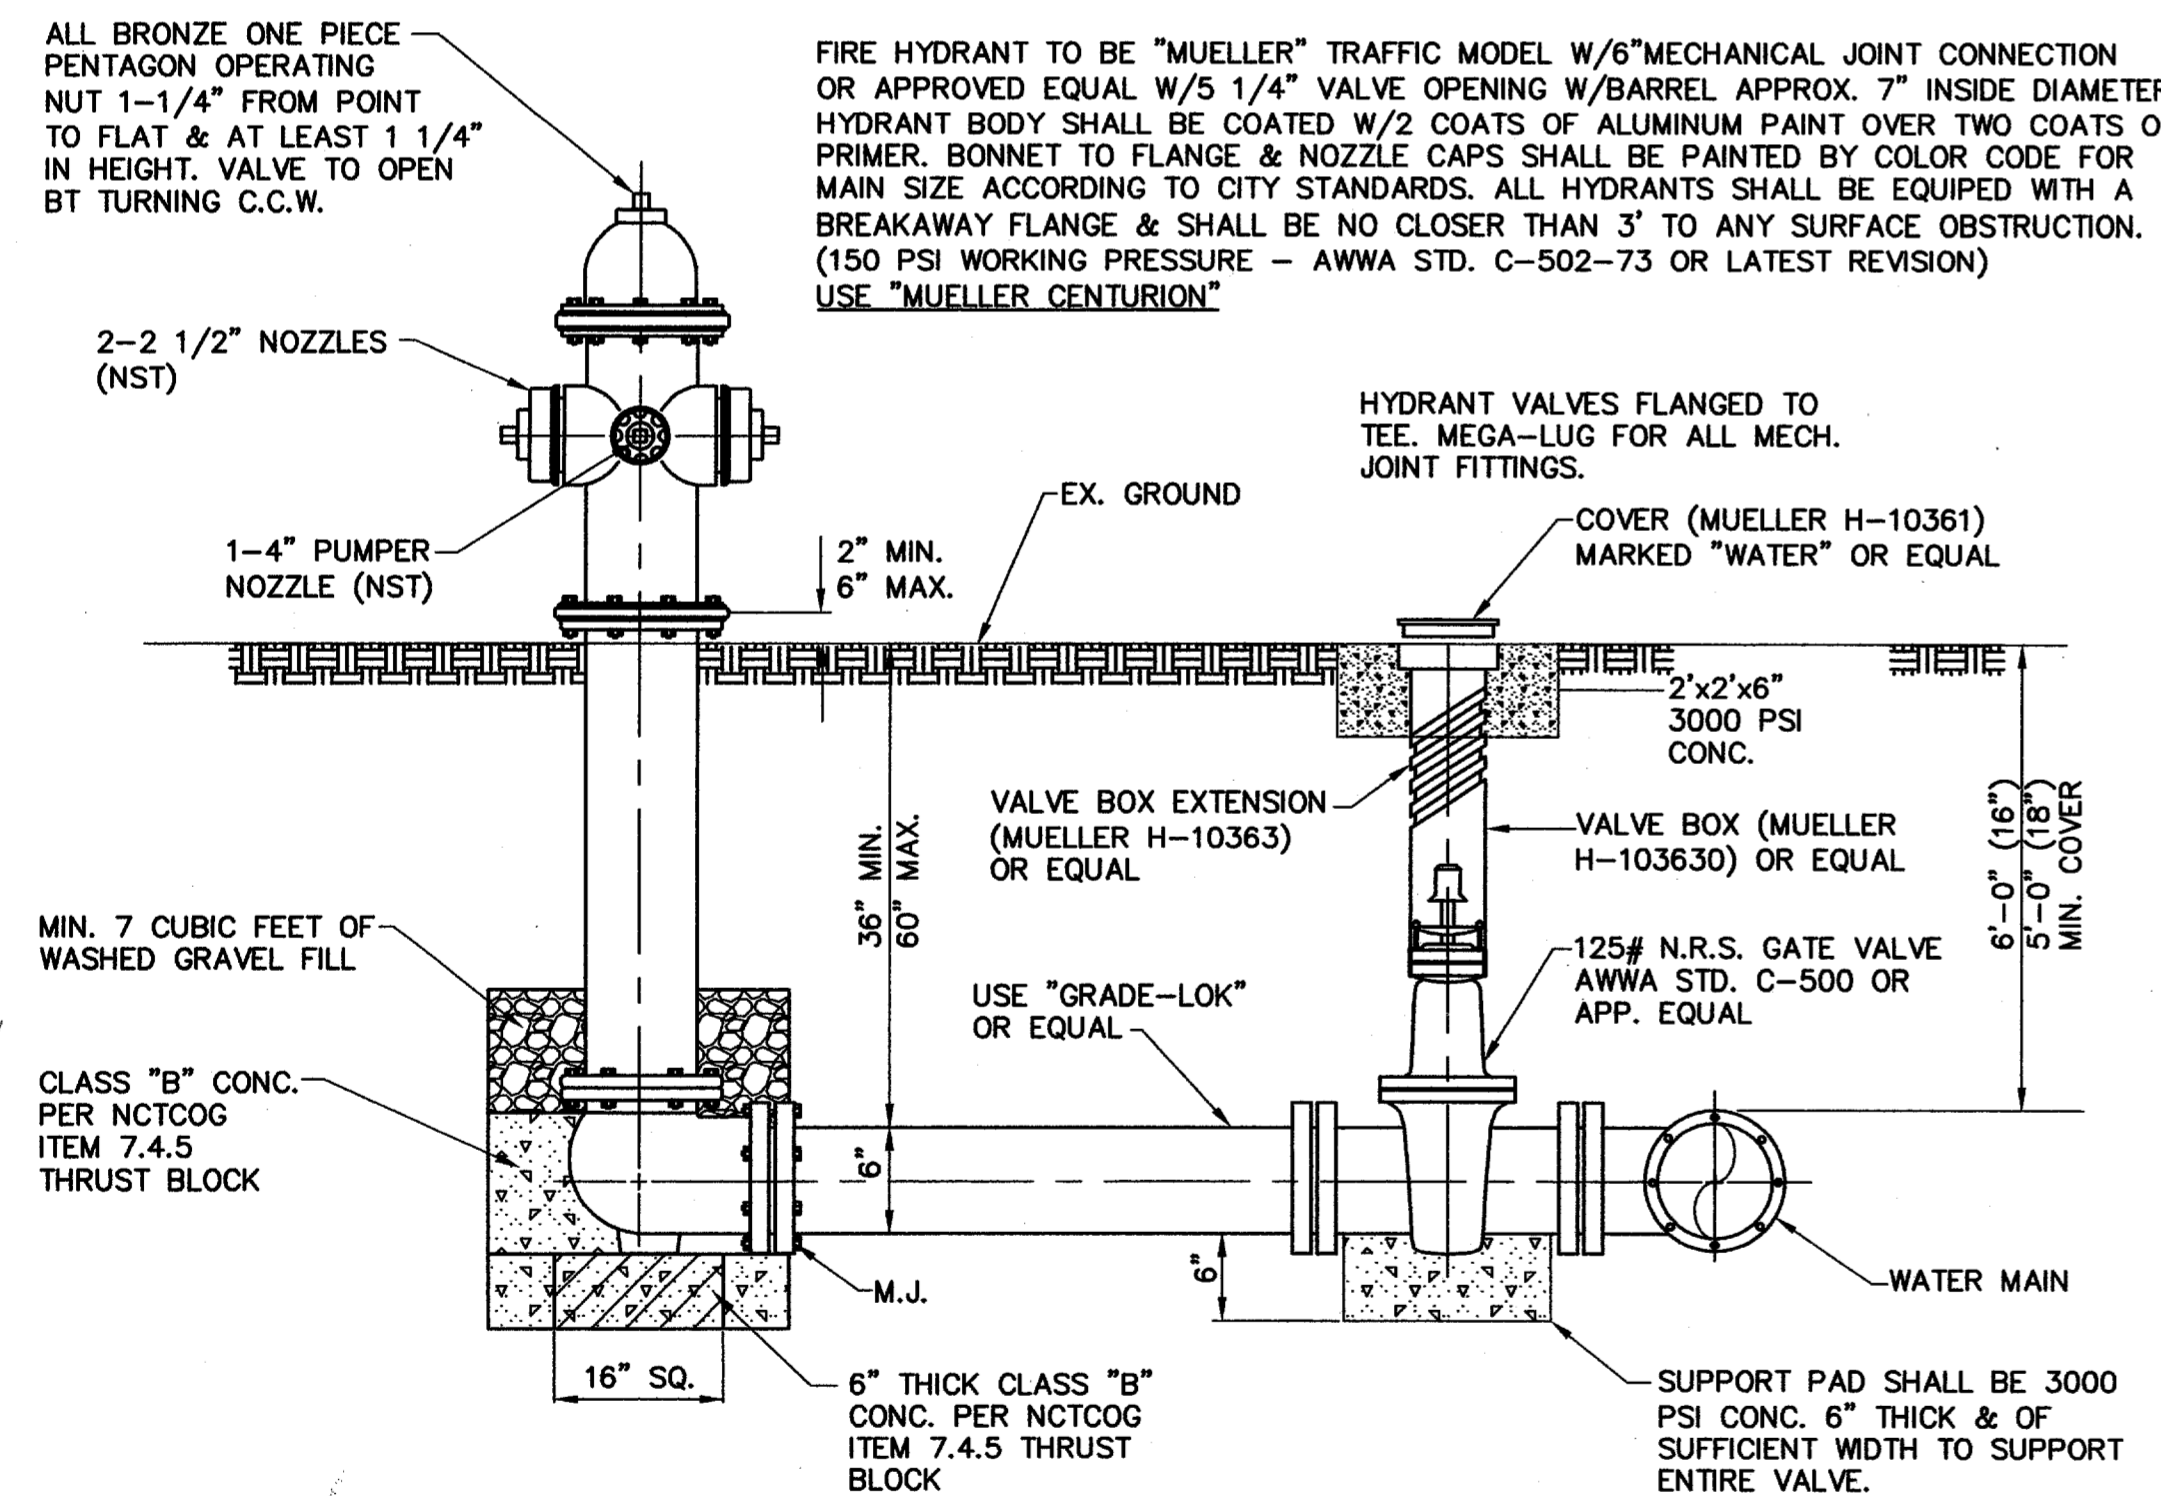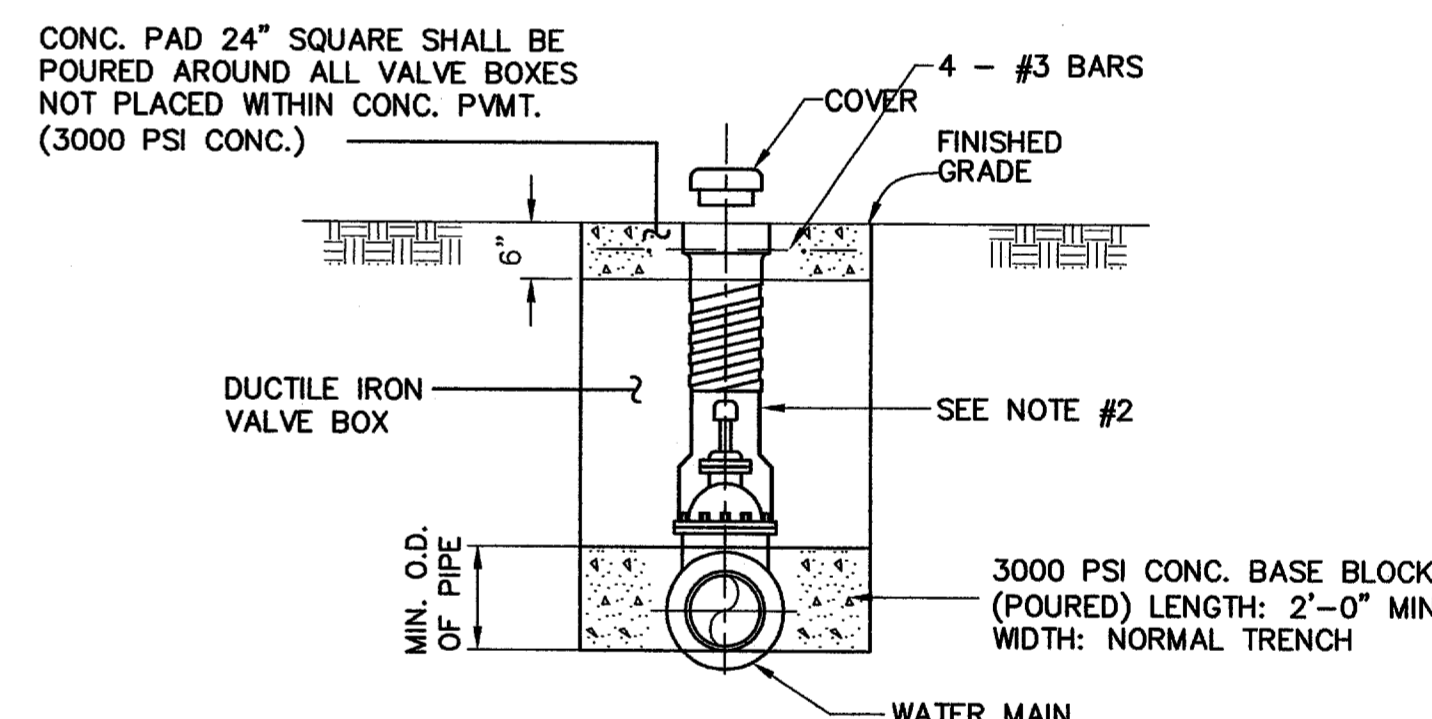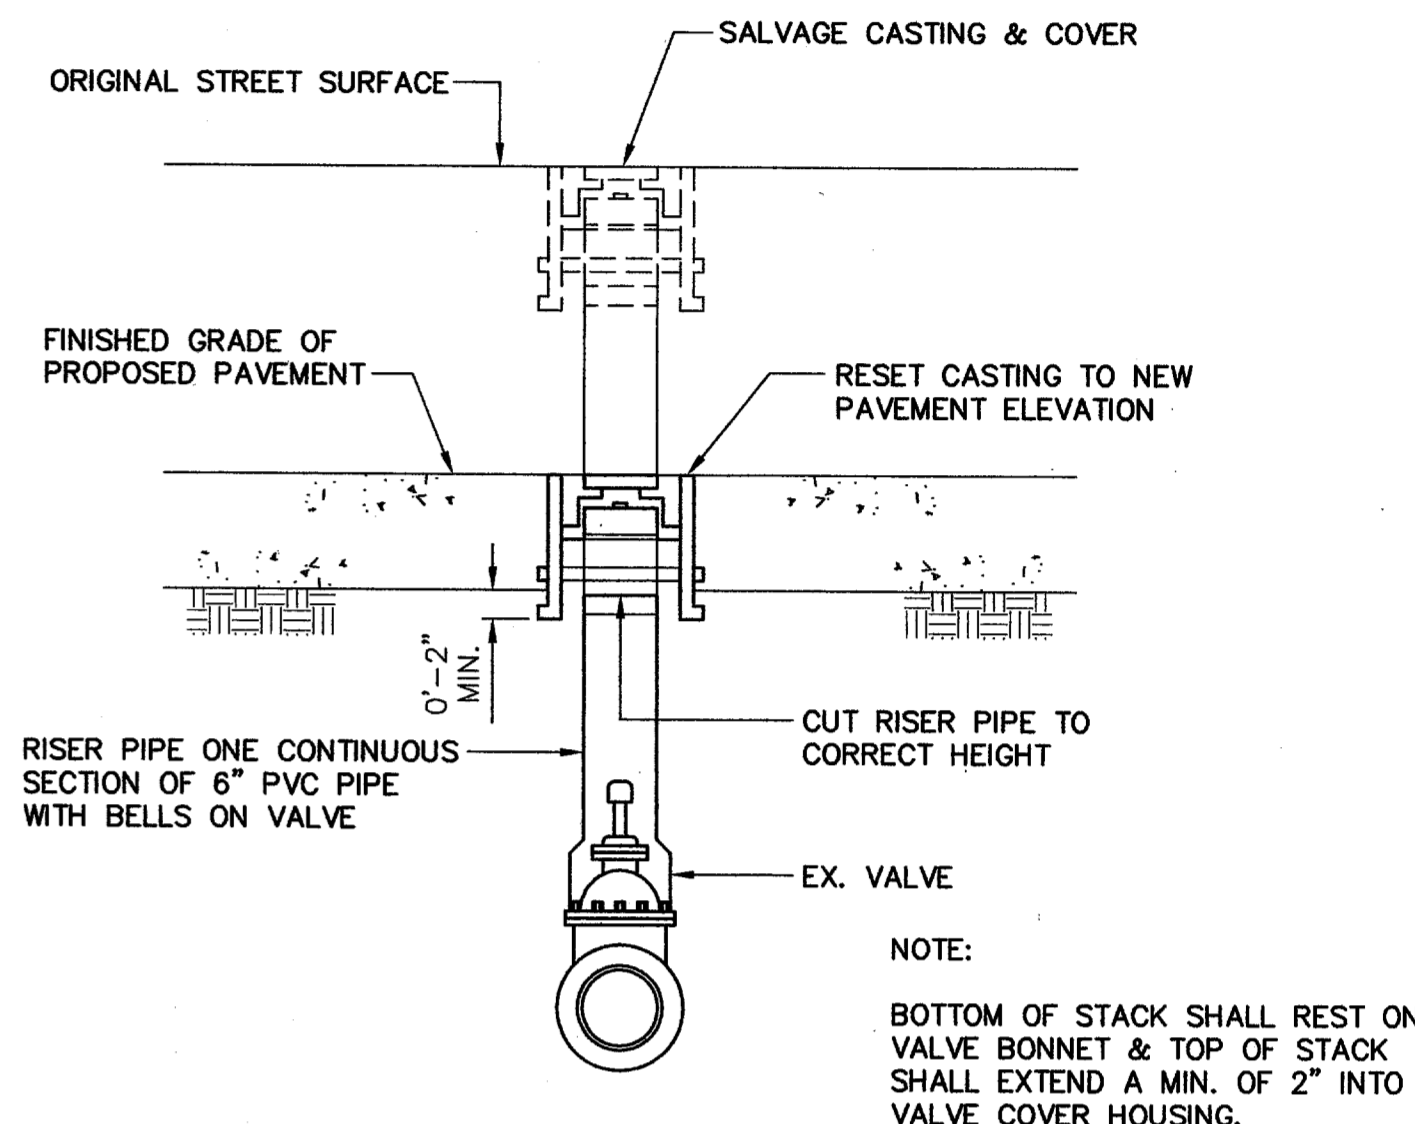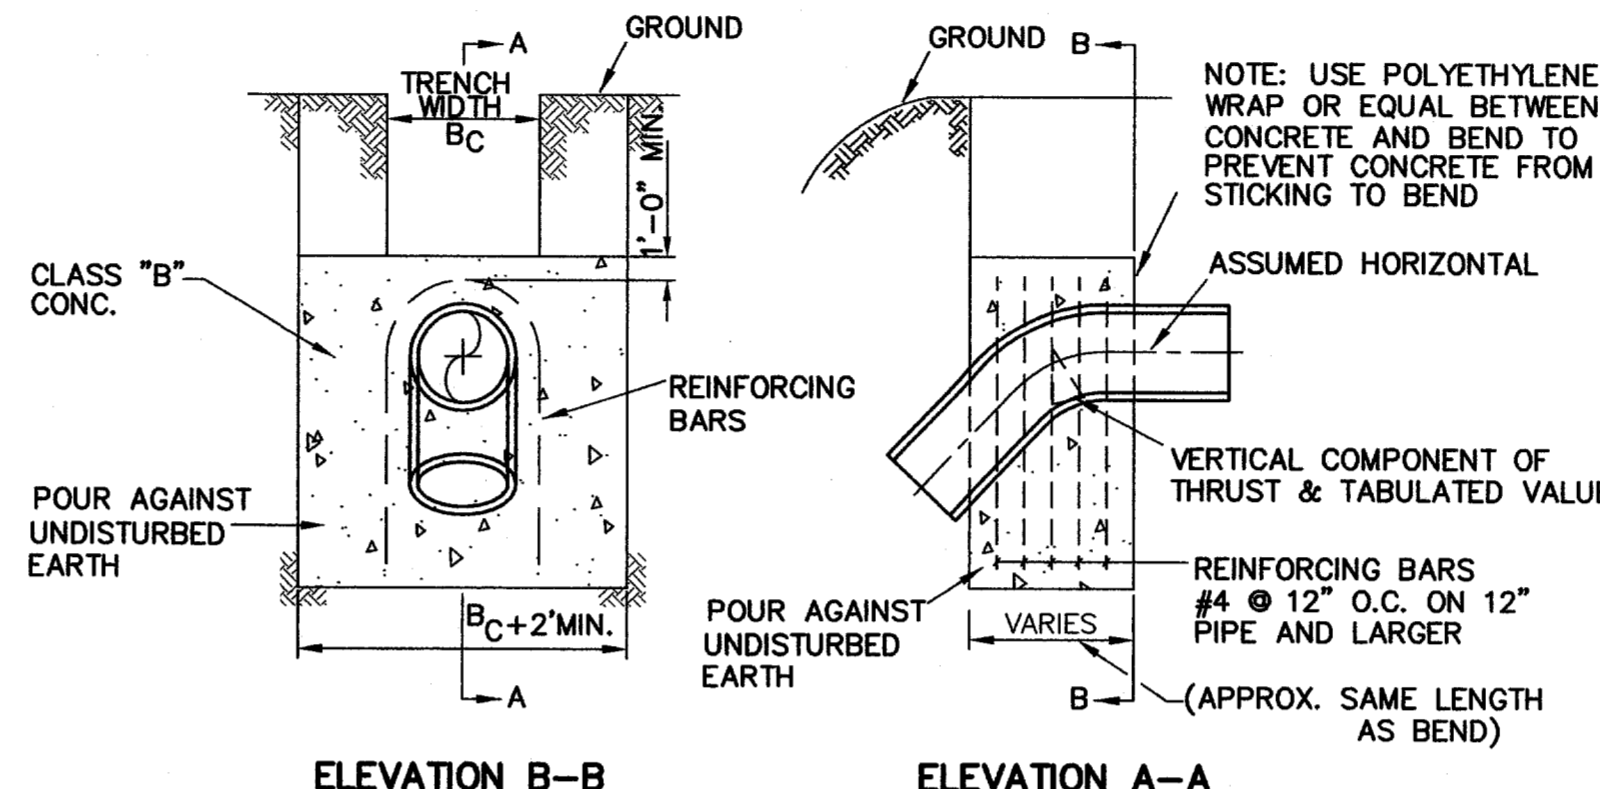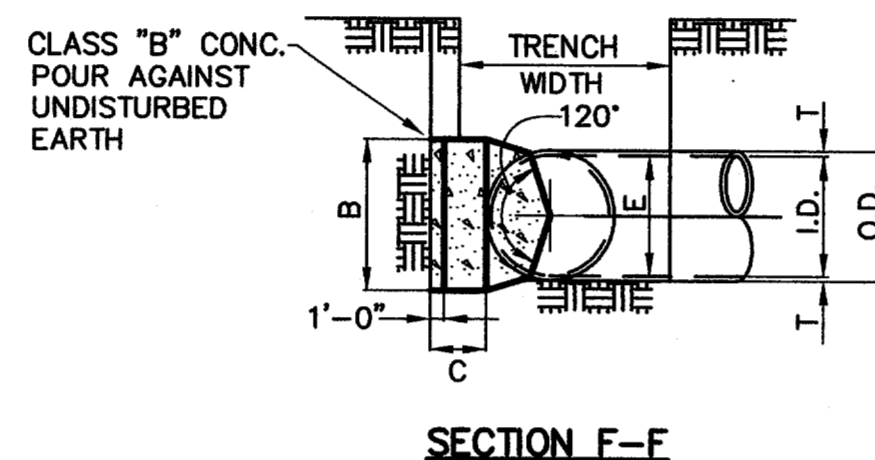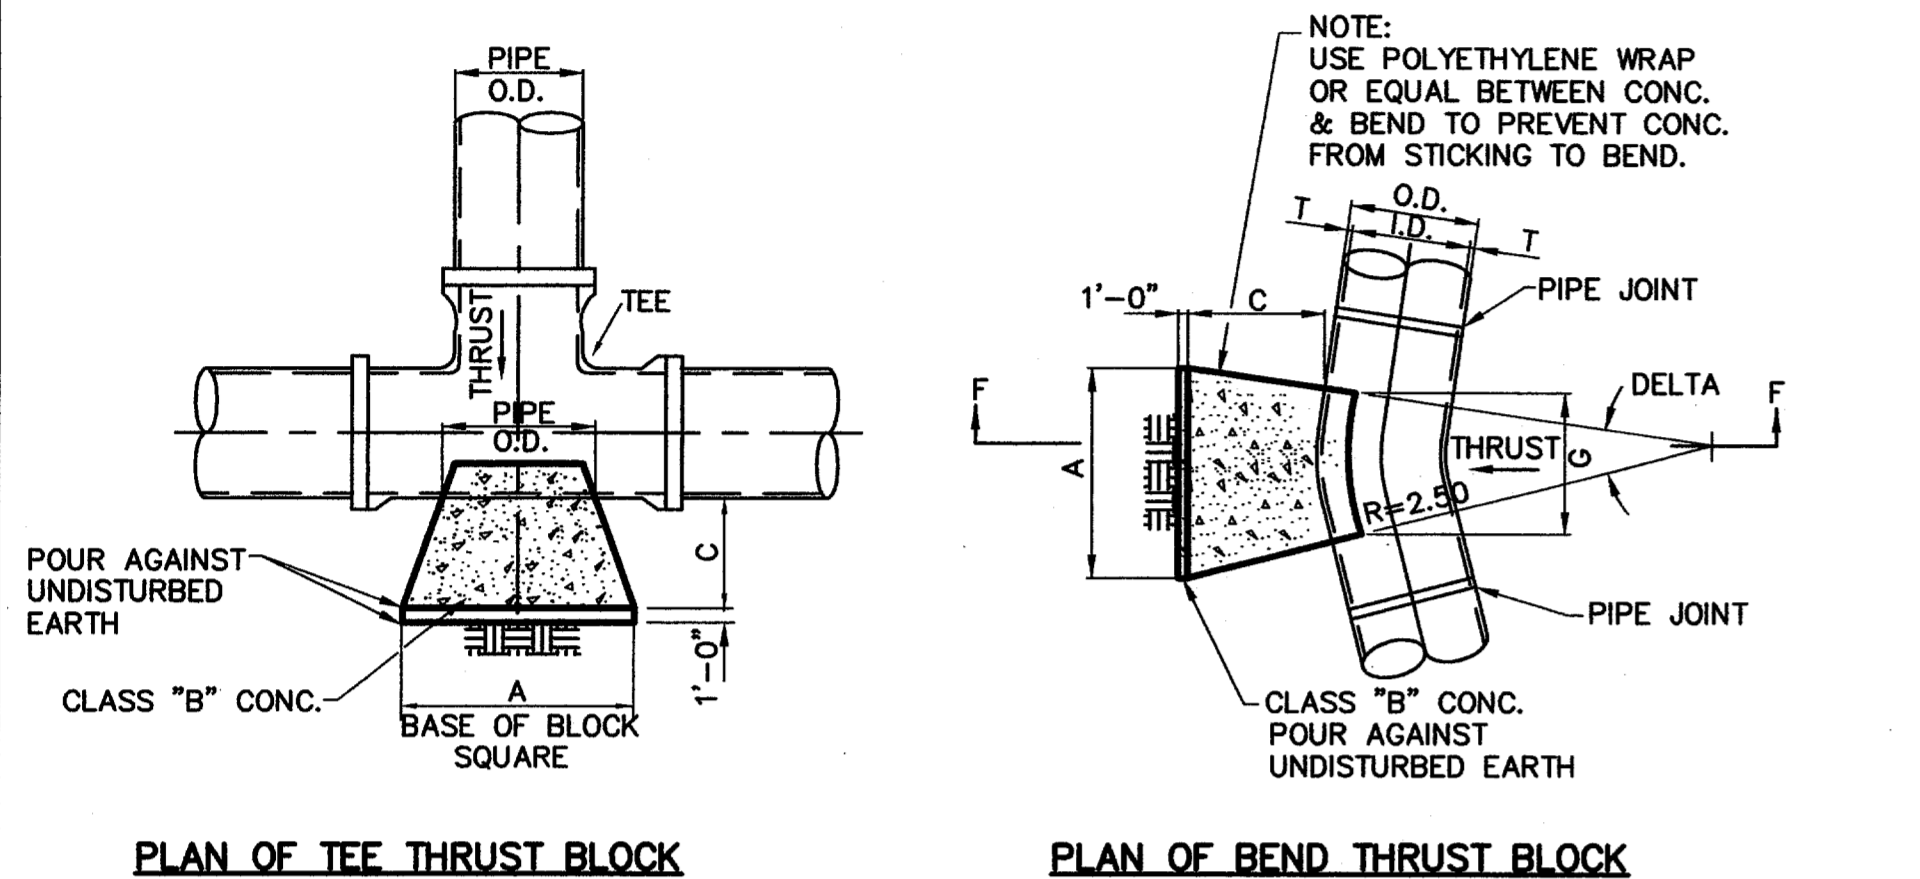

- GENERAL NOTES**
1. POLYVINYL CHLORIDE (PVC) WATER PIPE SHALL MEET OR EXCEED REQUIREMENTS OF AWWA C909 PVC PIPE WITH CAST IRON OUTSIDE DIMENSIONS. PIPE SHALL BE APPROVED FOR USE IN CITIES AND TOWNS OF THE STATE OF TEXAS BY THE STATE BOARD OF INSURANCE.
  2. PVC WATER PIPE SHALL BE FURNISHED WITH A RUBBER RING AT EACH JOINT AND INTEGRAL THICKENED BELL AS A PART OF EACH JOINT. THE PIPE CLASS SHALL BE MINIMUM CLASS 150 DR 18 WHICH REFERS TO THE MAXIMUM HYDROSTATIC PRESSURE IN NORMAL OPERATIONS. LAYING LENGTHS SHALL BE 20 FEET +/- PIPE AND FITTINGS MUST BE ASSEMBLED WITH A NONTOXIC LUBRICANT.
  3. FITTINGS FOR PVC WATER PIPE SHALL BE GRAY IRON OR DUCTILE IRON OF THE BELL AND SPIGOT OR MECHANICAL JOINT TYPE AND SHALL BE CLASS 250 IN ACCORDANCE WITH AWWA C110-77 (ANSI.10)
  4. UNLESS OTHERWISE SPECIFIED ON PLANS OR SHOWN IN PROFILES, PVC WATER PIPE SHALL BE INSTALLED TO CLEAR ALL UTILITY LINES AND SHALL HAVE A MINIMUM COVER OF 36 INCHES BELOW THE LOWEST GRADE OF THE STREET AS PER CITY CODE.
  5. 4"-12" RS GATE VALVES SHALL BE IN ACCORDANCE WITH AWWA STANDARD C-500.
  6. A PERMANENTLY ATTACHED VALVE EXTENSION STEM SHALL BE REQUIRED FOR ANY VALVE WHOSE OPERATING NUT IS LOCATED IN EXCESS OF 4 FEET BELOW THE TOP OF VALVE BOX. THIS EXTENSION SHALL BE OF SUFFICIENT LENGTH TO INSURE THAT ITS TOP IS WITHIN 4' OF VALVE BOX LID.
  7. DUCTILE IRON OR C-900 PVC PIPE SHALL BE USED FOR VALVE STACKS WITH VALVE BOX CASTING.
  8. ALL ANCHOR BOLTS SHALL BE GALVANIZED.
  9. ALL WATER MAINS WILL BE INSTALLED WITH A LOCATION WIRE PER THE TOWN OF ADDISON REQUIREMENTS.
  10. POLYWRAP ALL IRON FITTINGS AND VALVES.

- GENERAL NOTES:**
1. CL OF FIRE HYDRANT BARREL SHALL BE NOT LESS THAN 6.0' OR MORE THAN 9.0' FROM BACK OF CURB OR EDGE OF DRIVING LANE.
  2. DO NOT SET FIRE HYDRANT IN AN EXISTING OR PROPOSED SIDEWALK, UNLESS OTHERWISE NOTED.
  3. ALL FIRE HYDRANT TEES SHALL BE FLANGED TEE WITH ANCHORING ON THE BRANCH WITH FLANGED x M.J., M.J. 6" VALVE.
  4. SET FIRE HYDRANT ON THE LOT LINE EXTENDED WHEN POSSIBLE. (NOT APPLICABLE TO THIS PROJECT)
  5. SEE SPECIFICATION FH-95-1 FOR ADDITIONAL REQUIREMENTS.
- GATE VALVES AND VALVE BOXES:**
1. GATE VALVES SHALL BE IRON BODY, BRONZE OR BRASS MOUNTED, NON-RISING STEM, RESILIENT WEDGE TYPE (SUCH AS MUELLER A-2360). VALVES SHALL BE OF EQUAL OR GREATER PRESSURE CLASS THAN THE PIPING IN WHICH THEY ARE TO BE INSTALLED.
  2. VALVE BOXES SHALL BE CAST IRON AND SHALL BE OF SUFFICIENT LENGTH AND DIAMETER TO OPERATE ALL VALVES BURIED IN THE GROUND. COVERS SHALL BE MARKED "WATER". THE BOXES SHALL REST ON THE VALVE AND BE ADJUSTED SO THAT THE COVER MAY SET FLUSH WITH THE FINISHED GRADE.
  3. VALVE DEPTH GREATER THAN 4 FEET REQUIRES VALVE EXTENSION STEM.

**TYPICAL FIRE HYDRANT INSTALLATION**  
N.T.S.


**WATER DETAILS**  
PARKVIEW AT ADDISON CIRCLE  
TOWN OF ADDISON, TEXAS  
DALLAS COUNTY

**BROCKETTE · DAVIS · DRAKE, inc.**  
consulting engineers  
Civil & Structural Engineering · Surveying  
4144 North Central Expressway, Suite 1100 Dallas, Texas 75204  
(214)824-3647, fax (214) 824-7064

DESIGNED	DRAWN	DATE	SCALE	NOTES	FILE	NO.
RRJ	BDD	04/04	AS SHOWN	BDD	C03393	C33

**AS-BUILT**  
NOVEMBER 4, 2004

NOTE: THESE PLANS HAVE BEEN REVISED TO CONFORM WITH CONSTRUCTION RECORDS PROVIDED BY CONTRACTOR.

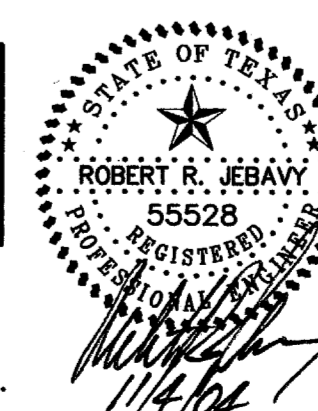

Copyright 2003 Brockette/Davis/Drake, Inc. All Rights Reserved. This drawing is the property of Brockette/Davis/Drake, Inc. Any modification or use of this drawing without the express written authorization of Brockette/Davis/Drake, Inc. is prohibited.

C03393 PLANS CD 33-WATER-DET-PV.DWG