


SANITARY SEWER SERVICE CONNECTION
N.T.S.

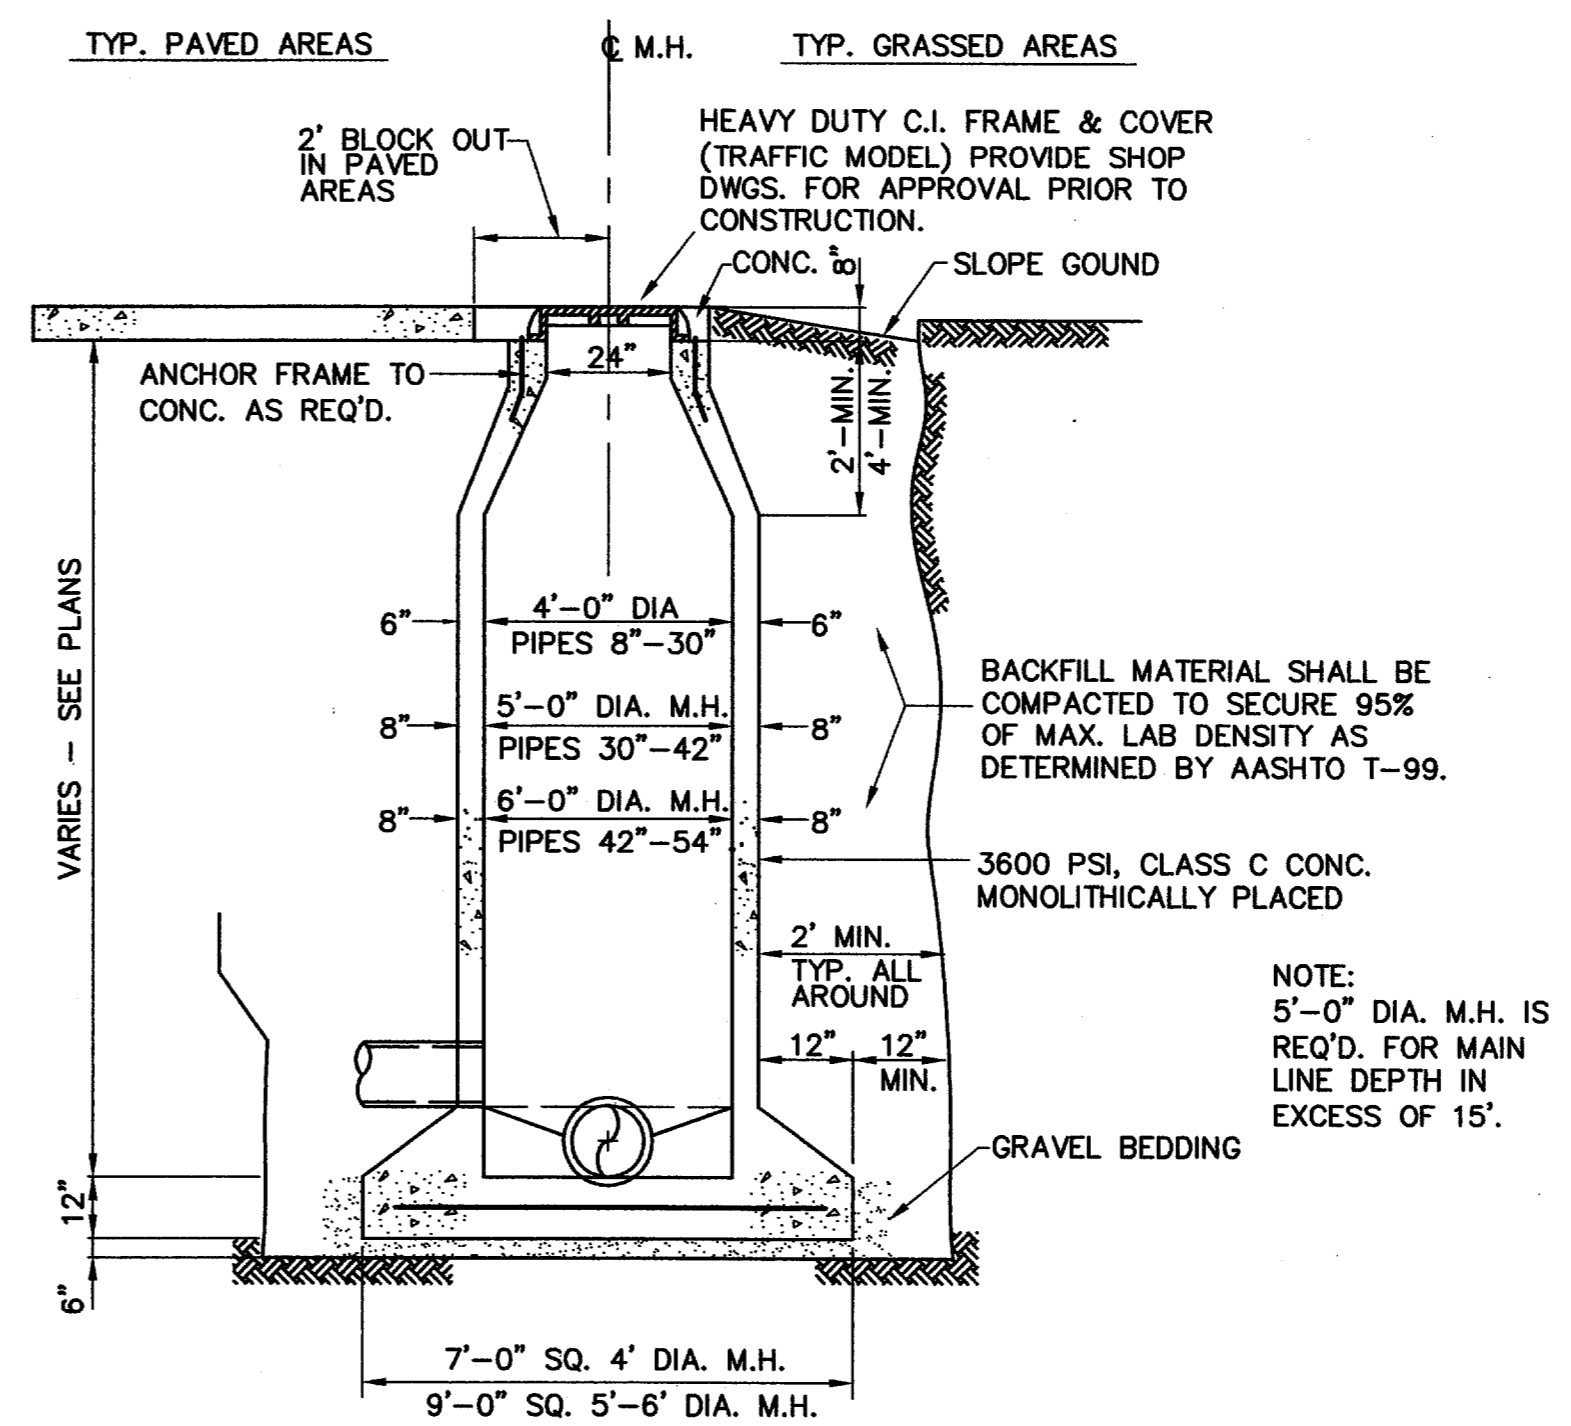


CAST-IN-PLACE MANHOLE
N.T.S.

WHERE DROP M.H. IS REQ'D. USE INSIDE DROP CONNECTION AS PER TOWN OF ADDISON STANDARDS.

AS-BUILT
NOVEMBER 4, 2004

NOTE: THESE PLANS HAVE BEEN REVISED TO CONFORM WITH CONSTRUCTION RECORDS PROVIDED BY CONTRACTOR.

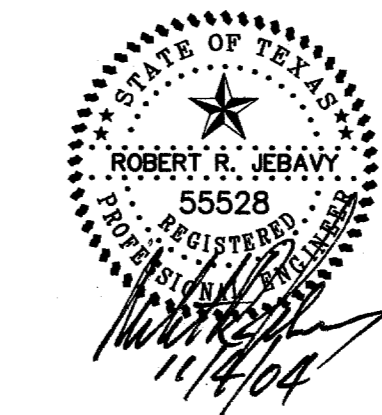

WASTEWATER DETAILS
PARKVIEW AT ADDISON PLACE
TOWN OF ADDISON, TEXAS
DALLAS COUNTY

BROCKETTE · DAVIS · DRAKE , inc.
consulting engineers
Civil & Structural Engineering · Surveying
4144 North Central Expressway, Suite 1100 Dallas, Texas 75204
(214)824-3647, fax (214) 824-7064

DESIGNED	DRAWN	DATE	SCALE	NOTES	FILE	NO.
RRJ	BDD	04/04	AS SHOWN	BDD	C03393	C34

Copyright © 2003 Brockette/Davis/Drake, Inc. All Rights Reserved. This drawing is the property of Brockette/Davis/Drake, Inc. Any modification or use of this drawing without the express written authorization of Brockette/Davis/Drake, Inc. is prohibited.

CO3393/PLANS CD 34-WW-BE-FV.DWG