



15 - 5" OR 6"  
TERMINATOR INSTALLATION  
IN MANHOLES  
SEE JOB SKETCH FOR  
NUMBER OF TERMINATORS  
TO BE INSTALLED  
DETAIL # 8

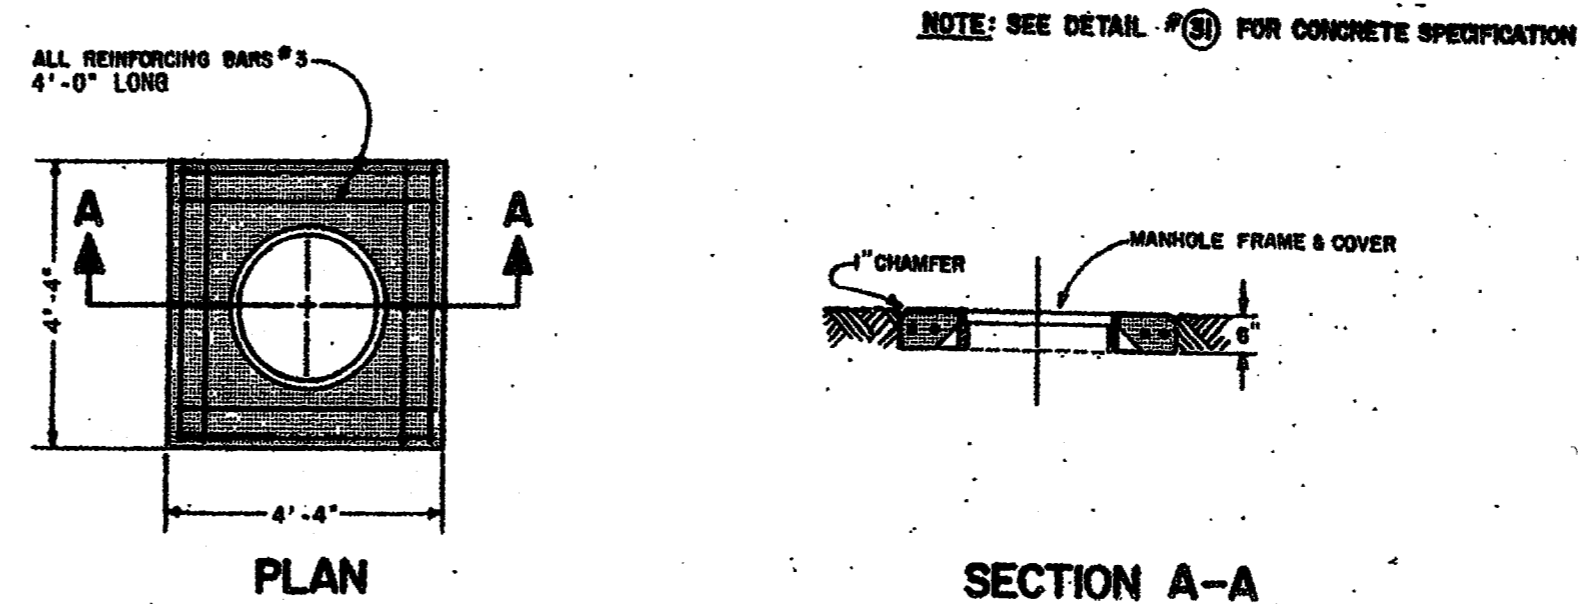


CONCRETE SLAB FOR MANHOLE  
CASTING  
DETAIL # 11

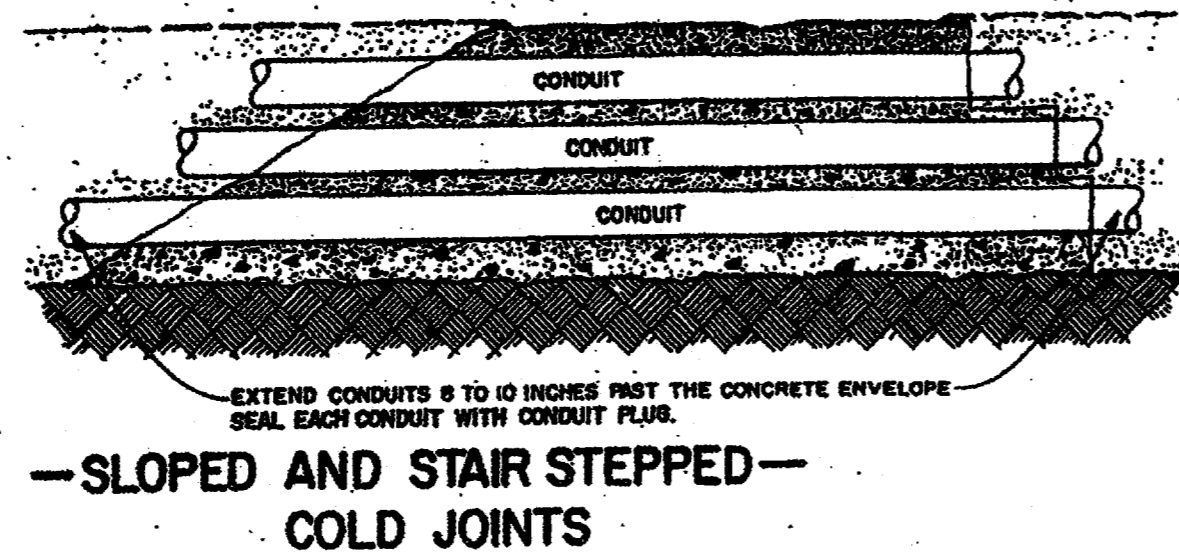

DETAIL # 24

--SLOPED AND STAIR STEPPED--  
COLD JOINTS

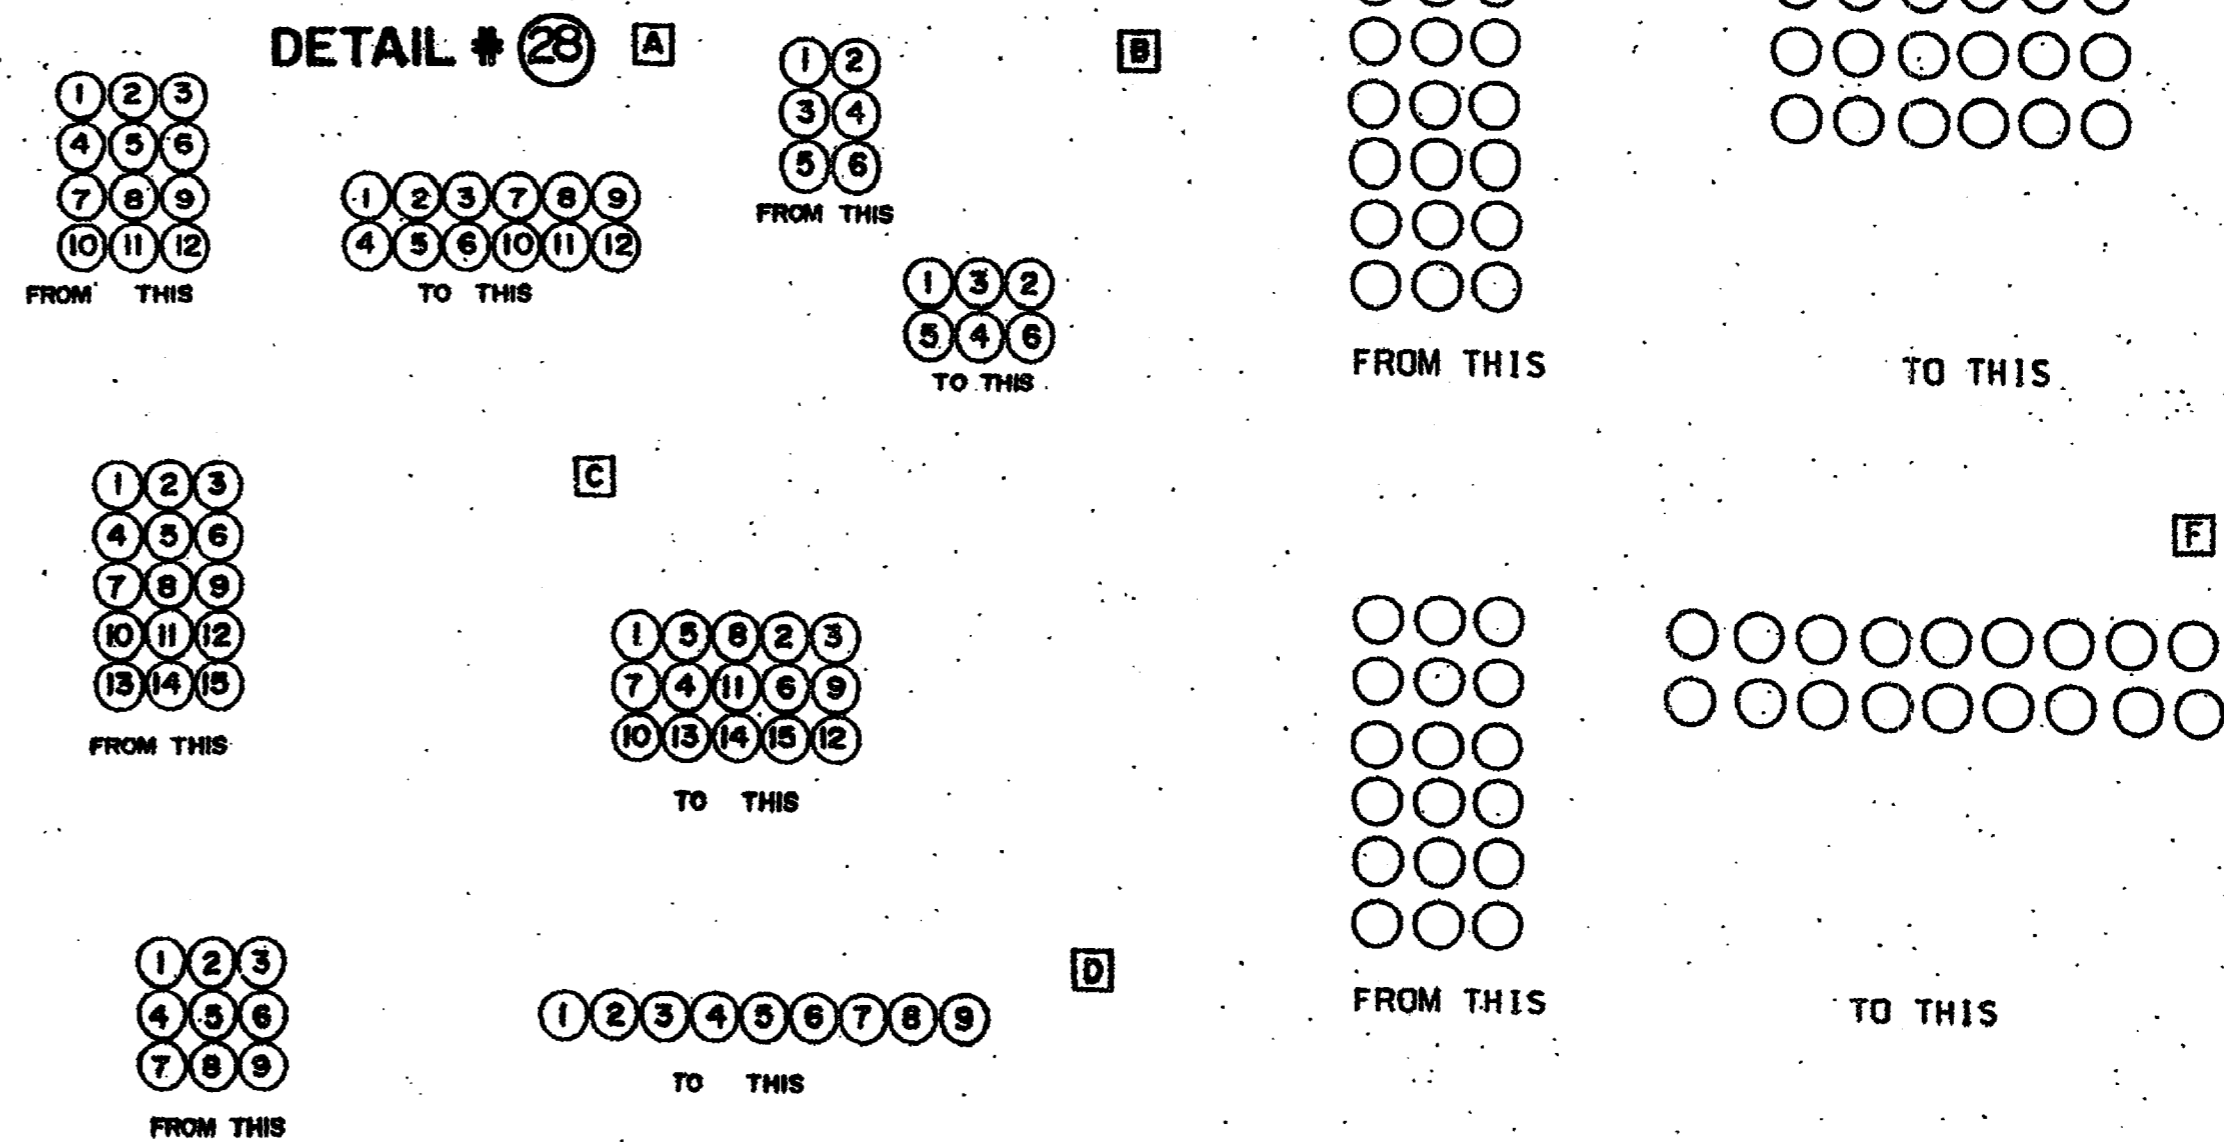

CONDUIT TRANSITION DETAILS

**AS-BUILT**  
NOVEMBER 4, 2004

NOTE:  
THESE PLANS HAVE BEEN REVISED  
TO CONFORM WITH CONSTRUCTION  
RECORDS PROVIDED BY CONTRACTOR.

TU ELECTRIC		CD
SCALE (H&O SCALE) (V&O SCALE)	UNIT ID	APR.
ESTIMATE	DWG TYPE	APR.
W.A.	REVISION DESCRIPTION	CH.
DATE	NO.	DATE
W.A.	NO.	DATE
APP. PRN	APP. JES	APP. PRN
ENG. JRC	ENG. JRC	ENG. JRC
DWN. MED	CH. JRC	CH. JRC
DATE 05-12-92		
NETWORK UNDERGROUND APPURTENANCE SHEETS MISCELLANEOUS DETAILS		
E-NUA-1		
SHEET NO.		

©Copyright 2003 Brockette/Davis/Drake, Inc. All Rights Reserved.  
This drawing is the property of Brockette/Davis/Drake, Inc.  
and its use is restricted to the project and location  
indicated. Any reproduction or use of this drawing  
without the written permission of Brockette/Davis/Drake, Inc. is prohibited.