
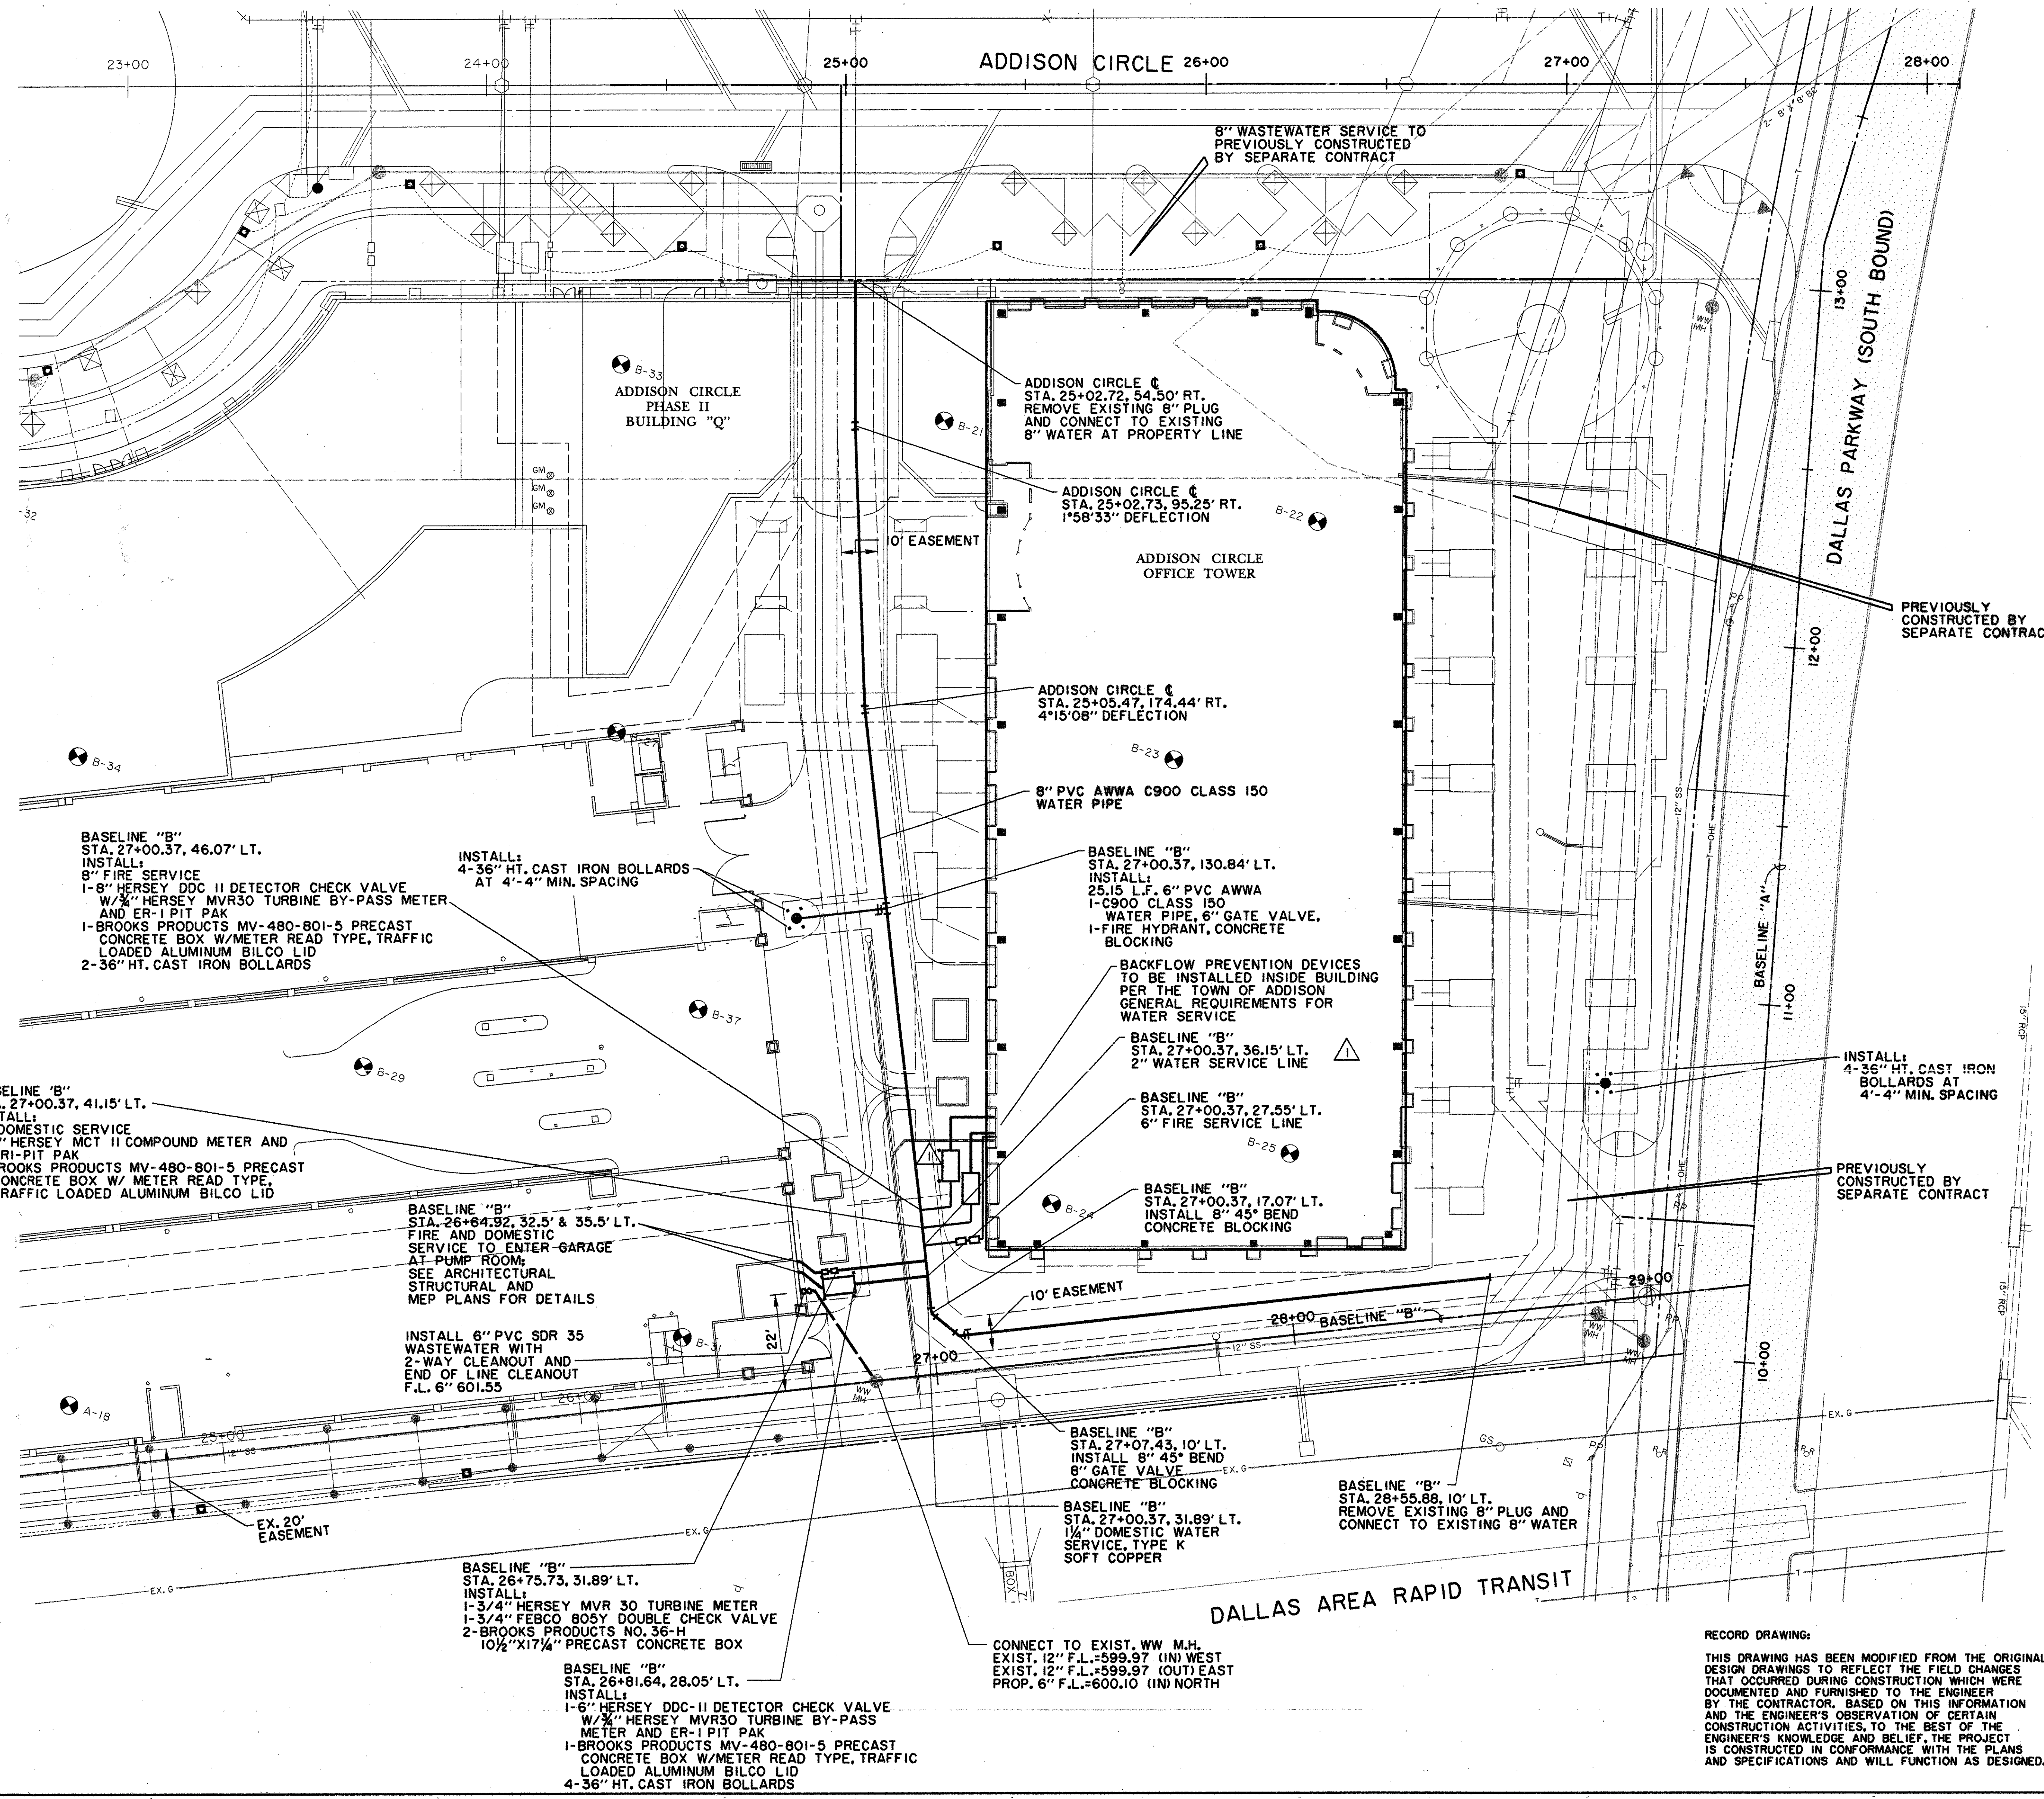



ADDISON CIRCLE  
OFFICE BUILDING  
ADDISON TEXAS

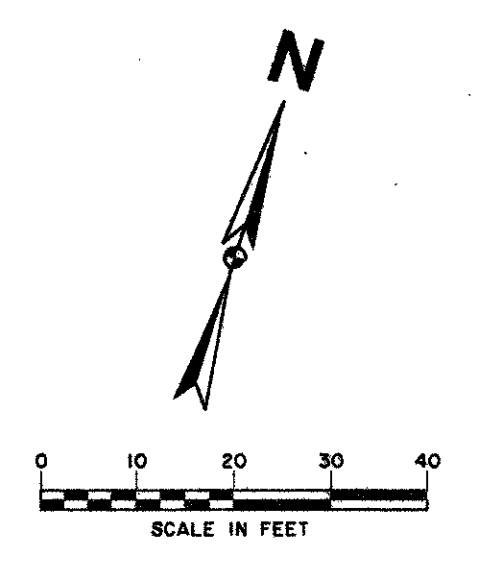

ALL INFORMATION ON THIS DRAWING IS THE PROPERTY OF HKS, INC. AND IS TO BE USED ONLY FOR THE PROJECT AND SITE SPECIFICALLY IDENTIFIED HEREON. NO PART OF THIS DRAWING IS TO BE REPRODUCED OR TRANSMITTED IN ANY FORM OR BY ANY MEANS, ELECTRONIC OR MECHANICAL, INCLUDING PHOTOCOPYING, RECORDING, OR BY ANY INFORMATION STORAGE AND RETRIEVAL SYSTEM, WITHOUT THE WRITTEN PERMISSION OF HKS, INC.

PROGRESSIVE DAVIS BRACE & CO.  
 Consulting Engineers  
 4001 Ross Avenue, Suite 1000  
 Dallas, Texas 75204-1200  
 (214) 750-1200

HUITT-ZOLLARS, INC.  
 3131 McKinney Ave., Suite 600  
 Dallas, TX 75204 (214) 871-3111

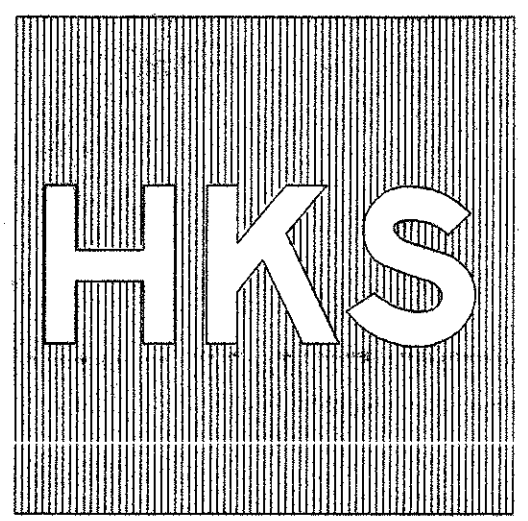


HKS Inc. Architects-Engineers-Planners  
 700 W. Peach, Suite 1100, LB 307  
 Dallas, Texas 75201-7465 (214) 969-5599

Job No: 5494  
 ISSUED FOR CONSTRUCTION

15 OCT. 1997

RECORD DRAWING  
 12/4/98  
 ADDED COOLING TOWER  
 SERVICE LINE; SHIFTED  
 VAULTS & BOLLARDS  
 1/16/98

Revisions:  
 Date:  
 Sheet Title:  
**WATER & WASTEWATER PLAN**  
 Sheet No:  
**C7**

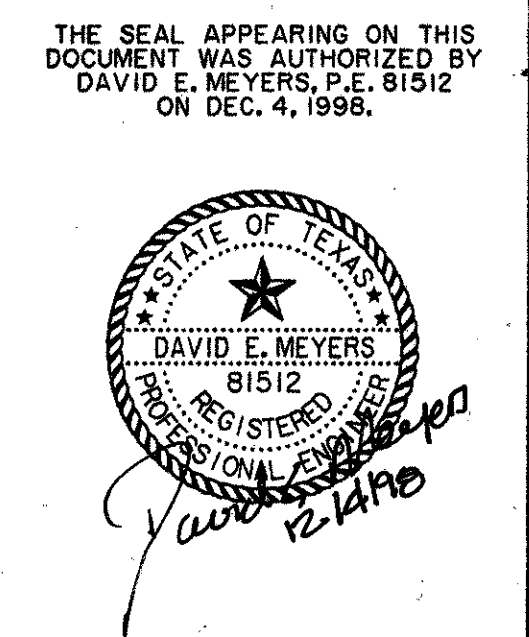

**BENCHMARKS:**  
 BM#5  
 '1' CUT AT NORTHWEST CORNER  
 OF NORTH HDWL. OF 7'X7' BOX  
 CULVERT UNDER RAILROAD,  
 180' WEST OF DALLAS  
 PARKWAY SOUTHBOUND,  
 ELEV. 610.49  
 BM#6  
 '1' CUT AT CENTER FRONT OF  
 18' REC. INLET, SECOND INLET  
 NORTH OF RAILROAD TRACKS  
 ON THE WEST SIDE OF DALLAS  
 PARKWAY SOUTHBOUND,  
 ELEV. 605.67

**RECORD DRAWING:**  
 THIS DRAWING HAS BEEN MODIFIED FROM THE ORIGINAL  
 DESIGN DRAWINGS TO REFLECT THE FIELD CHANGES  
 THAT OCCURRED DURING CONSTRUCTION WHICH WERE  
 DOCUMENTED AND FURNISHED TO THE ENGINEER  
 BY THE CONTRACTOR. BASED ON THIS INFORMATION  
 AND THE ENGINEER'S OBSERVATION OF CERTAIN  
 CONSTRUCTION ACTIVITIES, TO THE BEST OF THE  
 ENGINEER'S KNOWLEDGE AND BELIEF, THE PROJECT  
 IS CONSTRUCTED IN CONFORMANCE WITH THE PLANS  
 AND SPECIFICATIONS AND WILL FUNCTION AS DESIGNED.

23 JUN 97  
 24 JUN 97  
 25 JUN 97  
 26 JUN 97  
 27 JUN 97  
 28 JUN 97  
 29 JUN 97  
 30 JUN 97