



LIGHT FIXTURE SCHEDULE

TYPE	BRAND	MODEL NO.	DESCRIPTION	LAMP	VOLTAGE	LOCATION
A	KIM	CFL/50MH120/DB-P	SURFACE MOUNTED METAL HALIDE FLOOD LIGHT, BLACK POLYESTER POWDER COAT FINISH, 1/2 CYLINDER SHAPE 10-1/2"Ø	1-50W CLEAR METAL HALIDE	120V	ON ROOF
A-1	KIM	AFL-1/175MH120/DB-P	SURFACE MOUNTED METAL HALIDE FLOOD LIGHT, BLACK POLYESTER POWDER COAT FINISH, 1/2 CYLINDER SHAPE 14"x10-3/4"	1-175W CLEAR METAL HALIDE	120V	ON ROOF
B	NOT USED					
C	COLUMBIA	4PS14232G RA A12 EBB	RECESSED FLUORESCENT 1x4 WITH ACRYLIC LENS, FOR INSTALLATION IN 2x4 LAY-IN CEILING. REGRESSED ALUMINUM FRAME, WITH ELECTRONIC BALLAST.	2-F32T8	120V	KITCHEN
C-1	COLUMBIA	4PS14132G RA A12 EBB	SIMILAR TO TYPE C, EXCEPT FOR ONE LAMP WIDE.	1-F32T8	120V	KITCHEN
D	NOT USED					
E	NOT USED					
F	HUBBELL	232B	SURFACE MOUNTED FLUORESCENT STRIP, 2 LAMPS WIDE 4'-0" LONG, ELECTRONIC BALLAST, WITH WIRE GUARD.	2-F32T8	120V	ELECTRIC ROOM
G	NOT USED					
H	NOT USED					
I	NOT USED					
J	NOT USED					
K	ALERA	CL12118F WCB EBB	RECESSED CONTINUOUS FLUORESCENT, 1'-0" WIDE, LENGTH AS SHOWN ON DRAWINGS, WITH 1" WHITE BLADE LOUVER, 1" O.C.	1-32W T8 PER 4'-0" ELECTRONIC BALLAST	120V	TOILET
L	KIM	WF20P70MMH120 BL-P	SURFACE MOUNTED METAL HALIDE WITH PRISMED LENS. BLACK FINISH ON METAL HOUSING.	1-70W METAL HALIDE	120V	PAVILION
L-1	KIM	WF20P32PLWH-P	SIMILAR TO TYPE L EXCEPT FOR WHITE PAINT FINISH AND FLUORESCENT LAMPS.	32W PL	120V	KITCHEN TOILET
M	PRESCOLITE	#HCRW08BL	BRACKET MOUNTED METAL HALIDE DOWNLIGHT, WITH SPECULAR CLEAR ALZAK REFLECTOR, 8", 13-3/8"HT. BLACK FINISH	1-100W ED17 METAL HALIDE	120V	ATM MACHINES

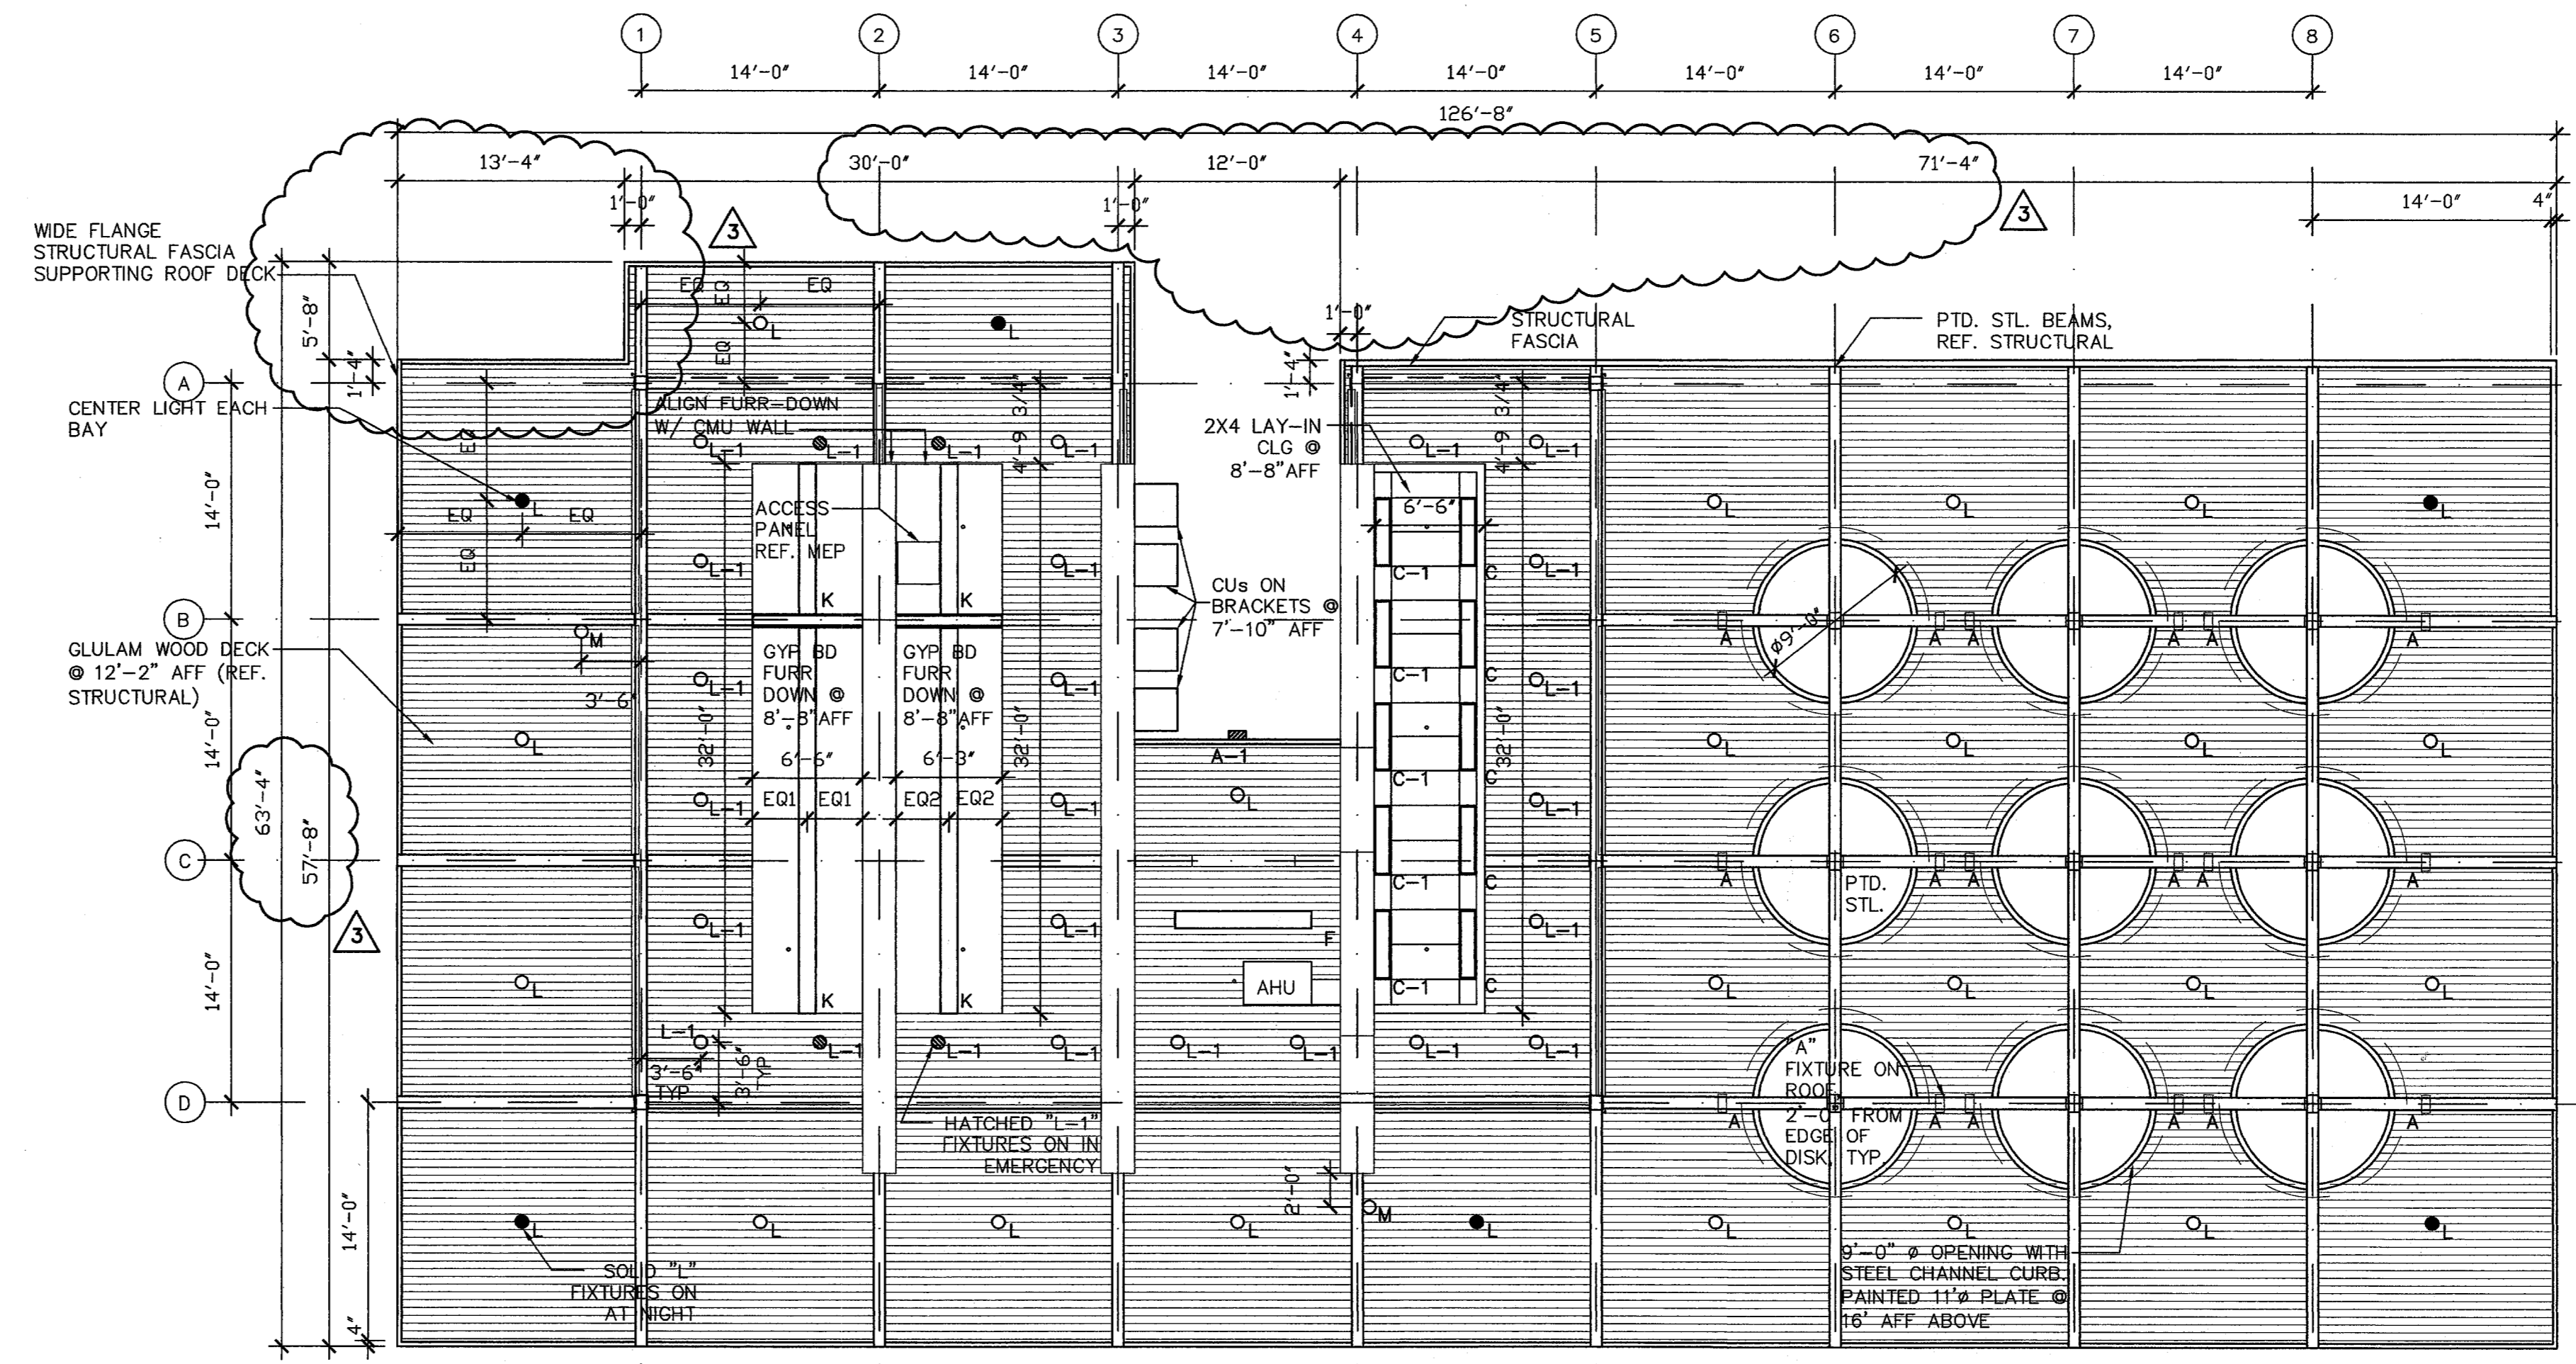

2 REFLECTED CEILING PLAN


1/8"=1'-0"

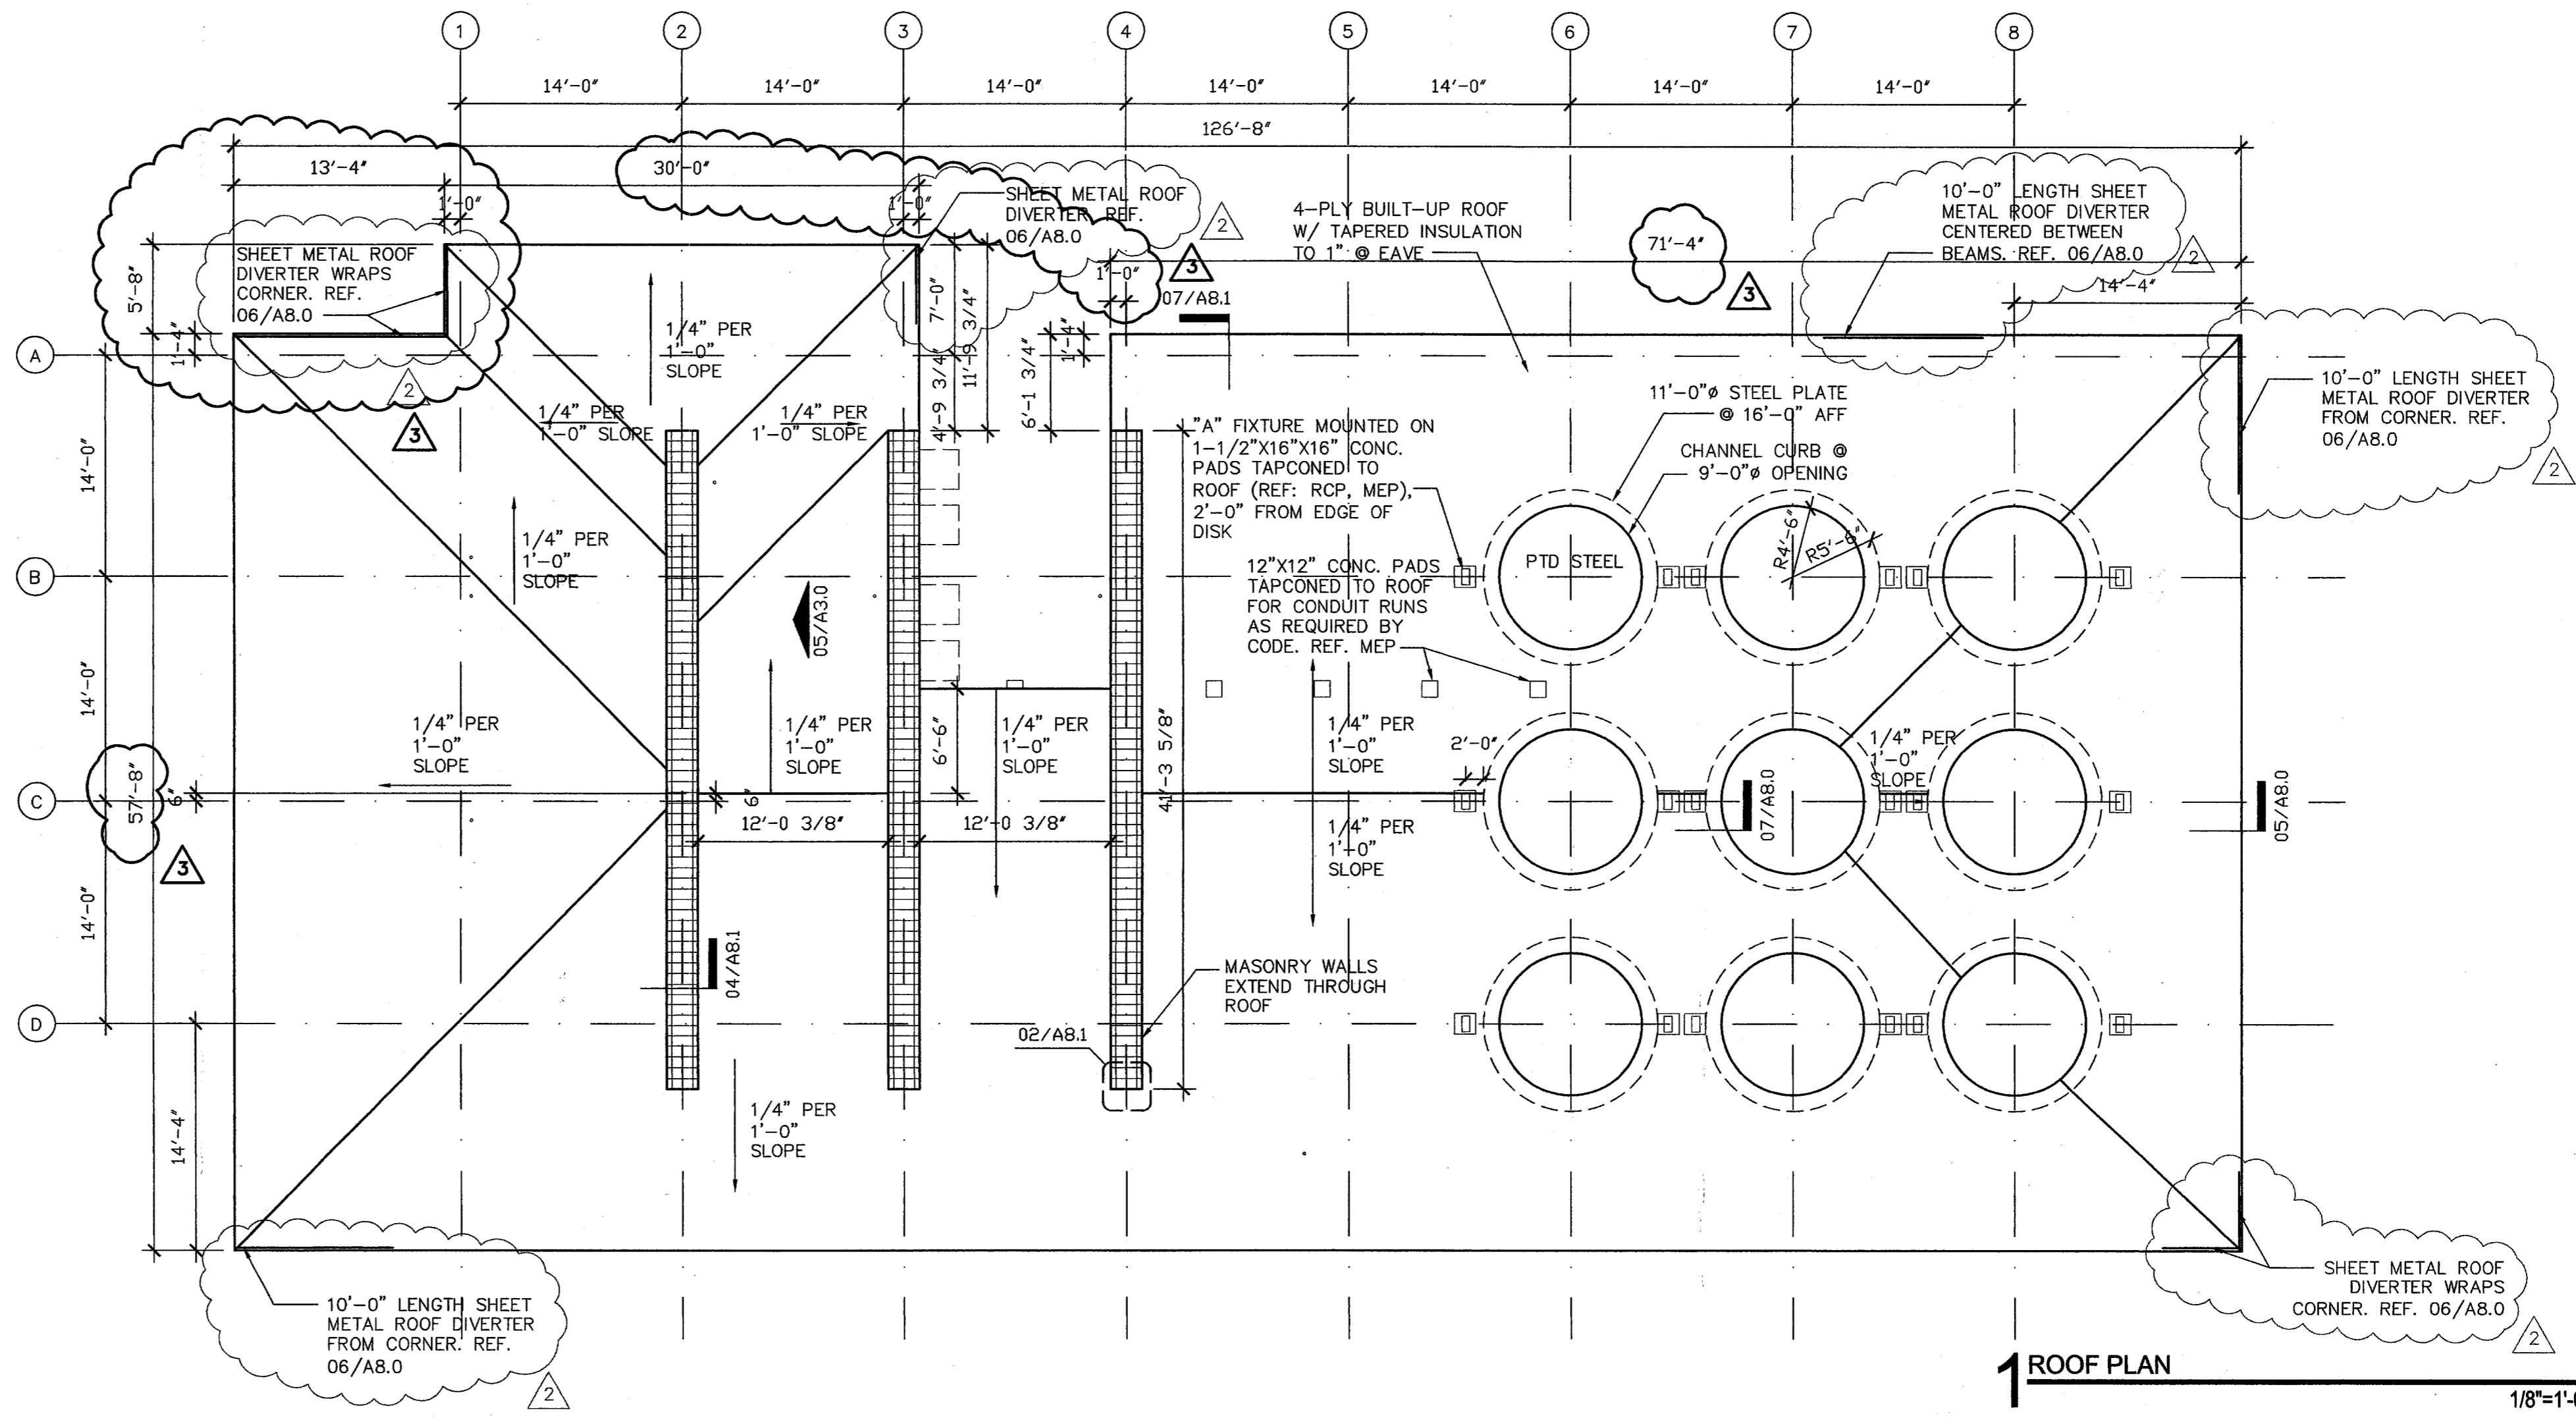

1 ROOF PLAN

1/8"=1'-0"

cunningham architects
 918 Dragon Street
 Dallas, Texas 75207
 v 214.915.0900
 f 214.915.0901

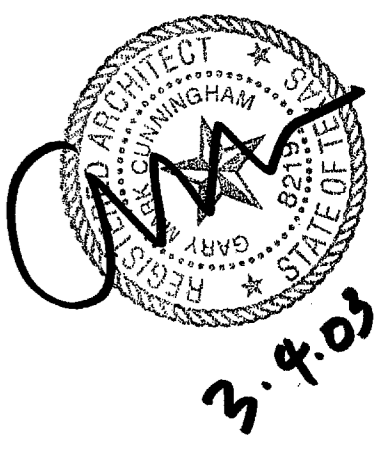

Addison Arts and Events Pavilion
 Addison, Texas
 4970 Addison Circle Drive

issue	date
DD	08/26/02
50% CD	11/05/02
100% CD	01/23/03
ADDENDUM1	01/31/03
ADDENDUM2	02/06/03
POST-BID REVISION	03/04/03

A2.0
 ROOF PLAN
 REFLECTED
 CEILING PLAN