



**4 SOUTH ELEVATION**  
MEN'S ROOM 1/2"=1'-0"

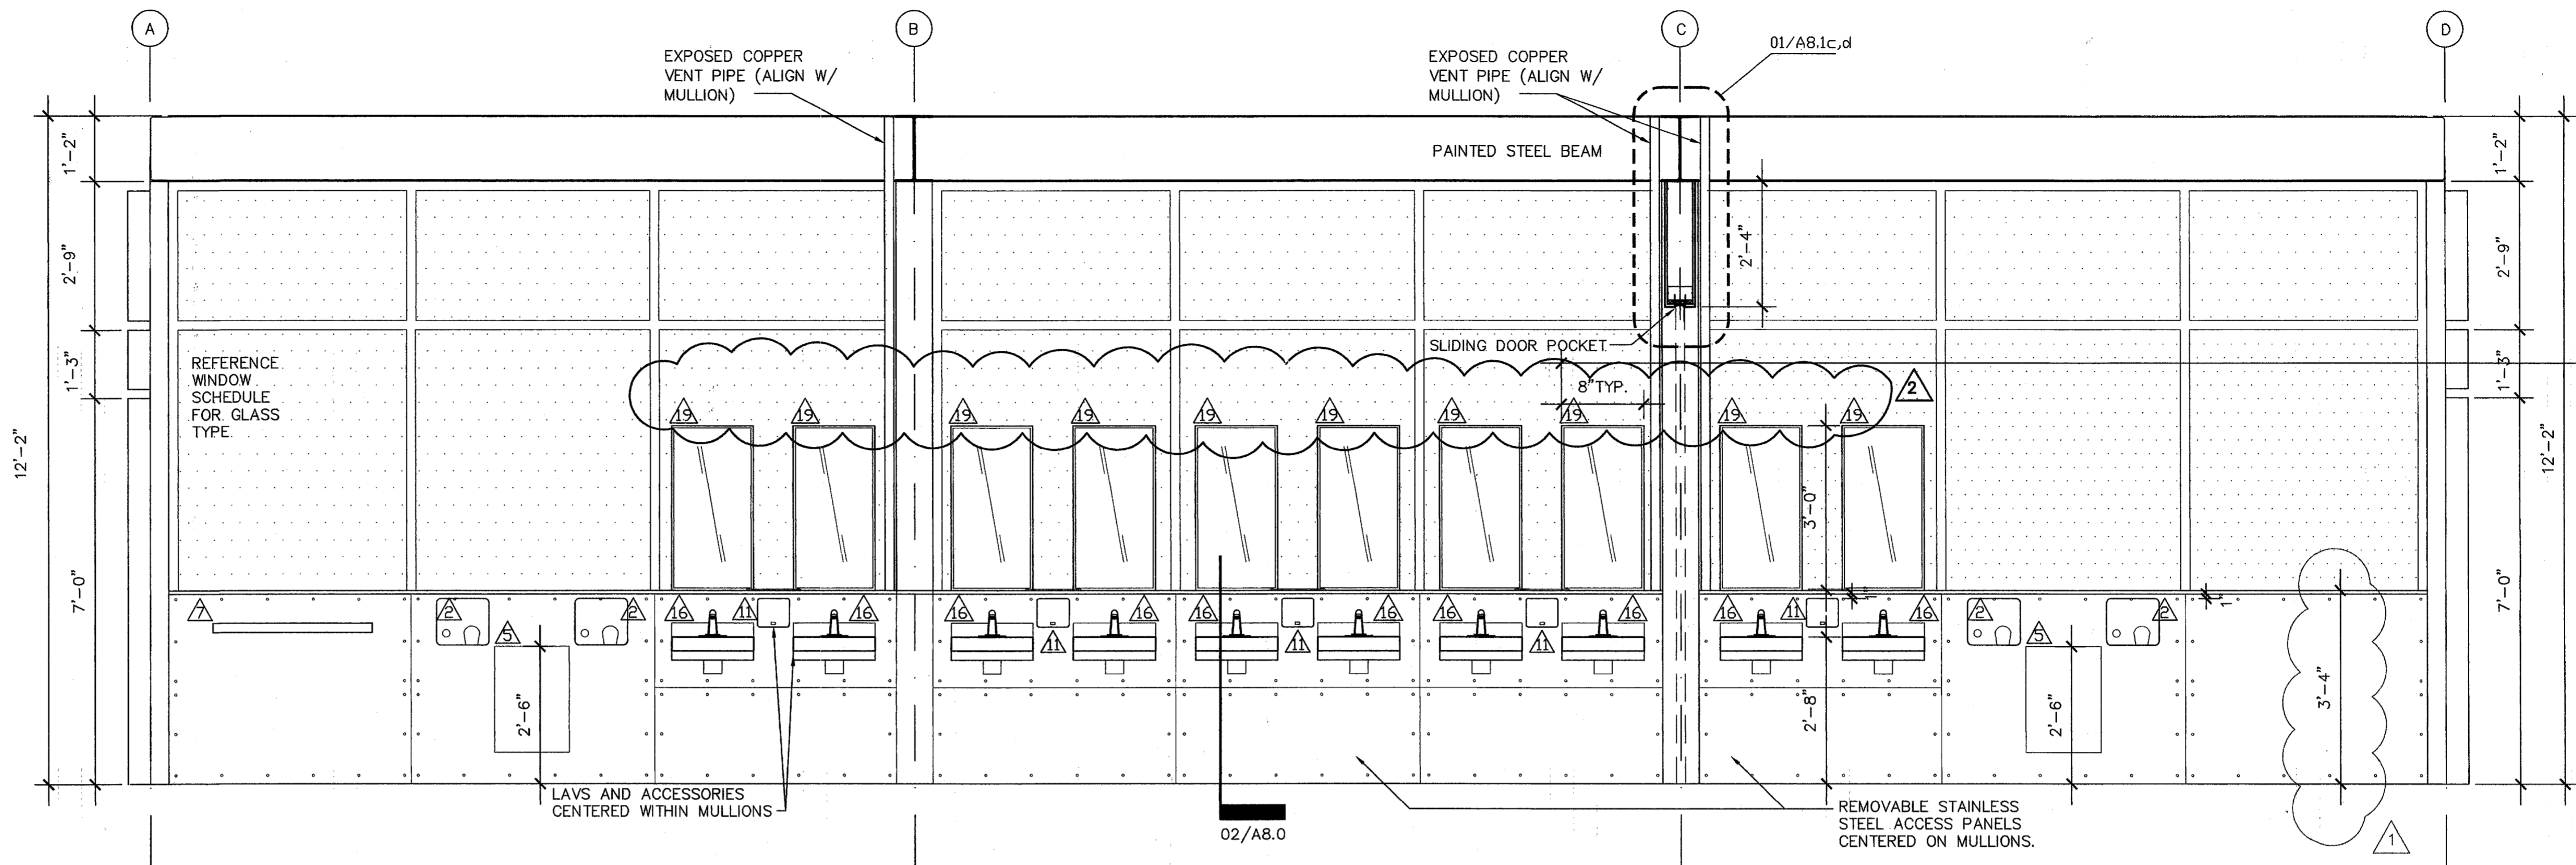


**3 WEST ELEVATION**  
MEN'S ROOM 1/2"=1'-0"

TOILET AND BATH ACCESSORY SCHEDULE	
NO.	DESCRIPTION
1	NOT USED
2	WARM AIR DRYER
3	MIRROR/SHELF COMBINATION UNIT
4	LIQUID SOAP DISPENSER (WOMEN)
5	WASTE RECEPTACLE, SURFACE MOUNTED
6	SANITARY NAPKIN/TAMPON VENDOR
7	DIAPER CHANGING STATION
8	SANITARY NAPKIN/TAMPON DISPOSAL UNIT
9	TOILET TISSUE DISPENSER
10	NOT USED
11	LIQUID SOAP DISPENSER (MEN)
12	NOT USED
13	GRAB BAR
14	WALL MOUNTED TOILET - REF. PLUMBING SCHEDULE
15	WALL MOUNTED URINAL - REF. PLUMBING SCHEDULE
16	WALL MOUNTED VANITY SINK - REF. PLUMBING SCHEDULE
17	MIRROR
18	COAT-HOOK
19	STAINLESS STEEL MIRROR 8" WIDE
20	TOILET PARTITIONS TO BE STAINLESS STEEL CLG MOUNTED

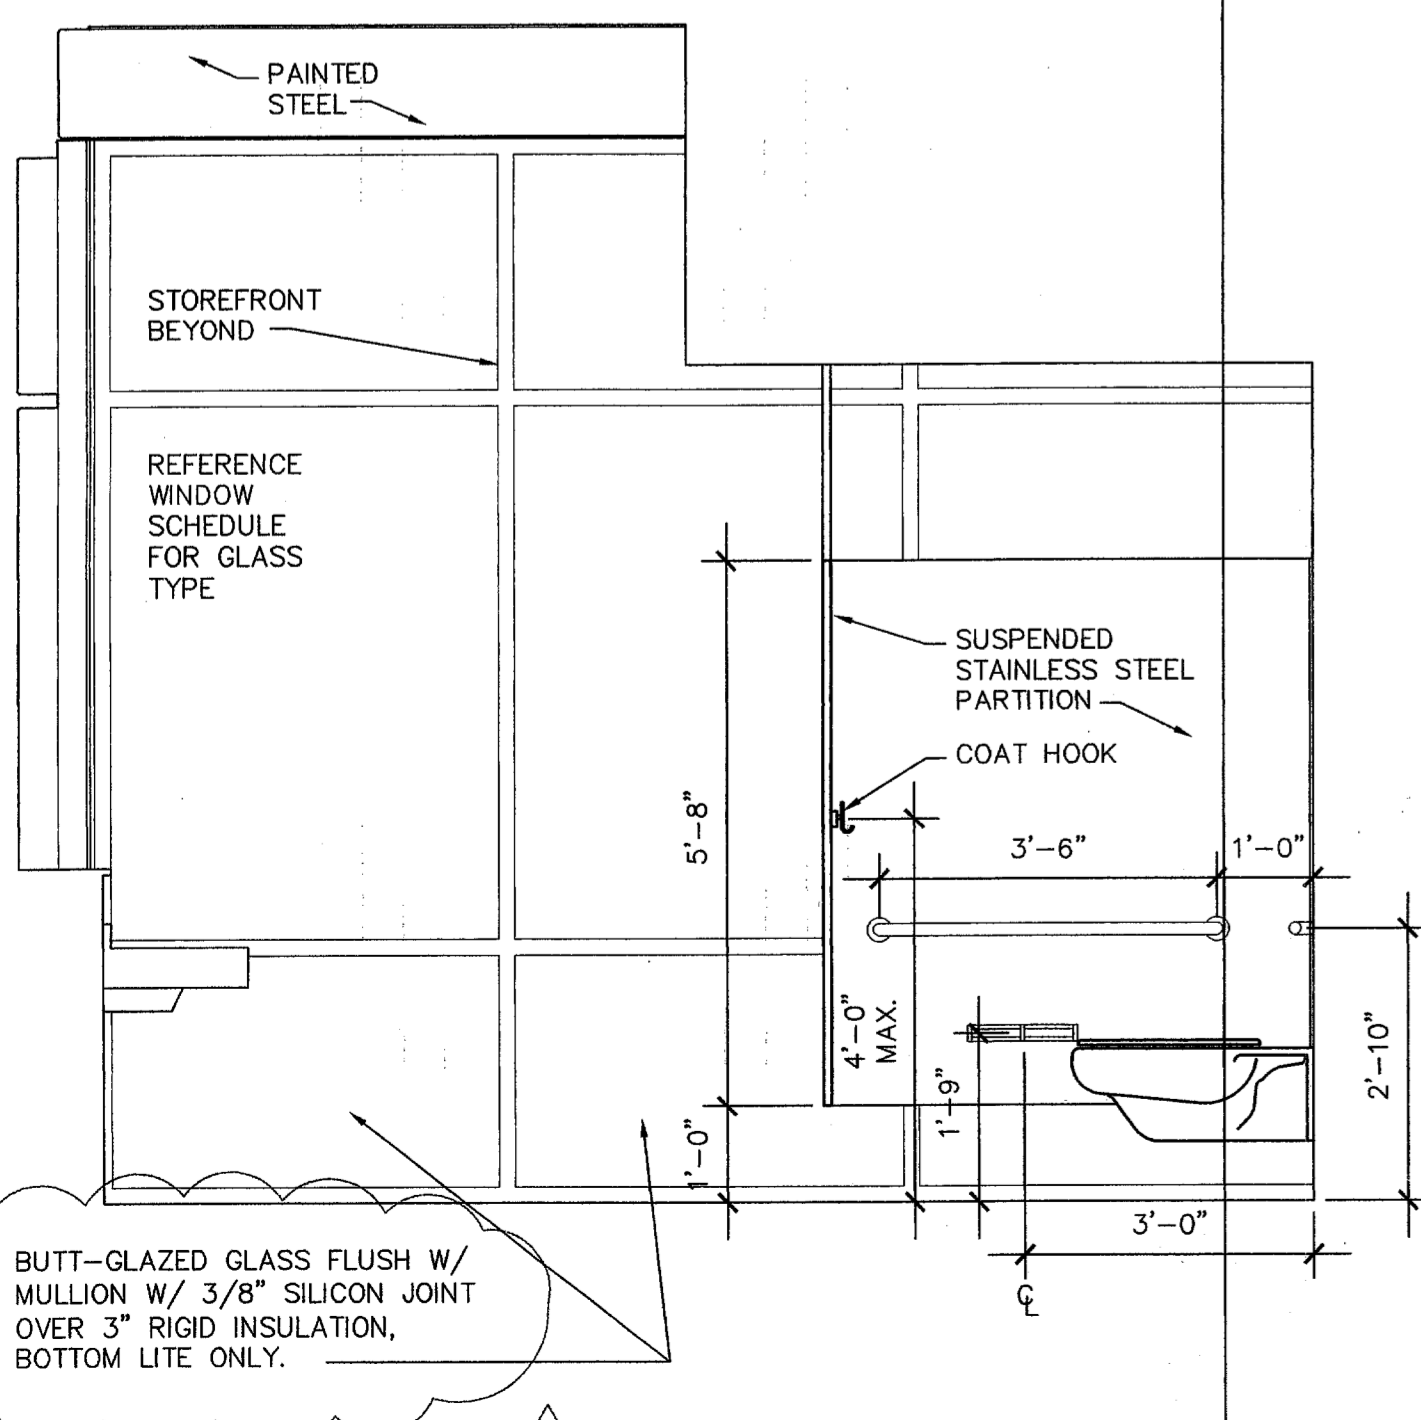


**2 NORTH ELEVATION**  
MEN'S ROOM 1/2"=1'-0"

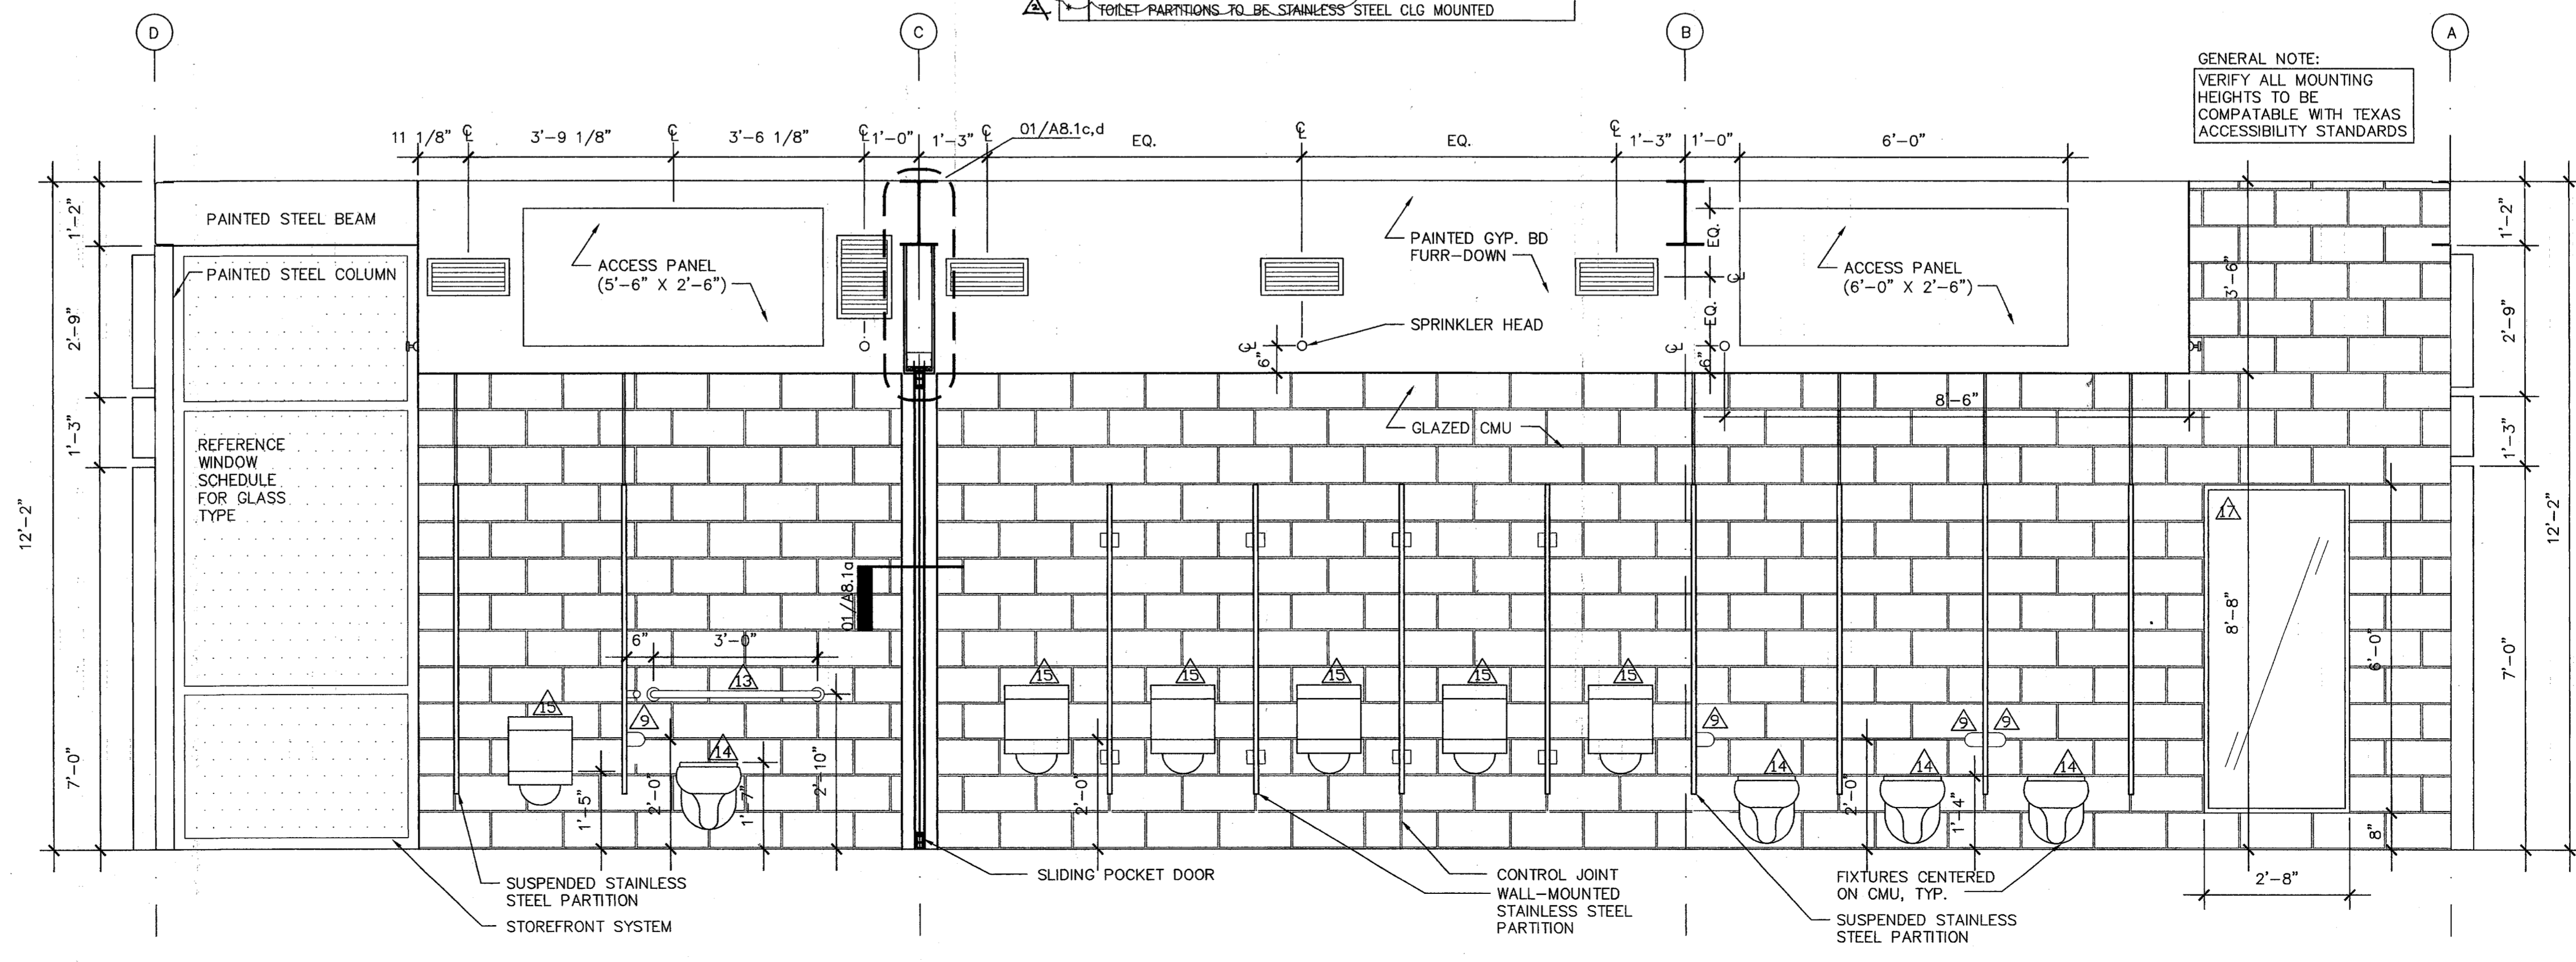

**1 EAST ELEVATION**  
MEN'S ROOM 1/2"=1'-0"

GENERAL NOTE:  
VERIFY ALL MOUNTING  
HEIGHTS TO BE  
COMPATIBLE WITH TEXAS  
ACCESSIBILITY STANDARDS

**cunningham architects**  
918 Oregon Street  
Dallas, Texas 75207  
V 214.915.0900  
F 214.915.0901

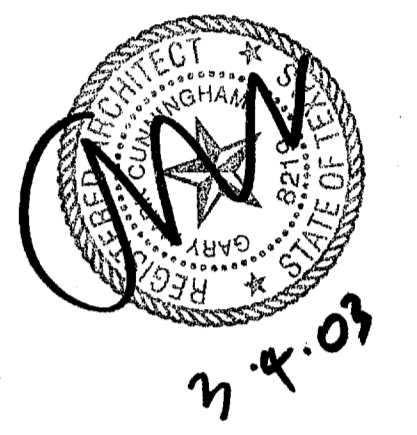

**Addison Arts and Events Pavilion**  
4970 Addison Circle Drive  
Addison, Texas

Issue Date  
DD 08/26/02  
100% CD 11/05/02  
ADDENDUM1 01/31/03  
ADDENDUM2 02/06/03

**A7.0**  
INTERIOR ELEVATIONS:  
MEN'S RM