


BUTT-GLAZED GLASS FLUSH W/
MULLION W/ 3/8" SILICON JOINT
OVER 3" RIGID INSULATION,
BOTTOM LITE ONLY.


4 SOUTH ELEVATION
WOMEN'S ROOM

1/2"=1'-0"

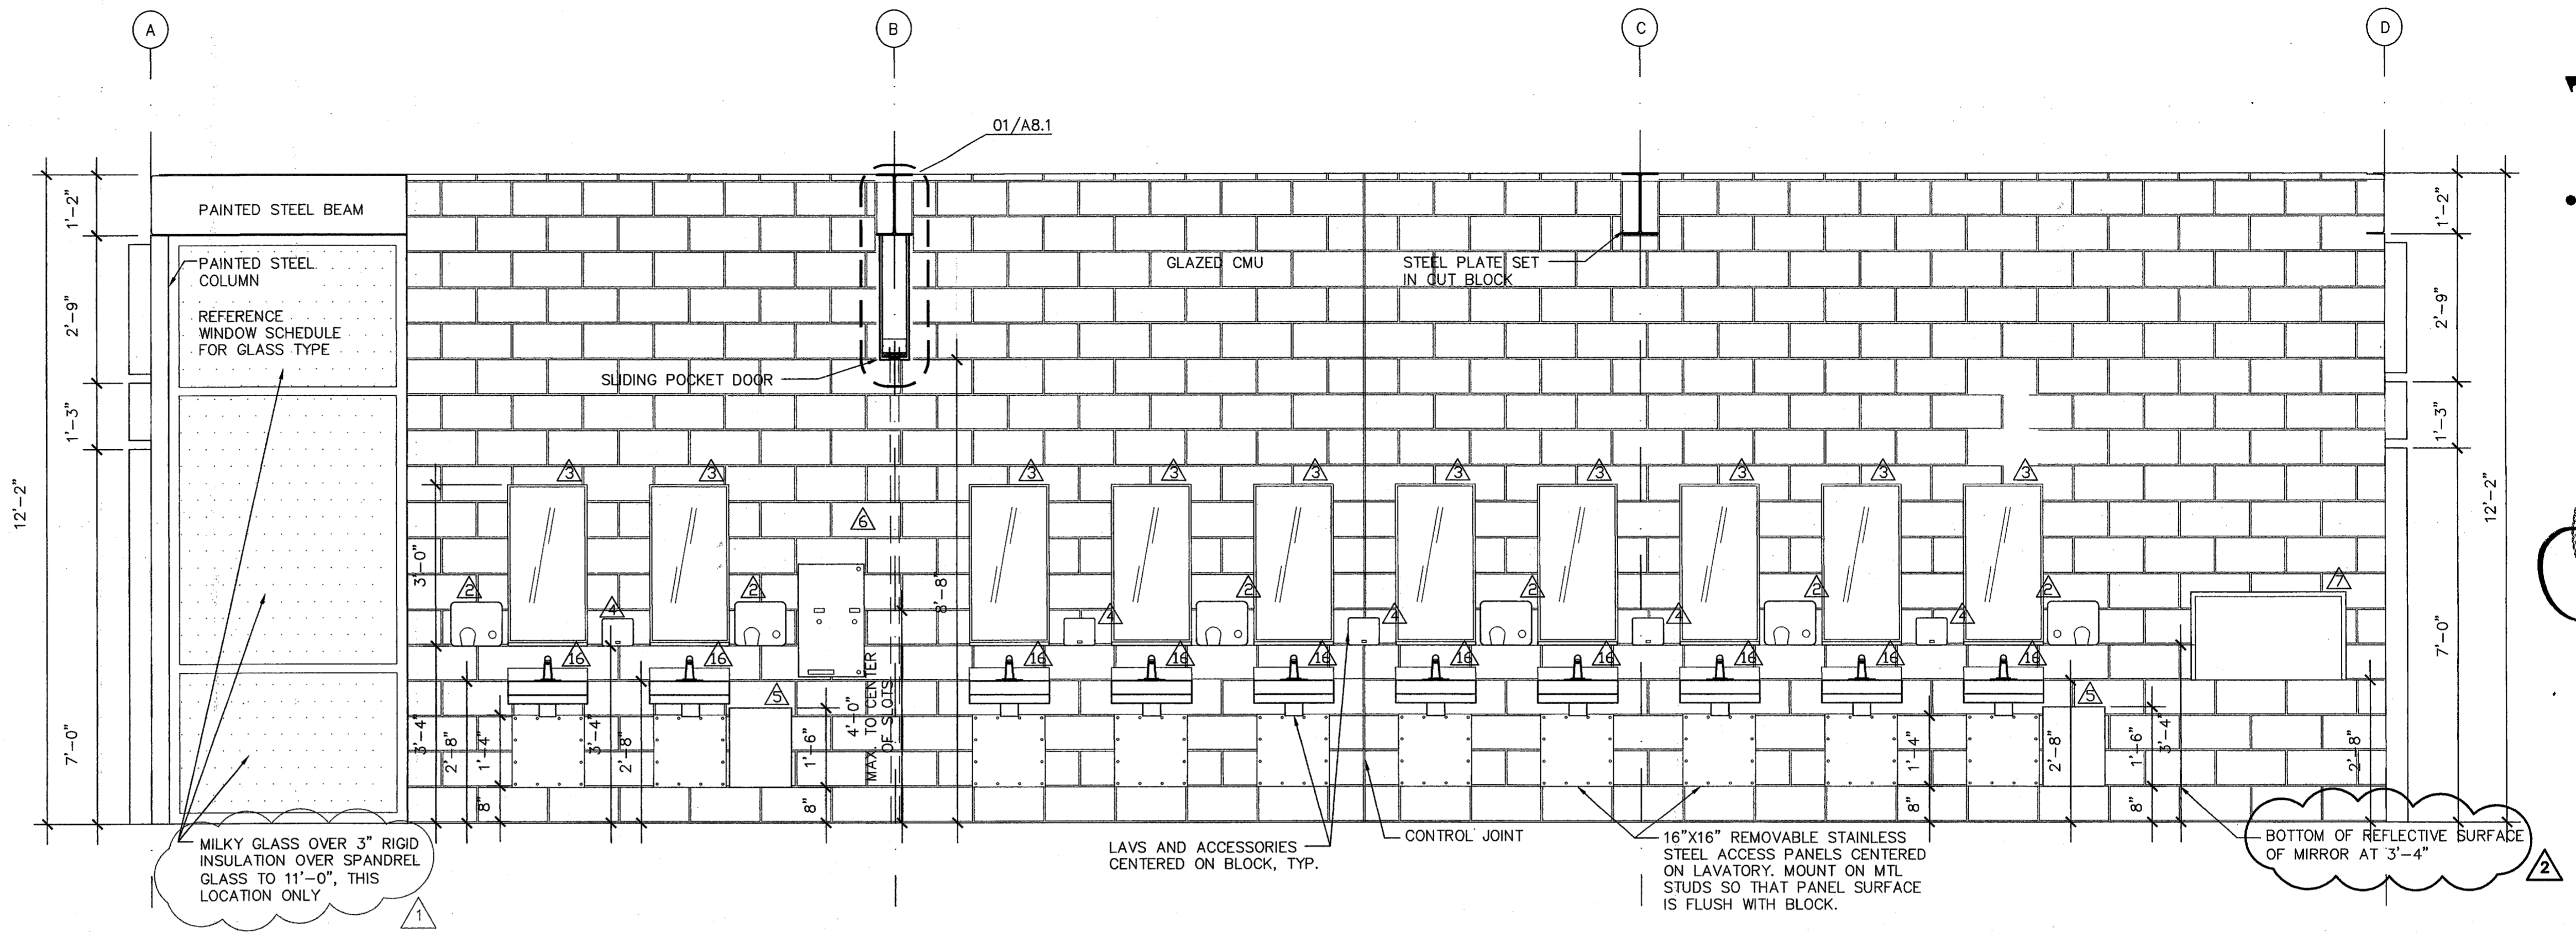

2 EAST ELEVATION
WOMEN'S ROOM


1/2"=1'-0"

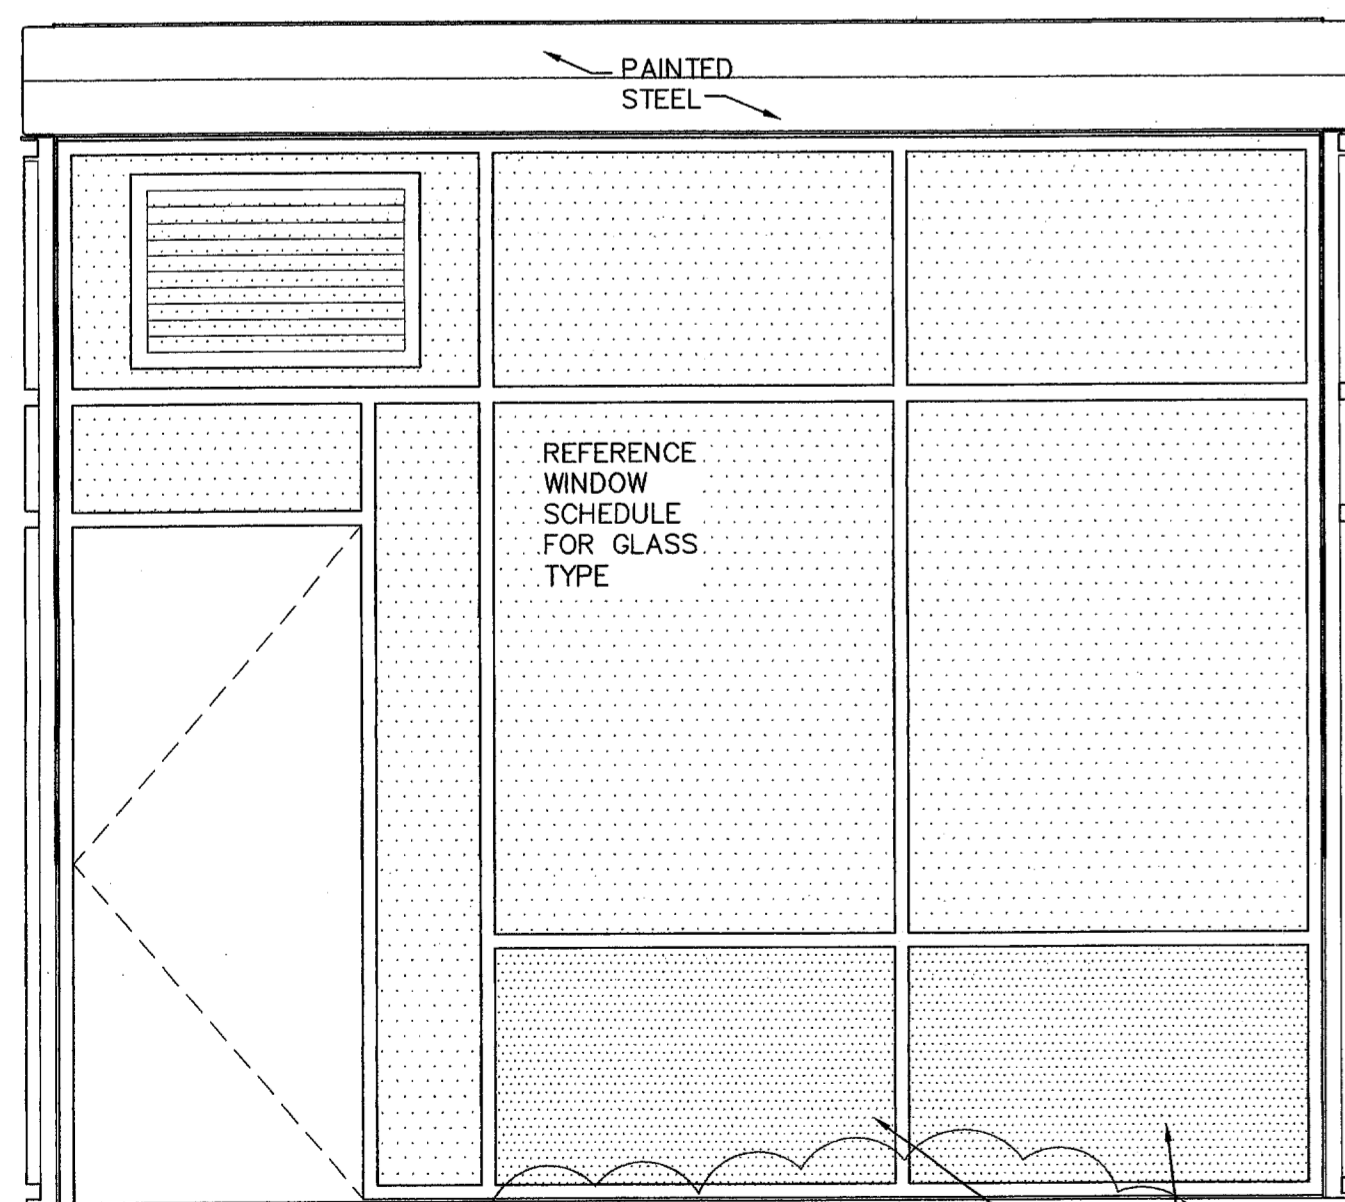

BUTT-GLAZED GLASS FLUSH W/
MULLION W/ 3/8" SILICON JOINT
OVER 3" RIGID INSULATION,
BOTTOM LITE ONLY.

3 NORTH ELEVATION
WOMEN'S ROOM

1/2"=1'-0"

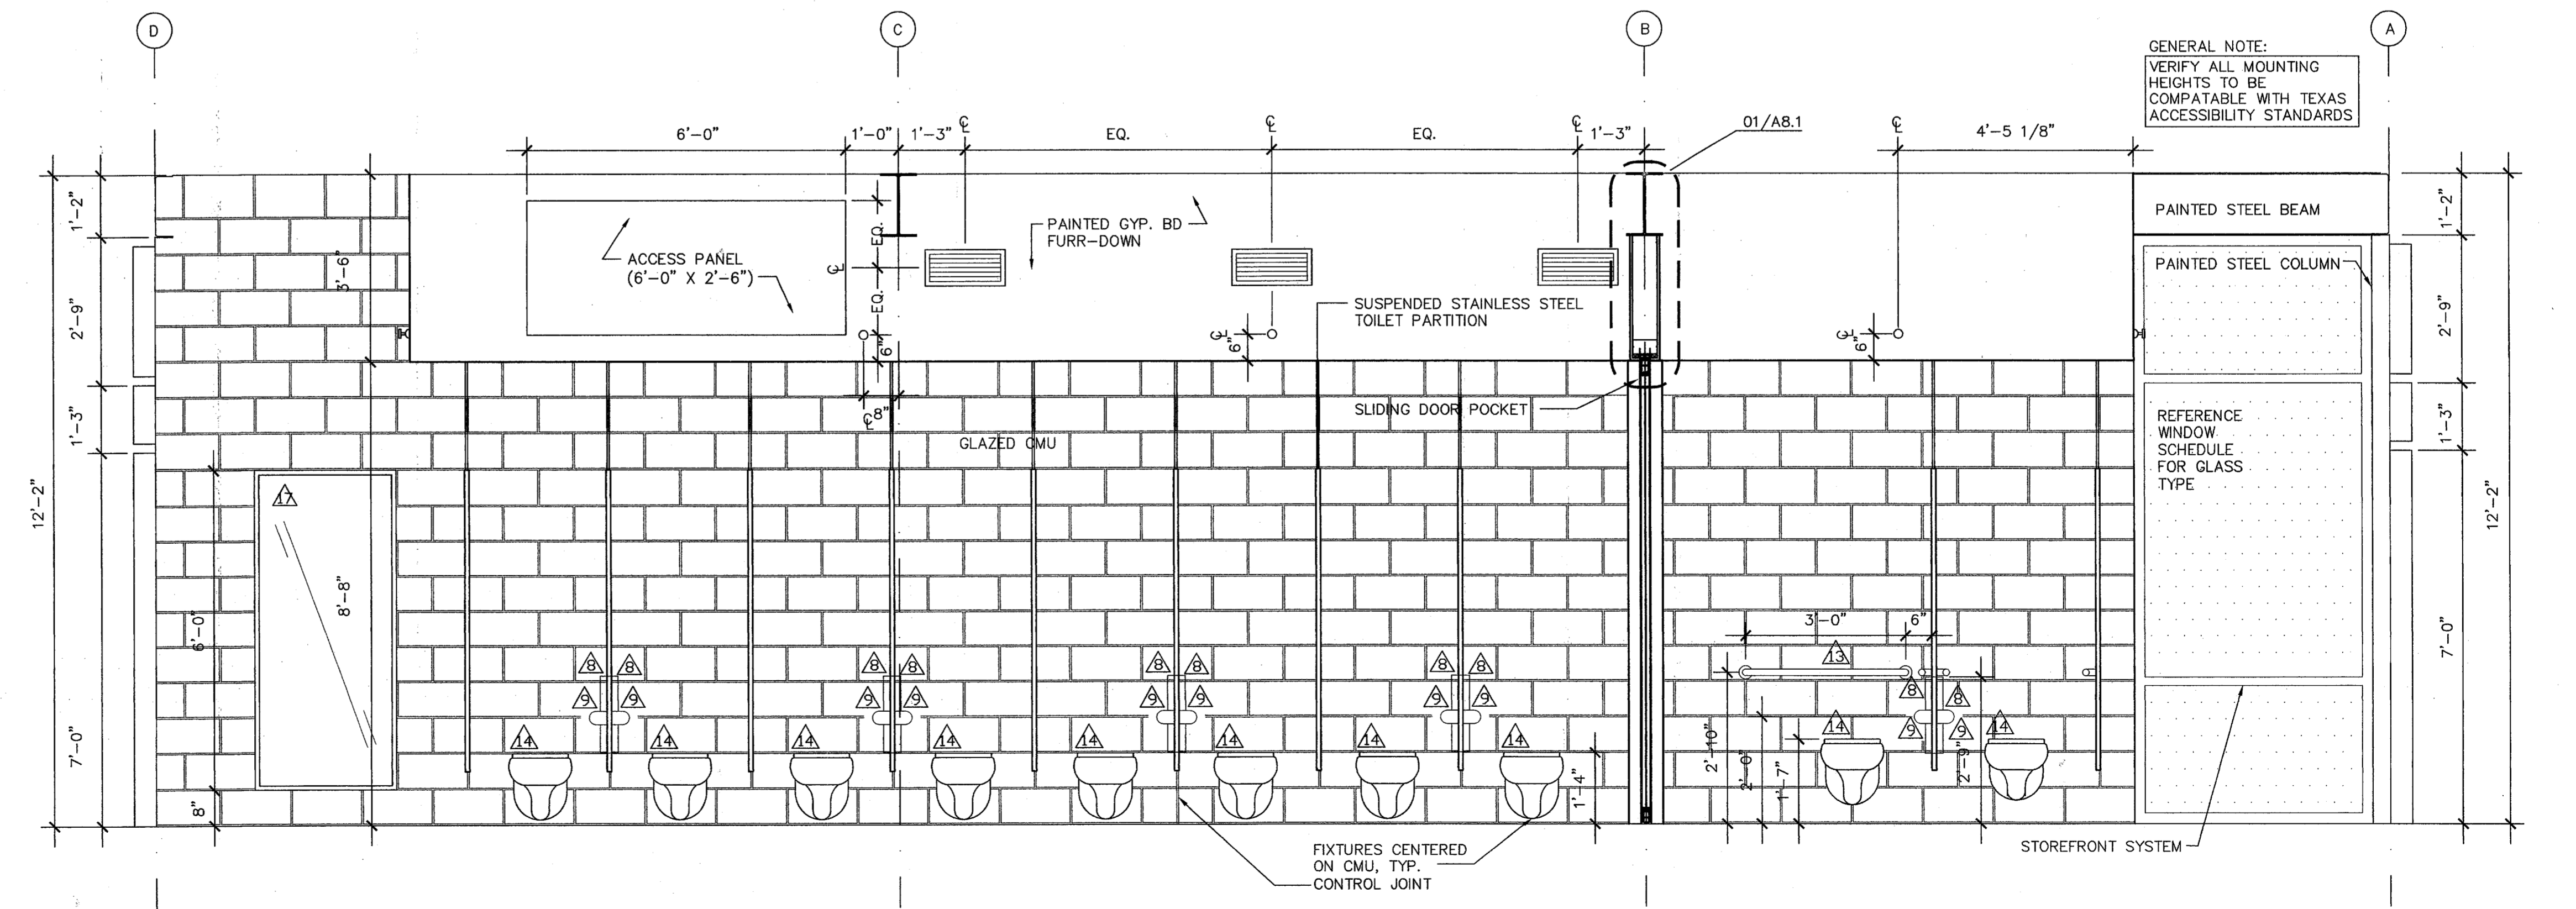

1 WEST ELEVATION
WOMEN'S ROOM

1/2"=1'-0"



issue	date
08/06/02	
11/05/02	
10/23/03	
01/31/03	
03/04/03	

POST-BID REVISION