




date	issue
09/26/02	DD
11/05/02	50% CD
01/23/03	100% CD
03/27/03	APPENDIX 1
03/07/03	POST-BID REVISION

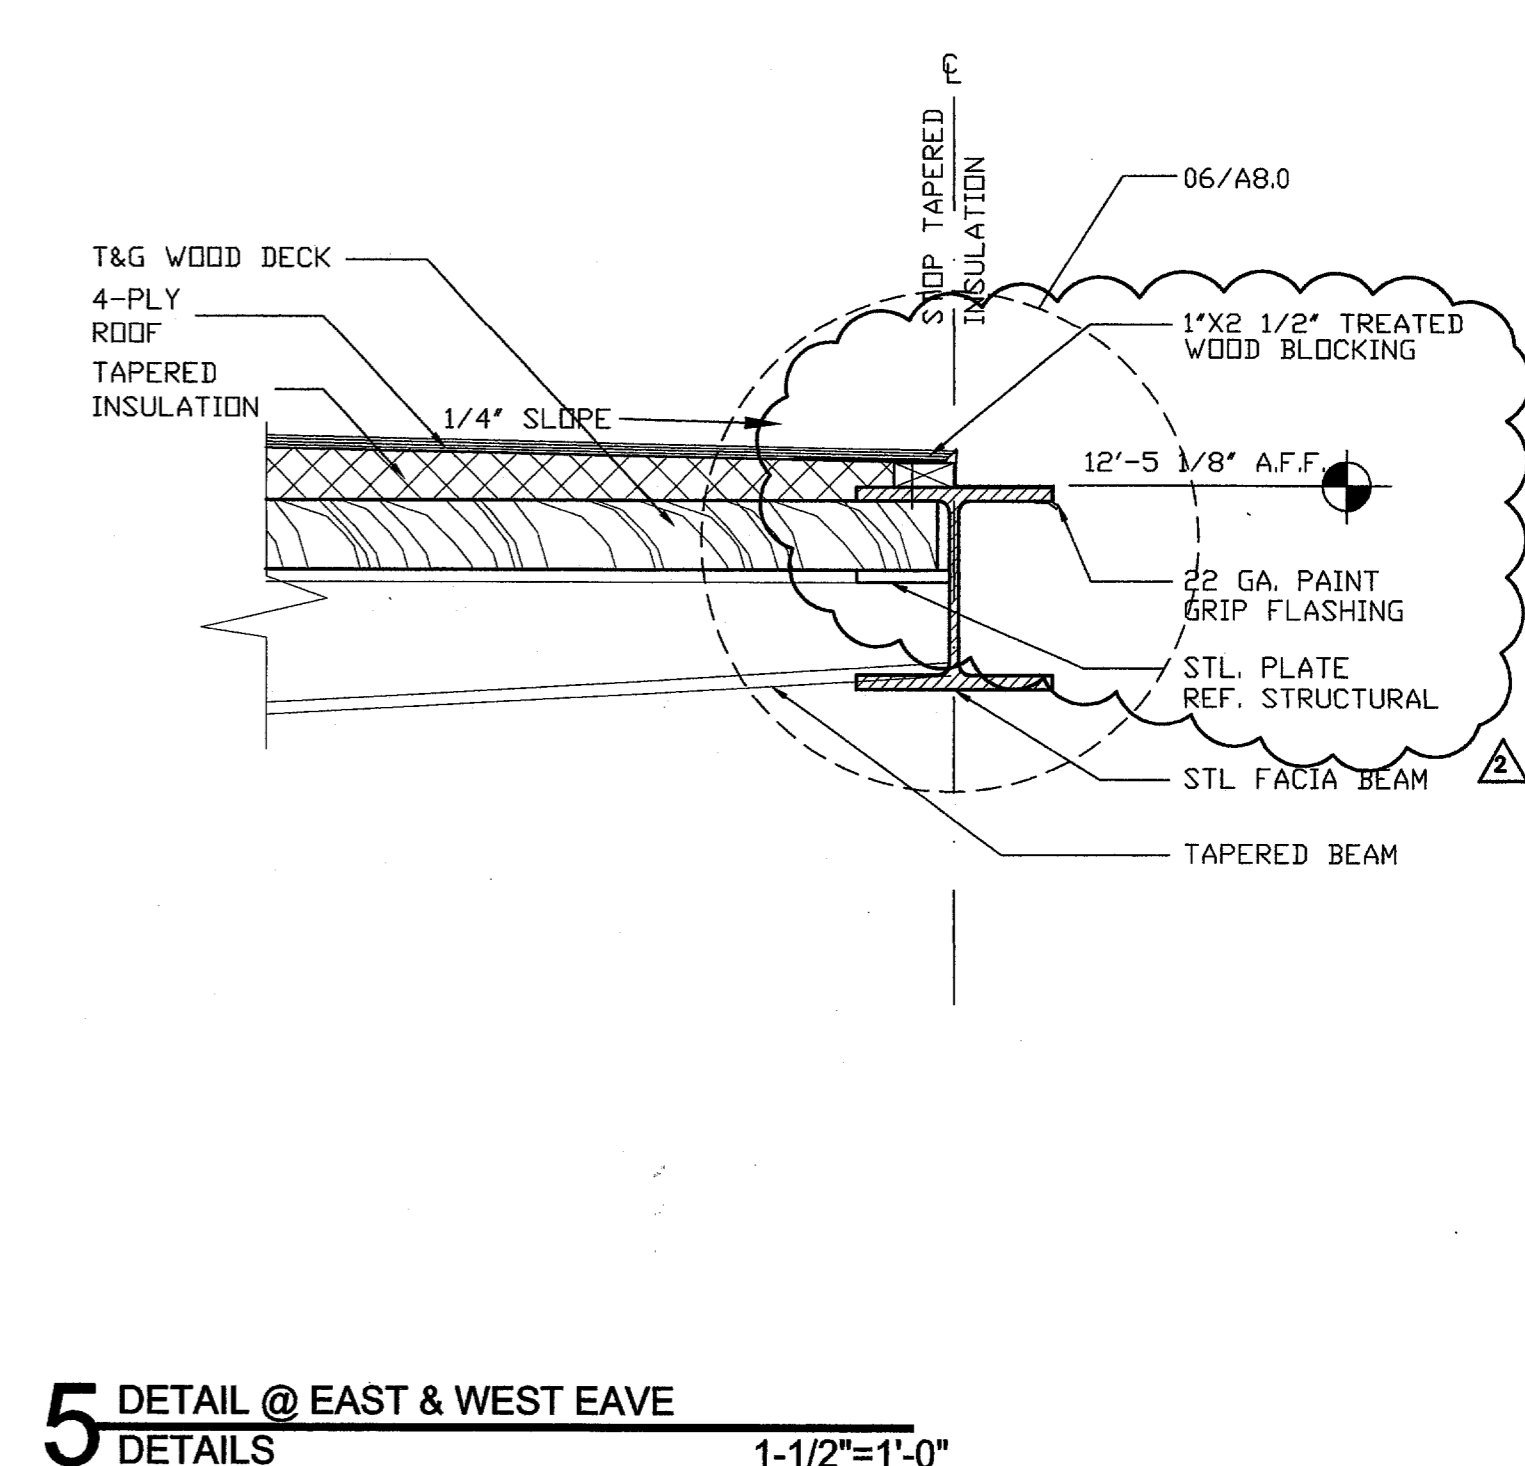


5 DETAIL @ EAST & WEST EAVE
 DETAILS 1-1/2"=1'-0"

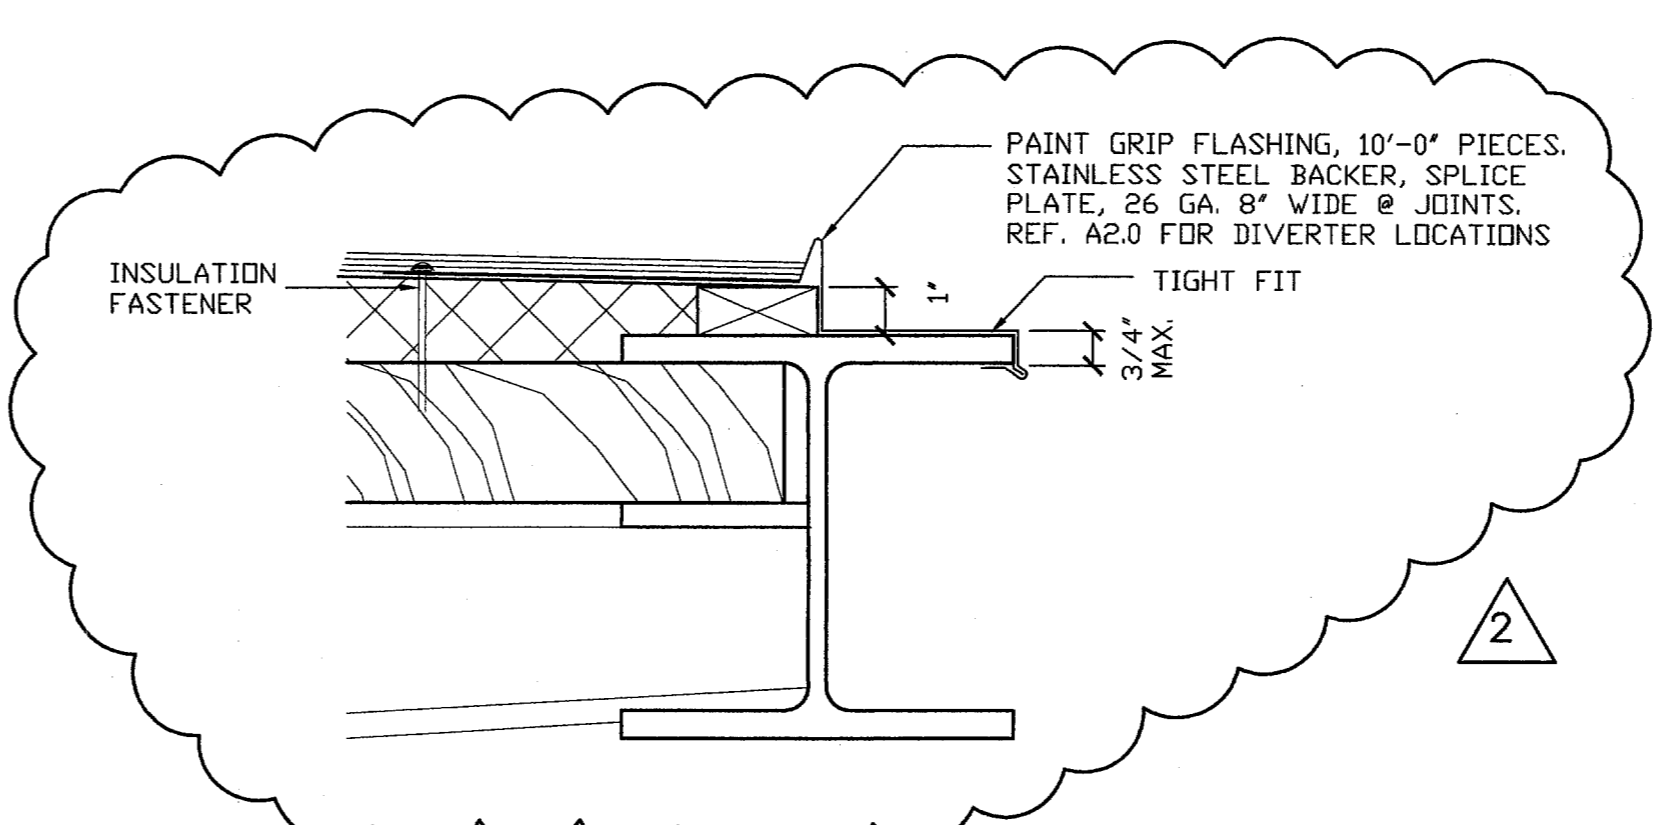


6 TYPICAL FLASHING @ EAST & WEST EAVE
 DETAILS 3"=1'-0"

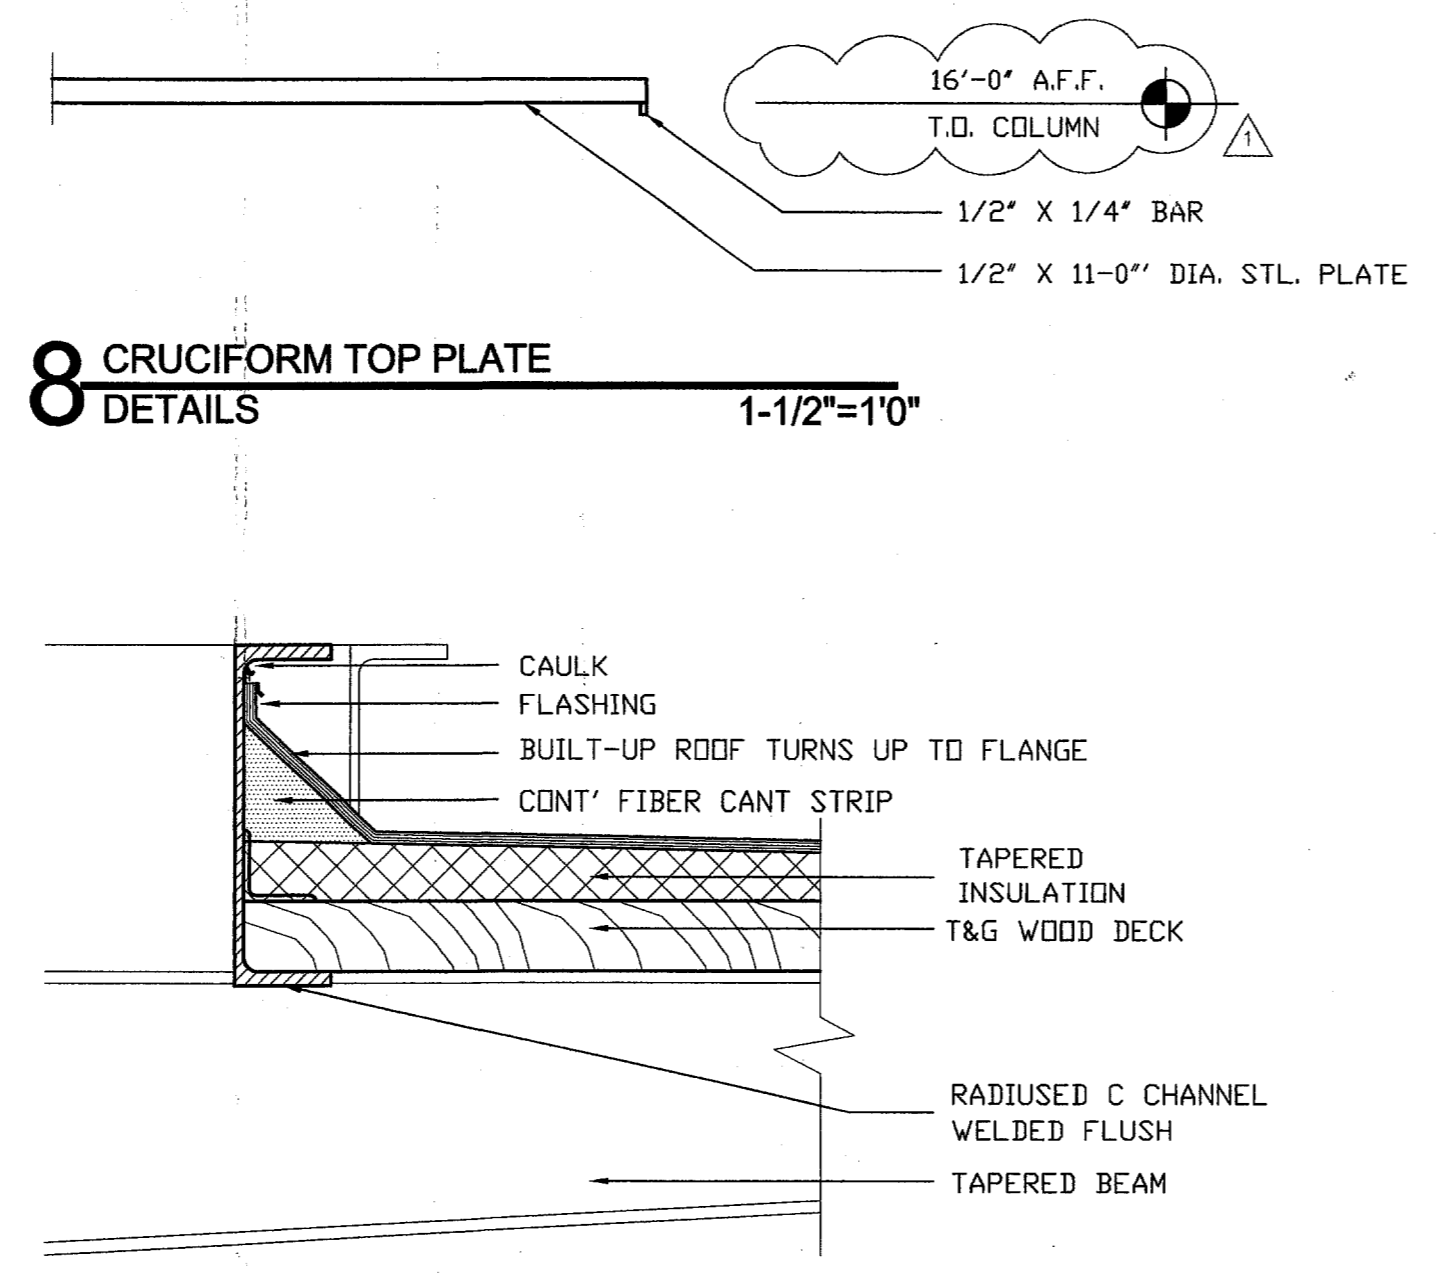


7 ROOF DETAIL @ CHANNEL OPENING
 DETAILS 1-1/2"=1'-0"

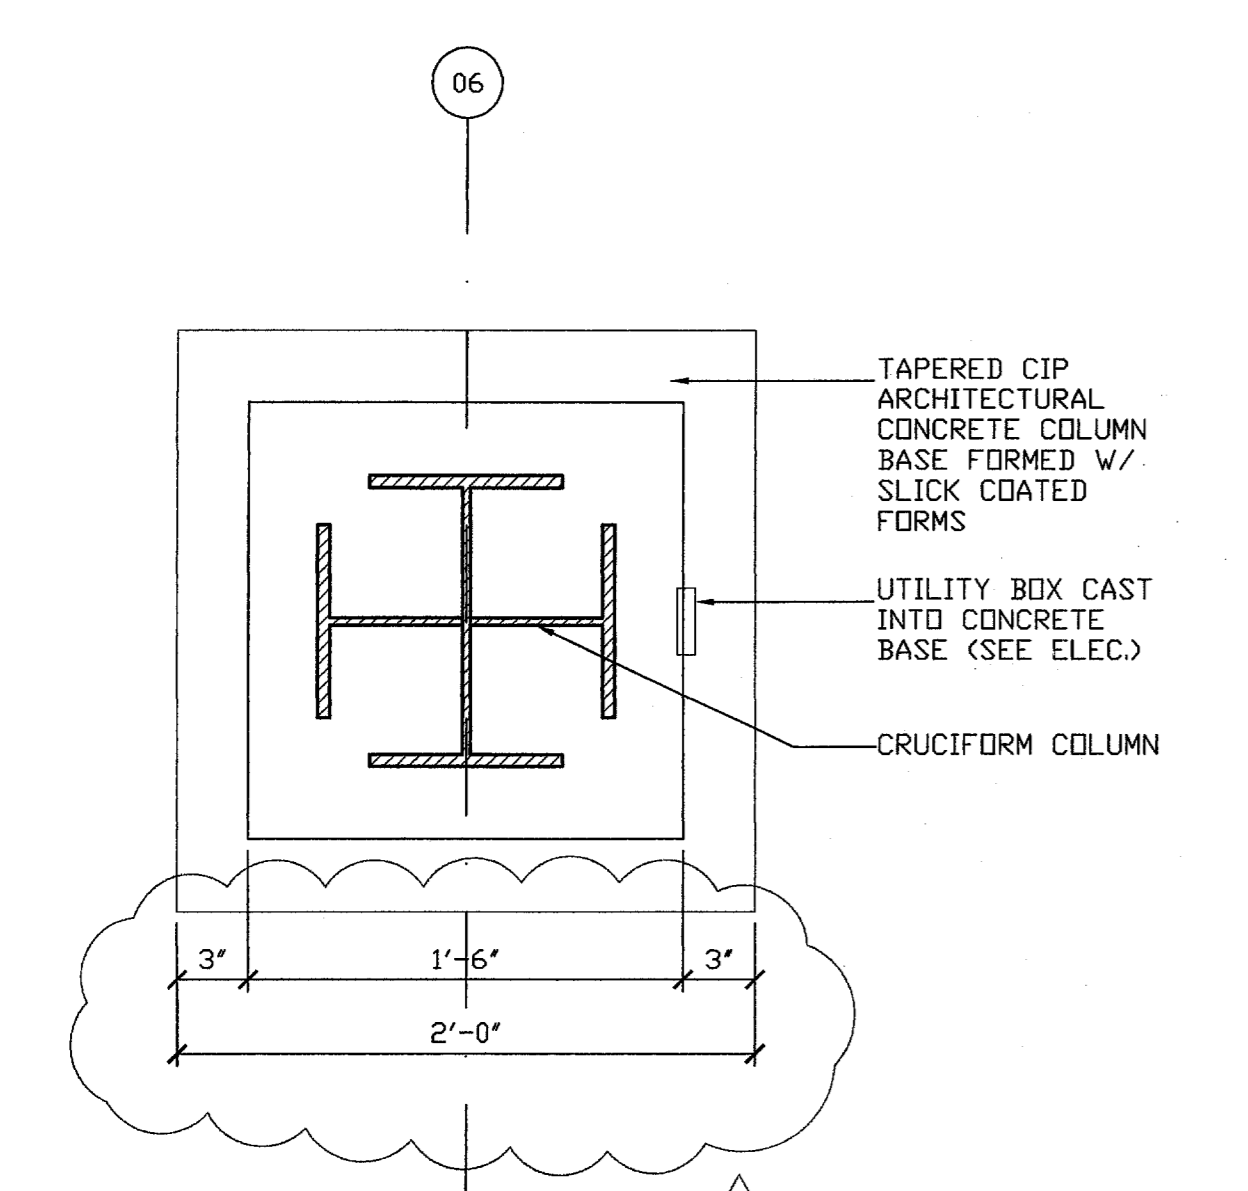


4 COLUMN BASE W/ J-BOX
 DETAILS 3/4"=1'-0"

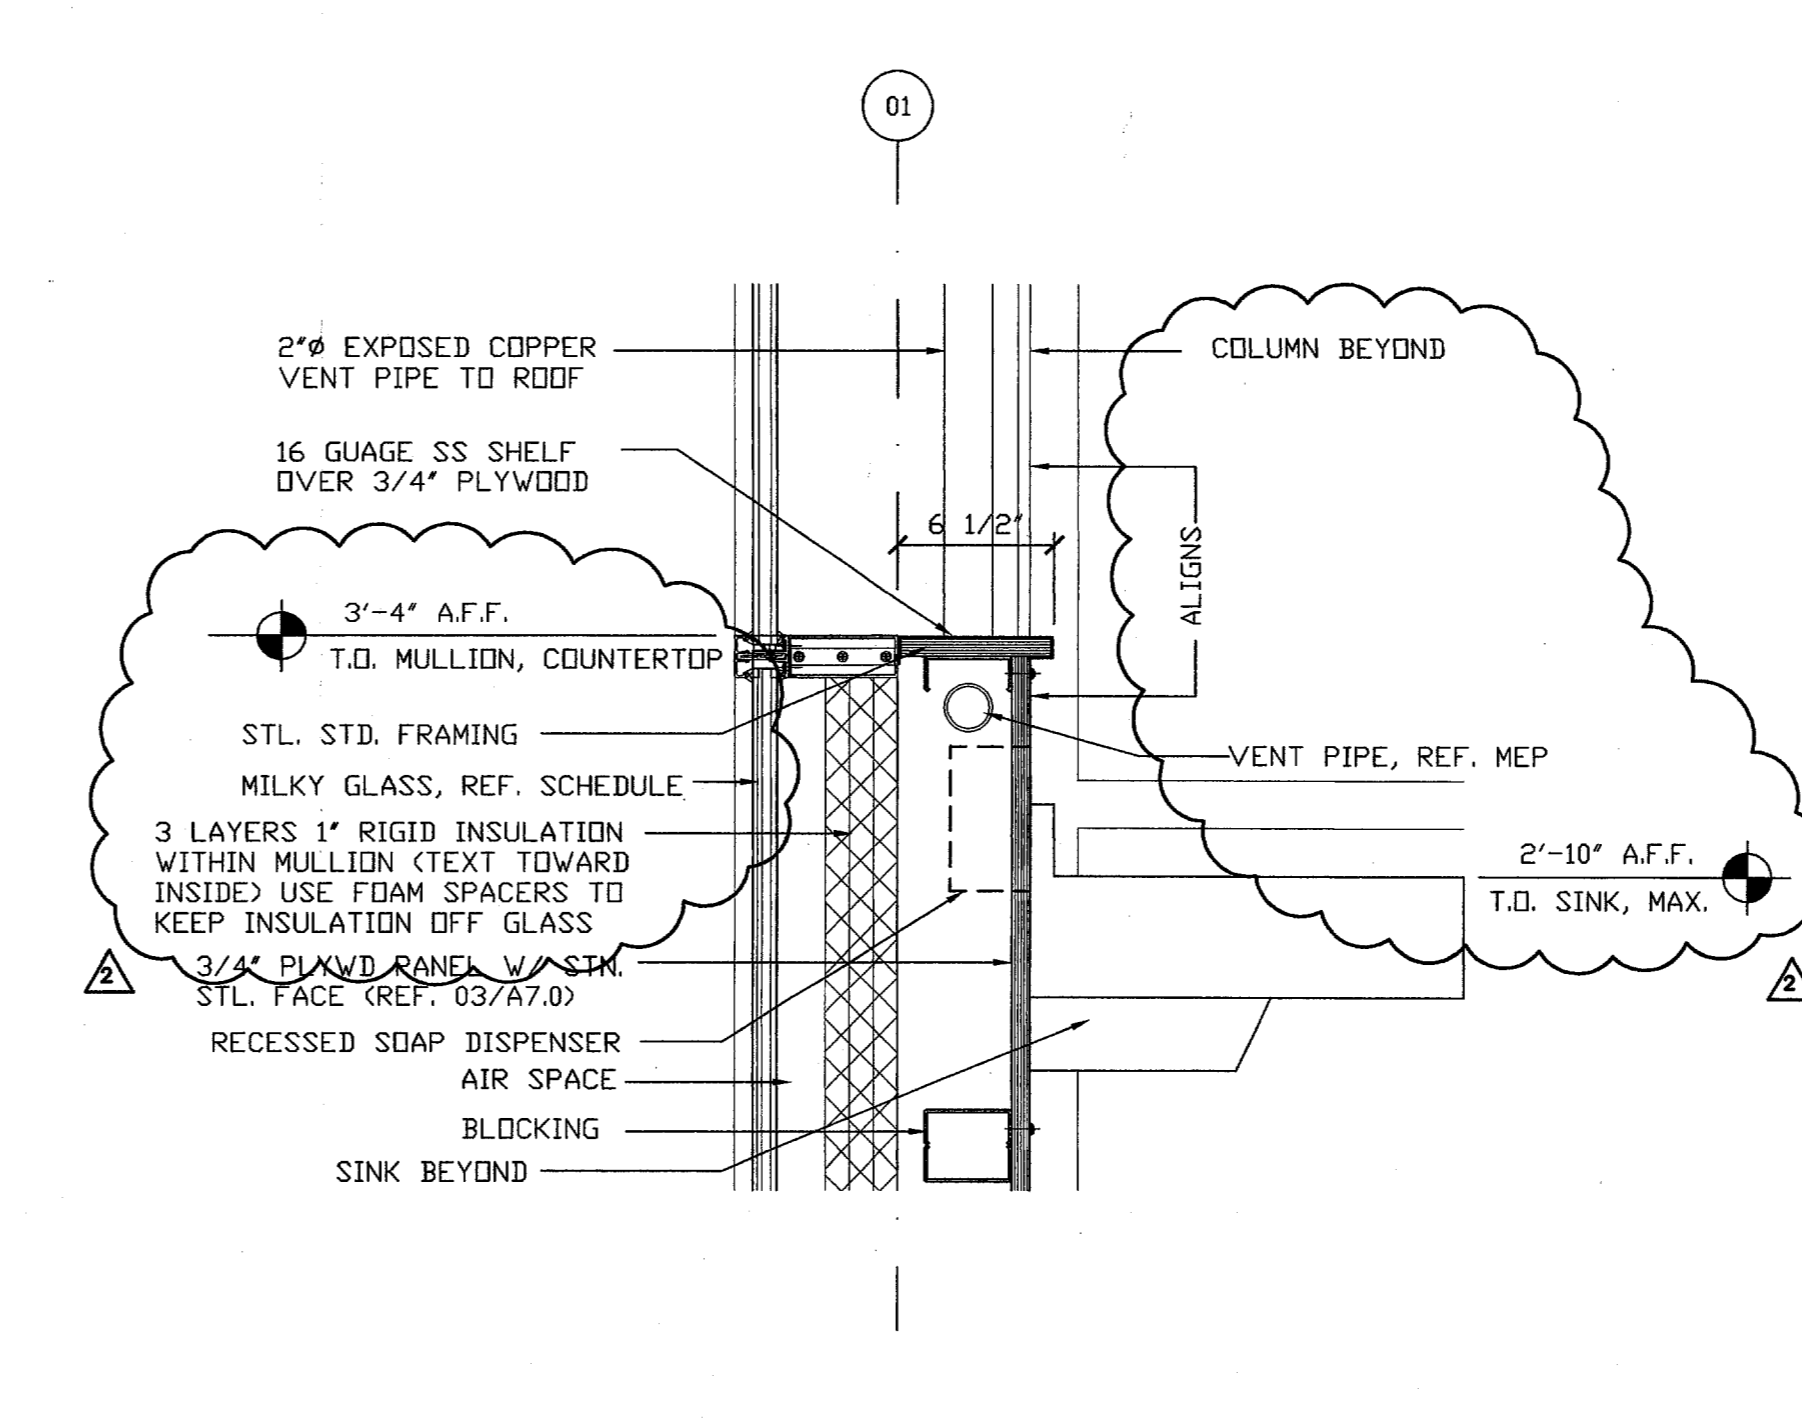


2 MEN'S ROOM FURR-OUT
 SECTION DETAIL 1-1/2"=1'-0"

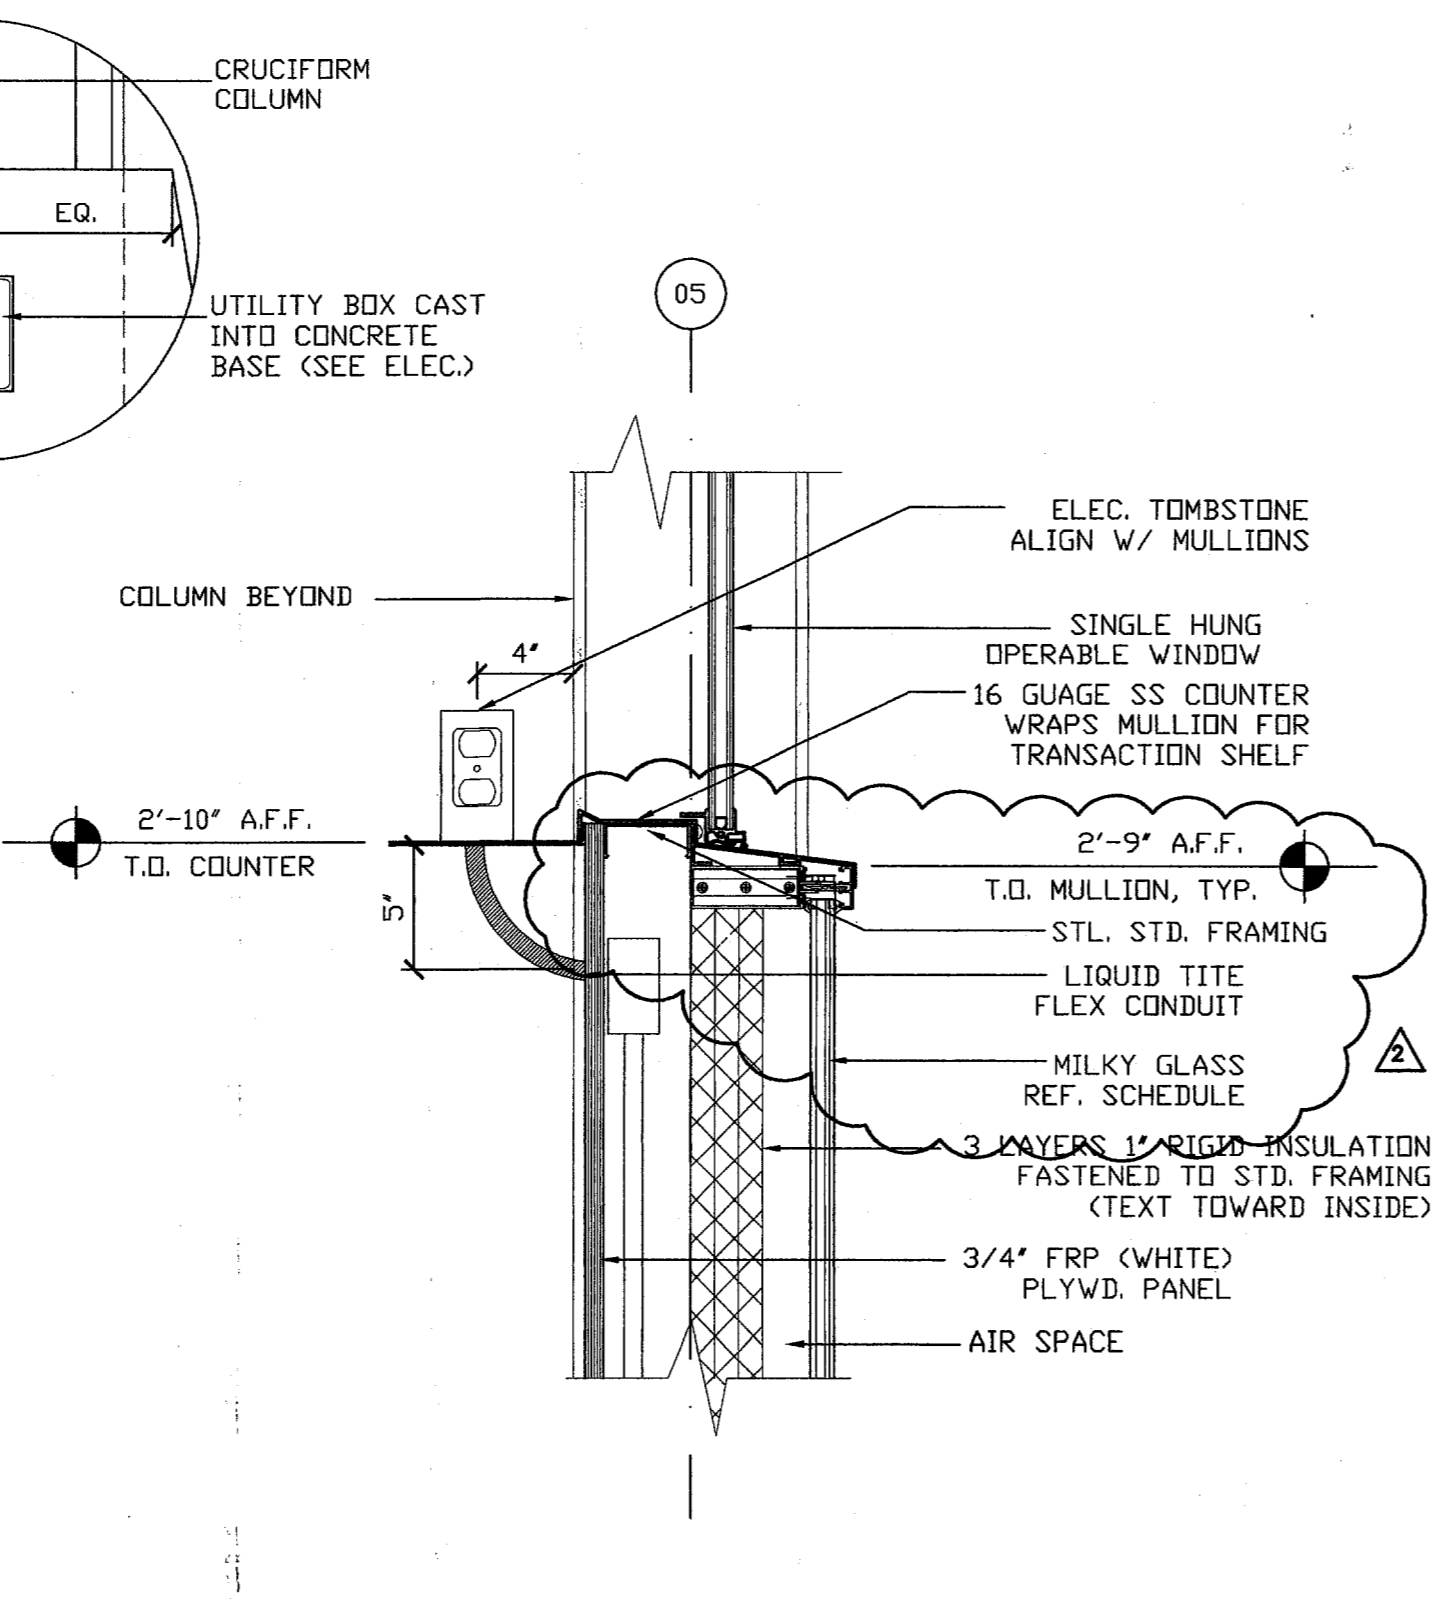

3 KITCHEN FURR-OUT
 SECTION DETAIL 1-1/2"=1'-0"

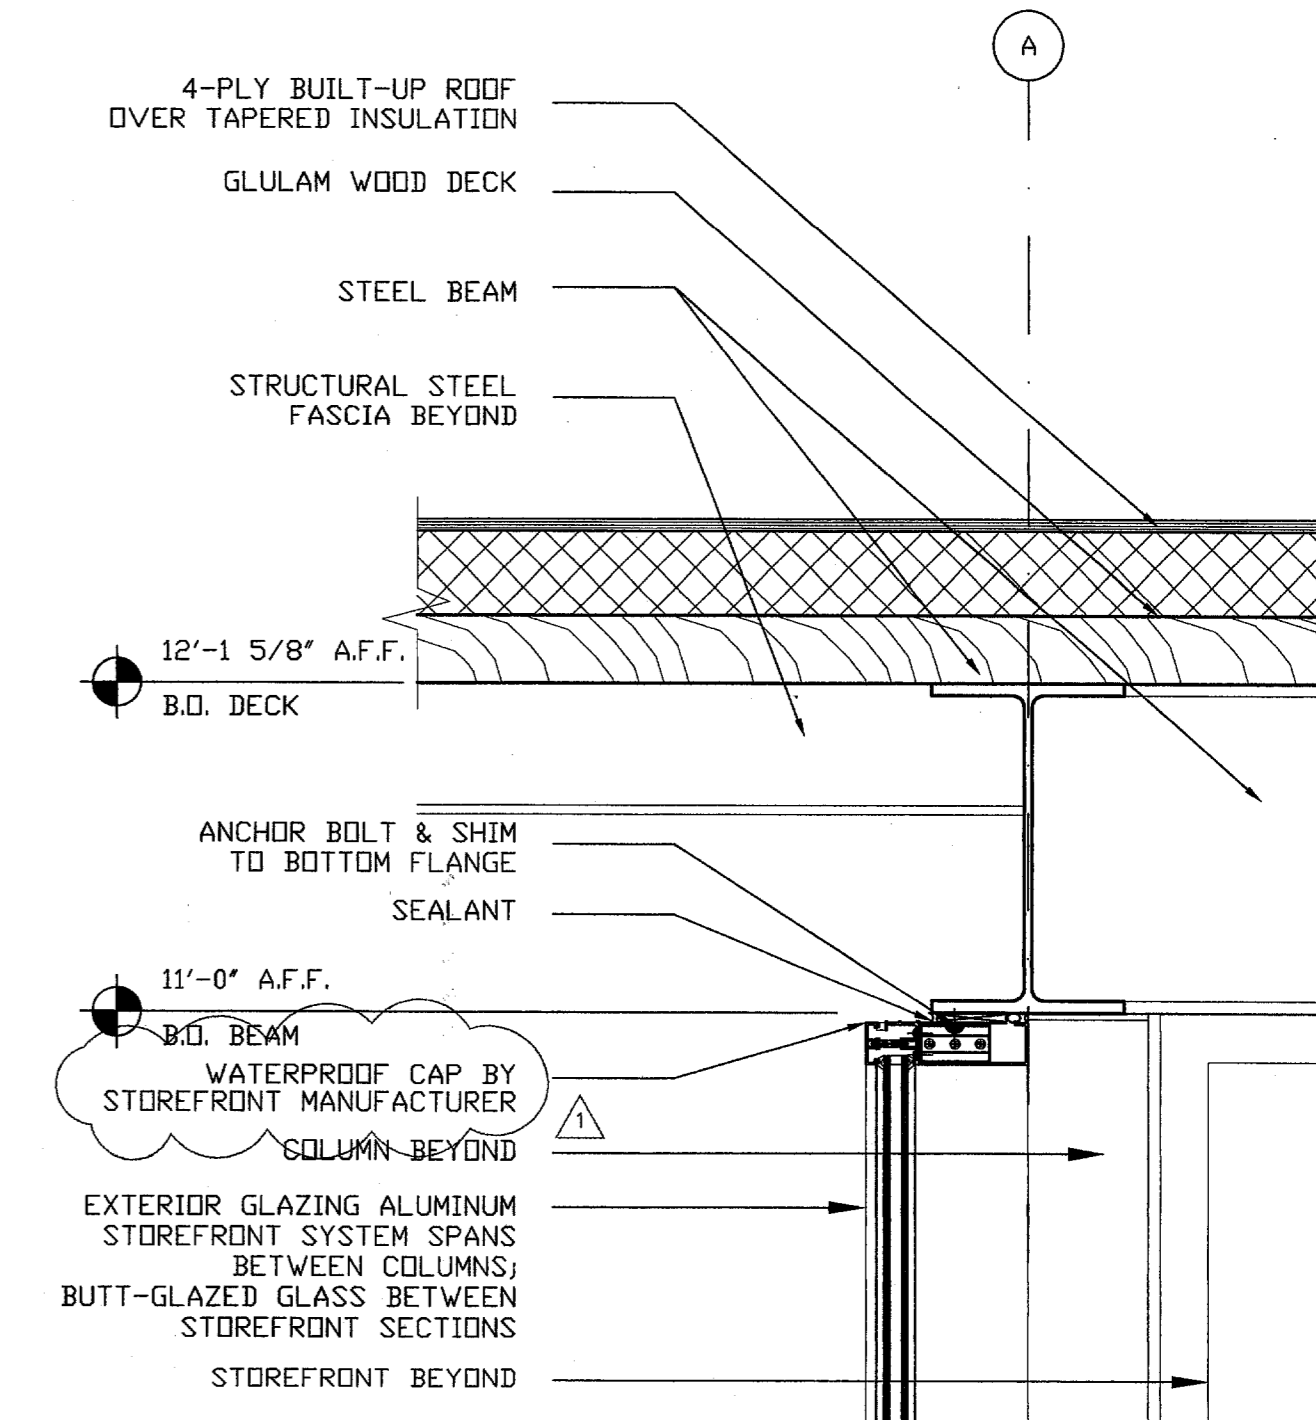

1 SECTION @ STOREFRONT
 SECTION DETAIL 1-1/2"=1'-0"

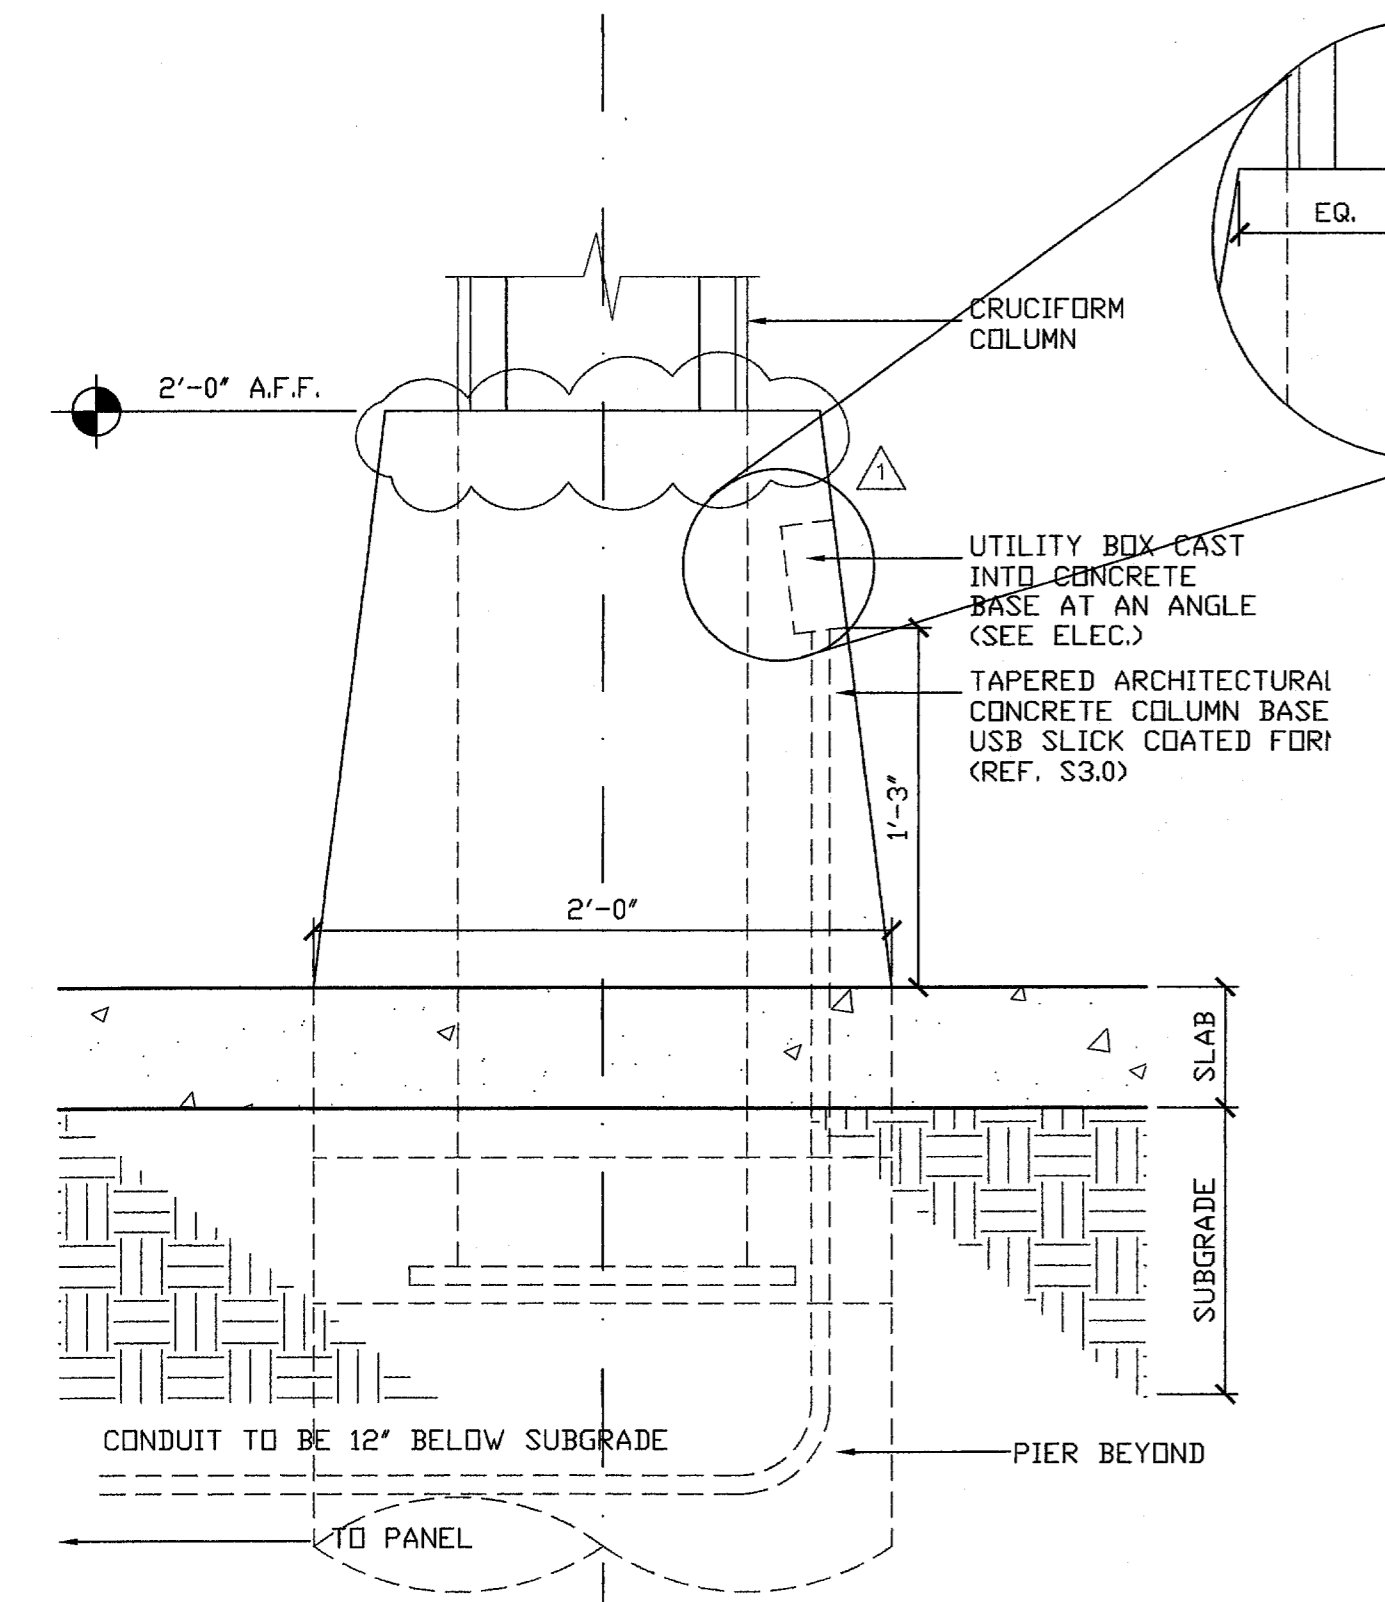

4 COLUMN BASE W/ J-BOX
 DETAILS 3/4"=1'-0"