




**6 CMU JOINT DTL. DETAILS**  
FULL SCALE

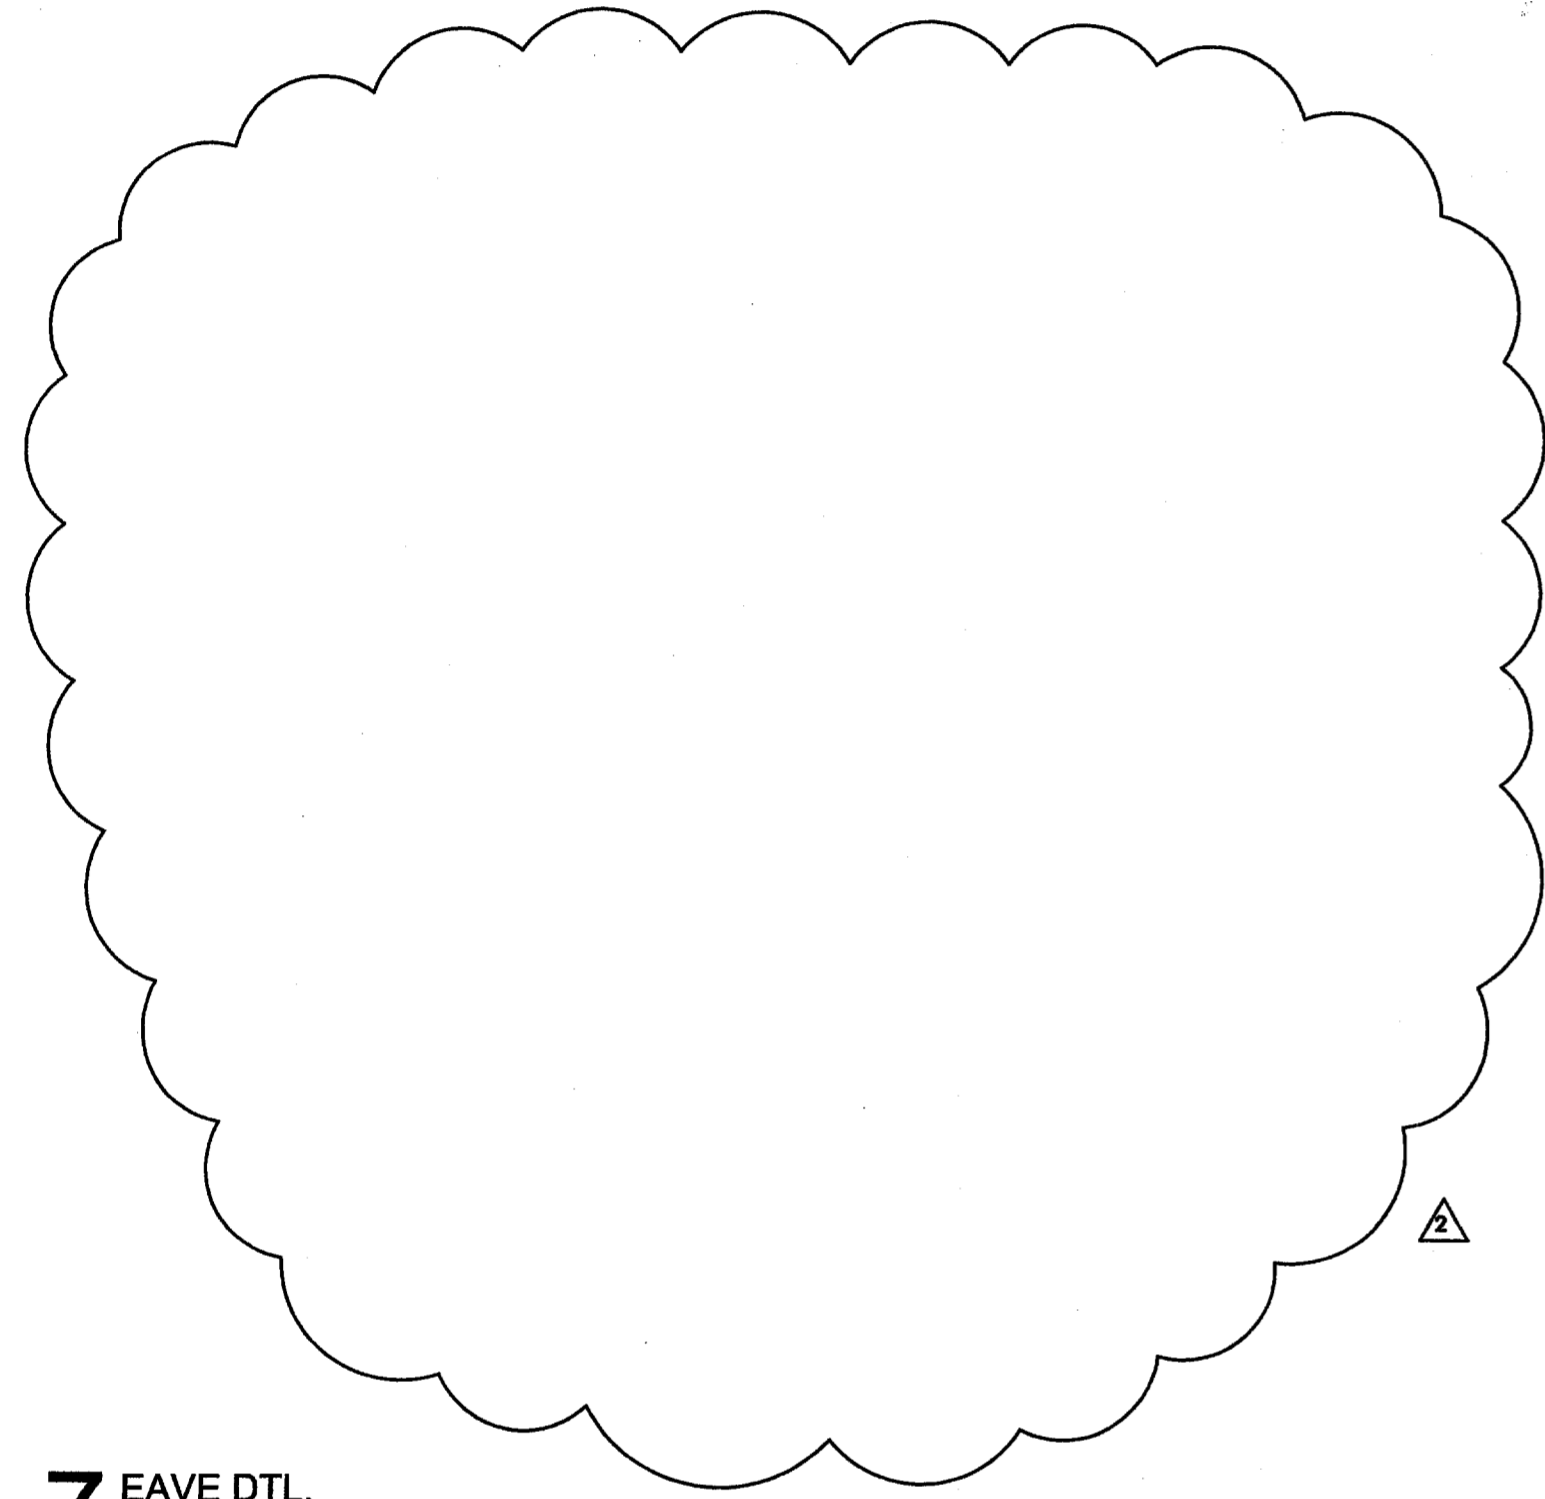


**7 EAVE DTL. DETAILS**  
1-1/2"=1'-0"

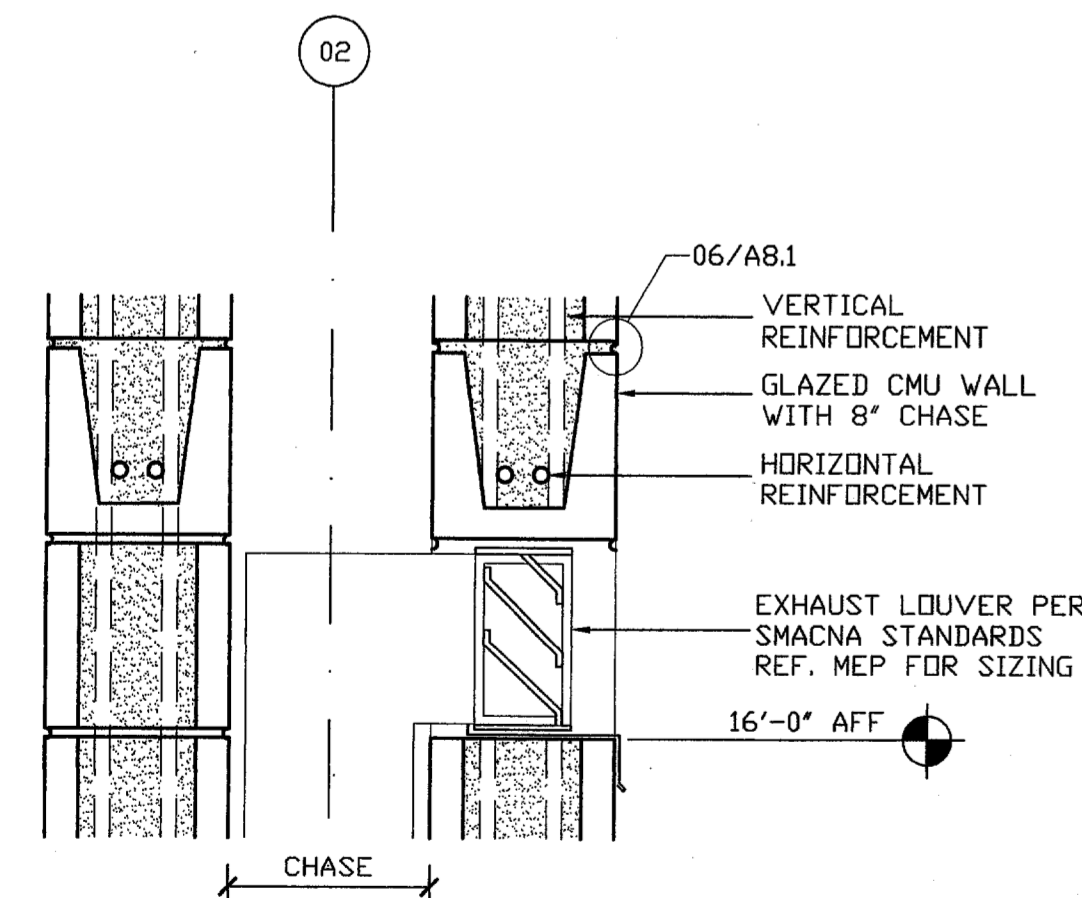


**3 CMU WALL LOUVER DETAIL**  
1-1/2"=1'-0"

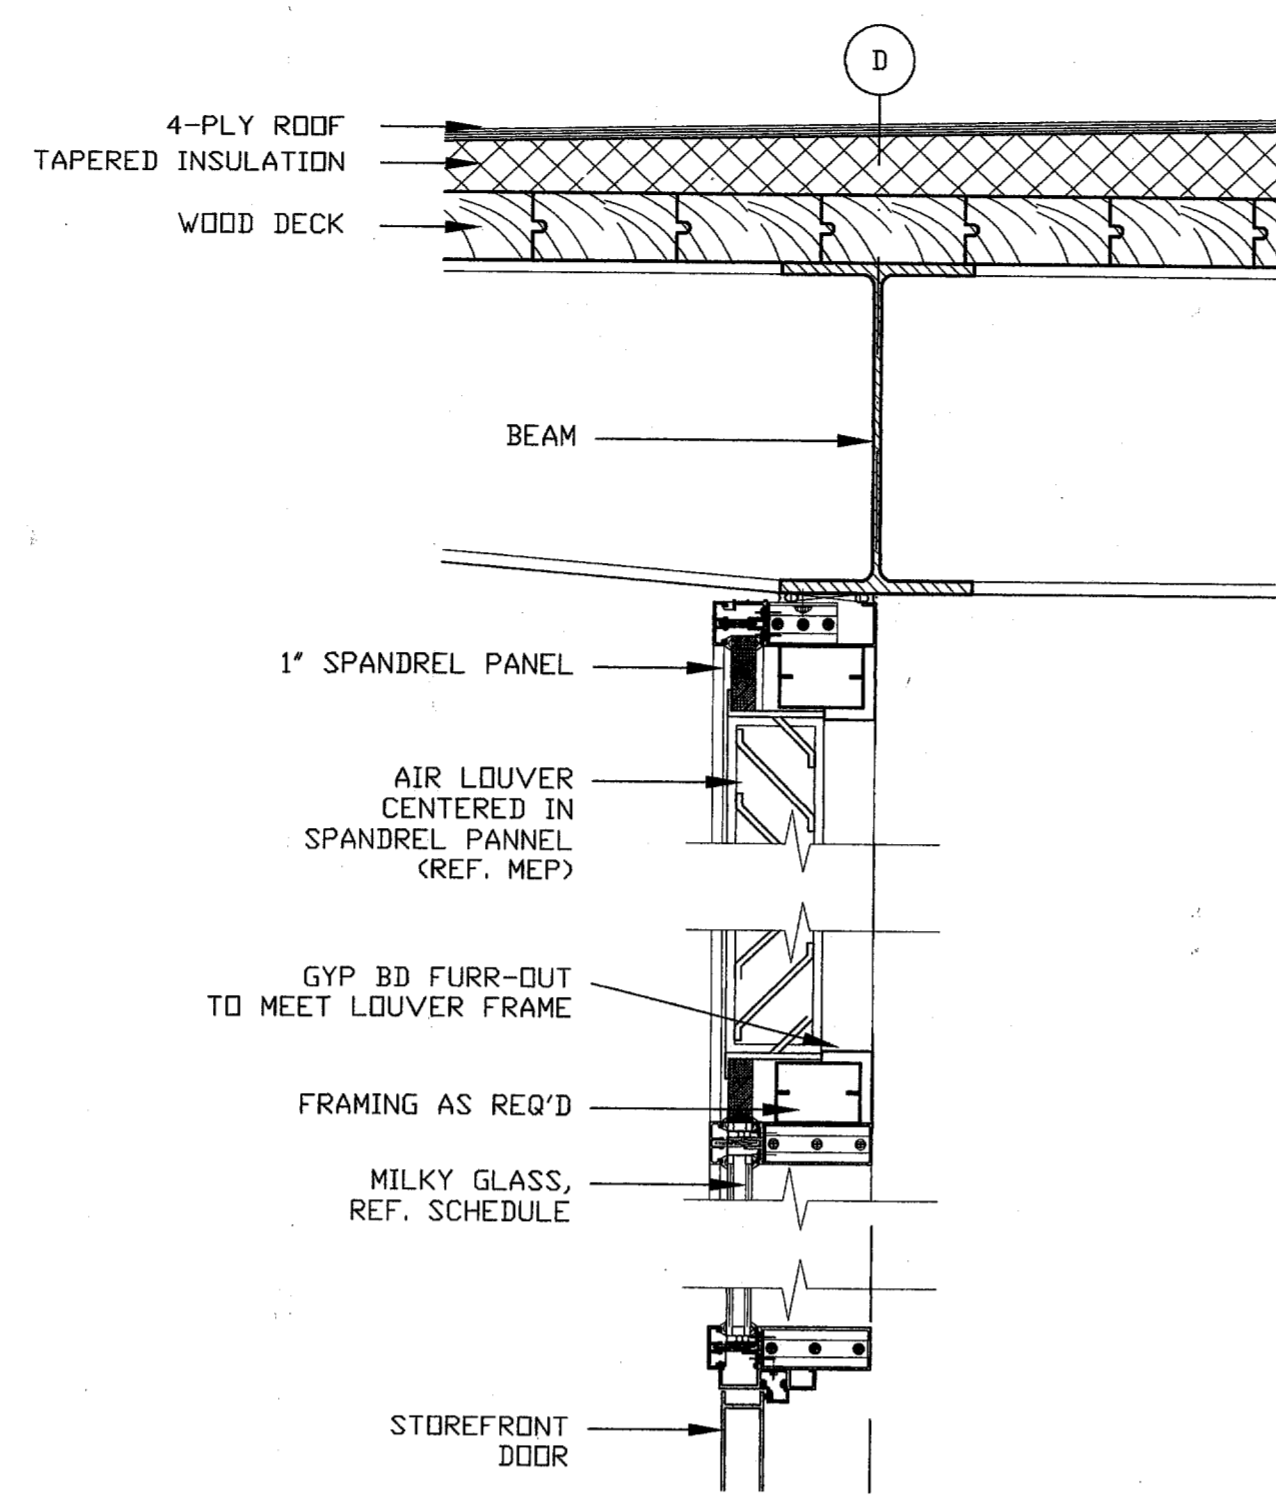


**5 SPANDREL DTL. @ LOUVER DETAILS**  
1-1/2"=1'-0"

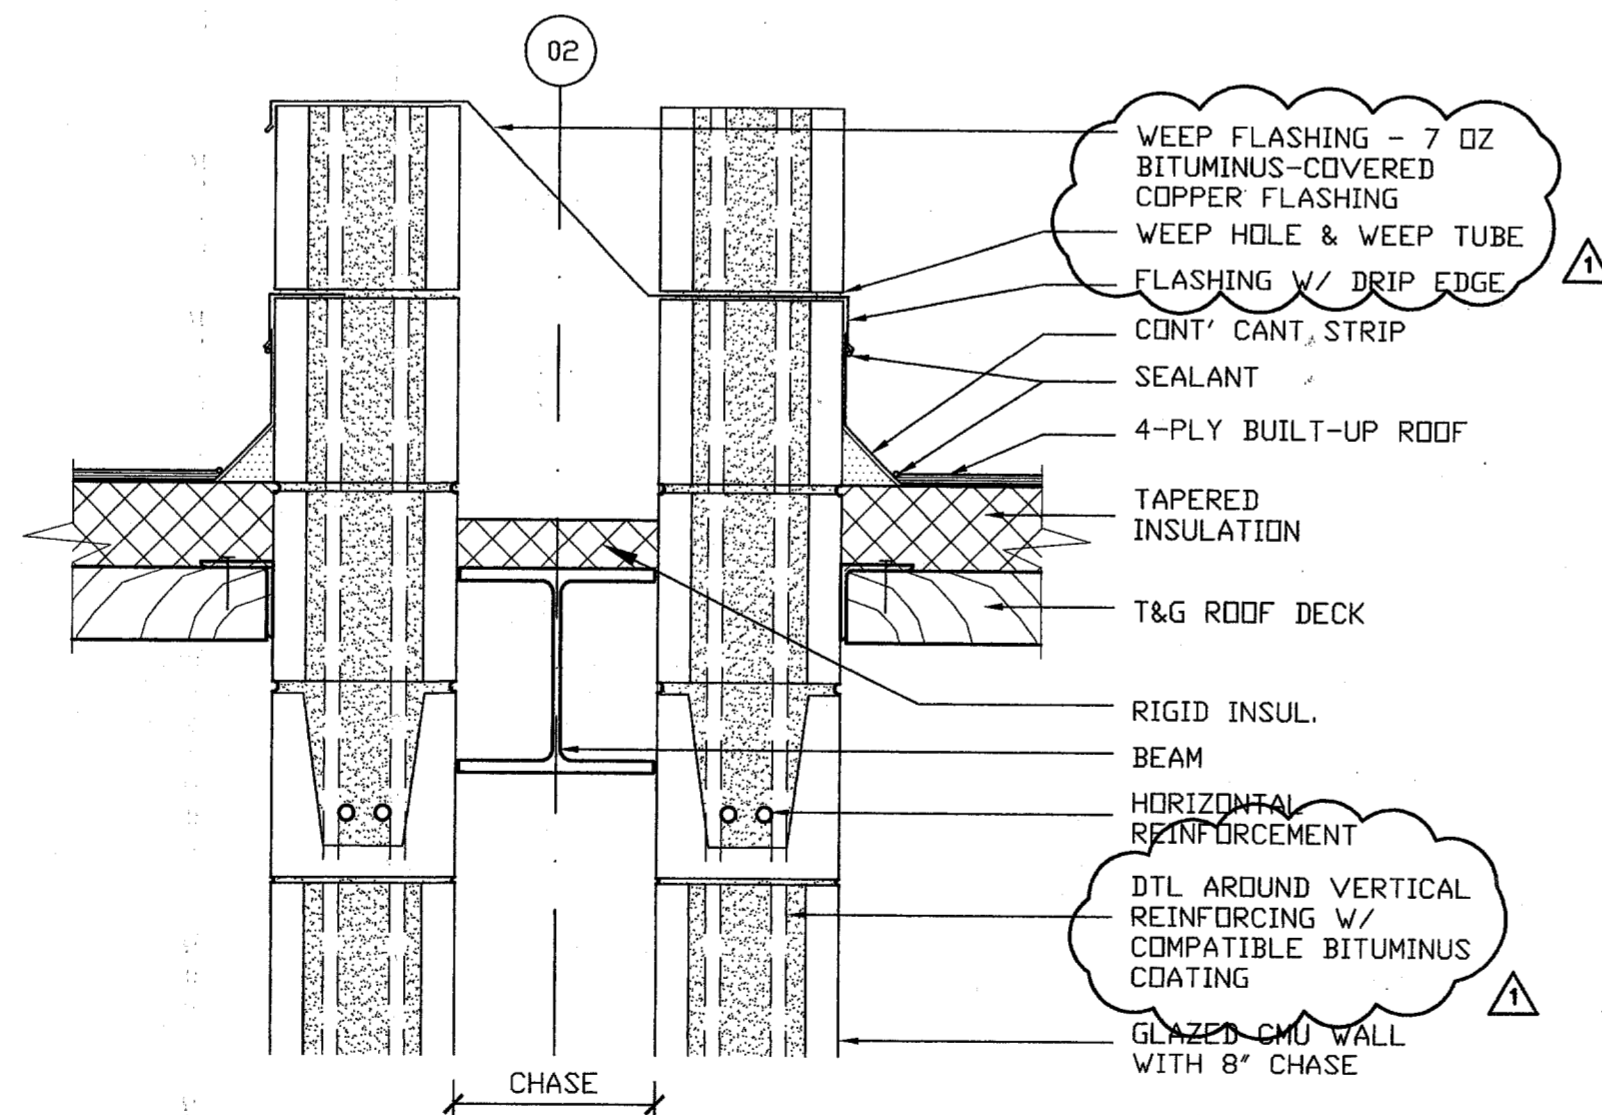


**4 CMU WALL @ ROOF DETAIL**  
1-1/2"=1'-0"

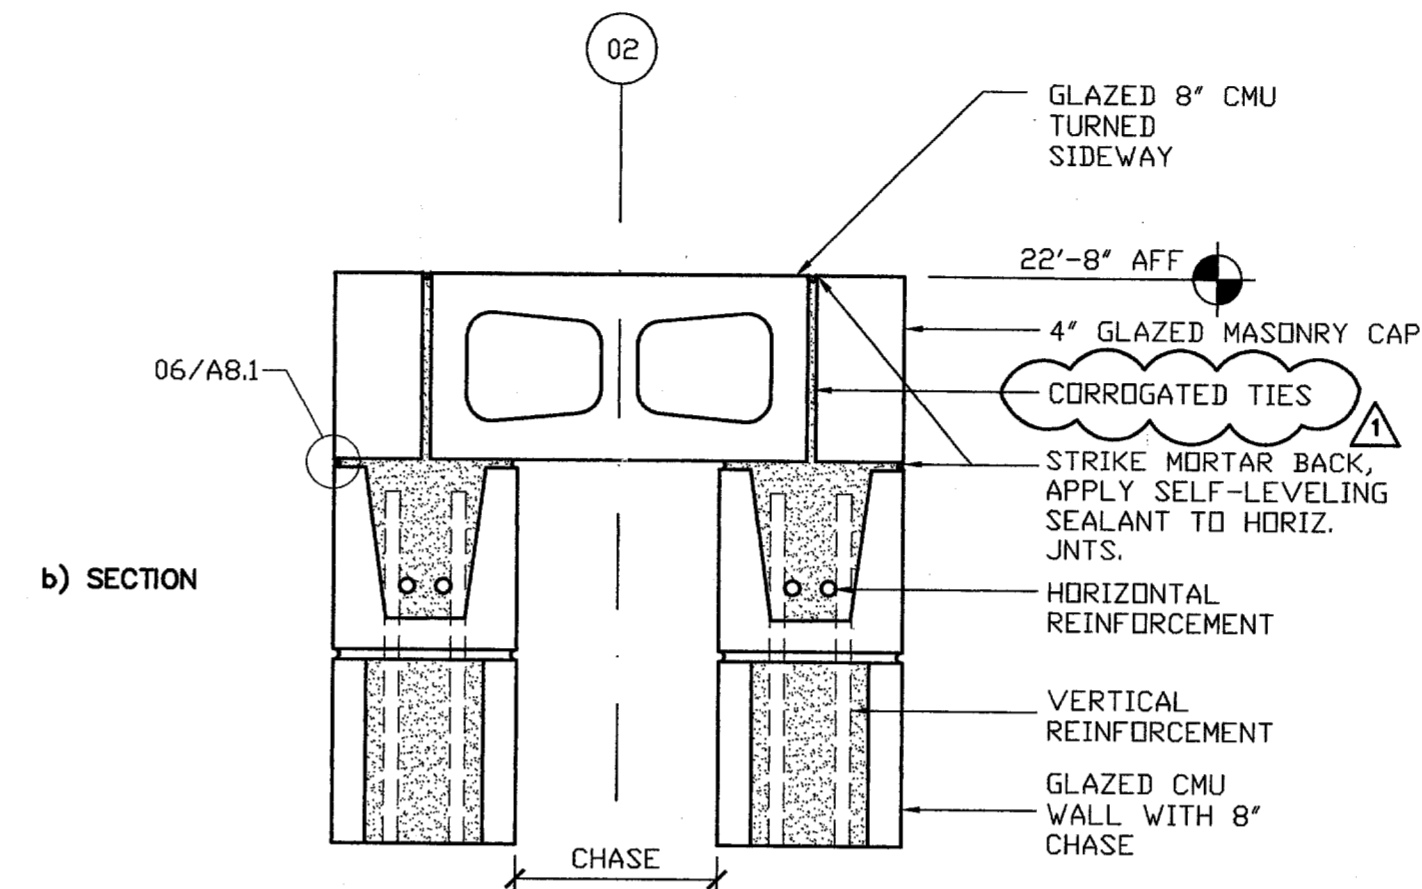

**2 CMU WALL CAP DETAIL**  
1-1/2"=1'-0"

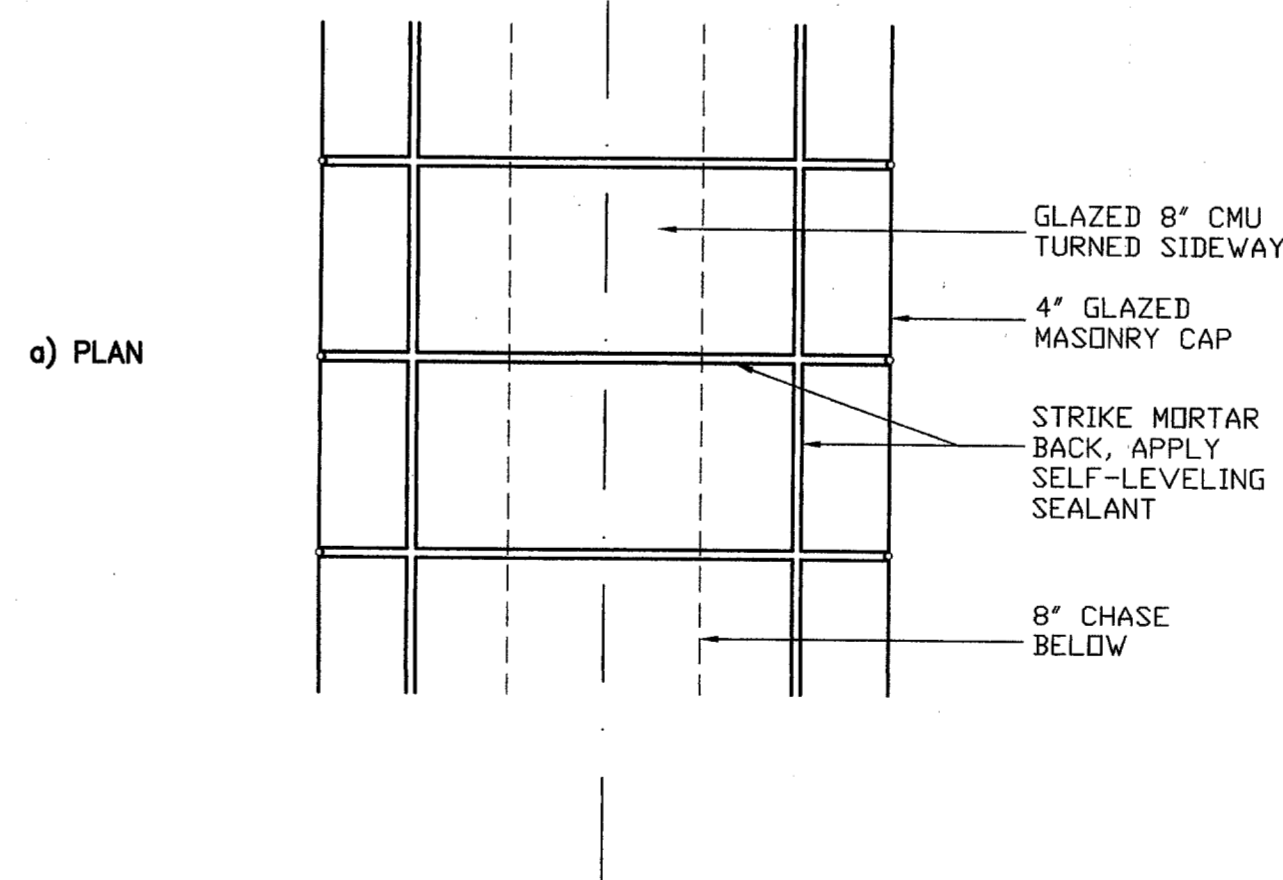

**1 SLIDING DOOR @ RESTROOMS DETAILS**  
1-1/2"=1'-0"

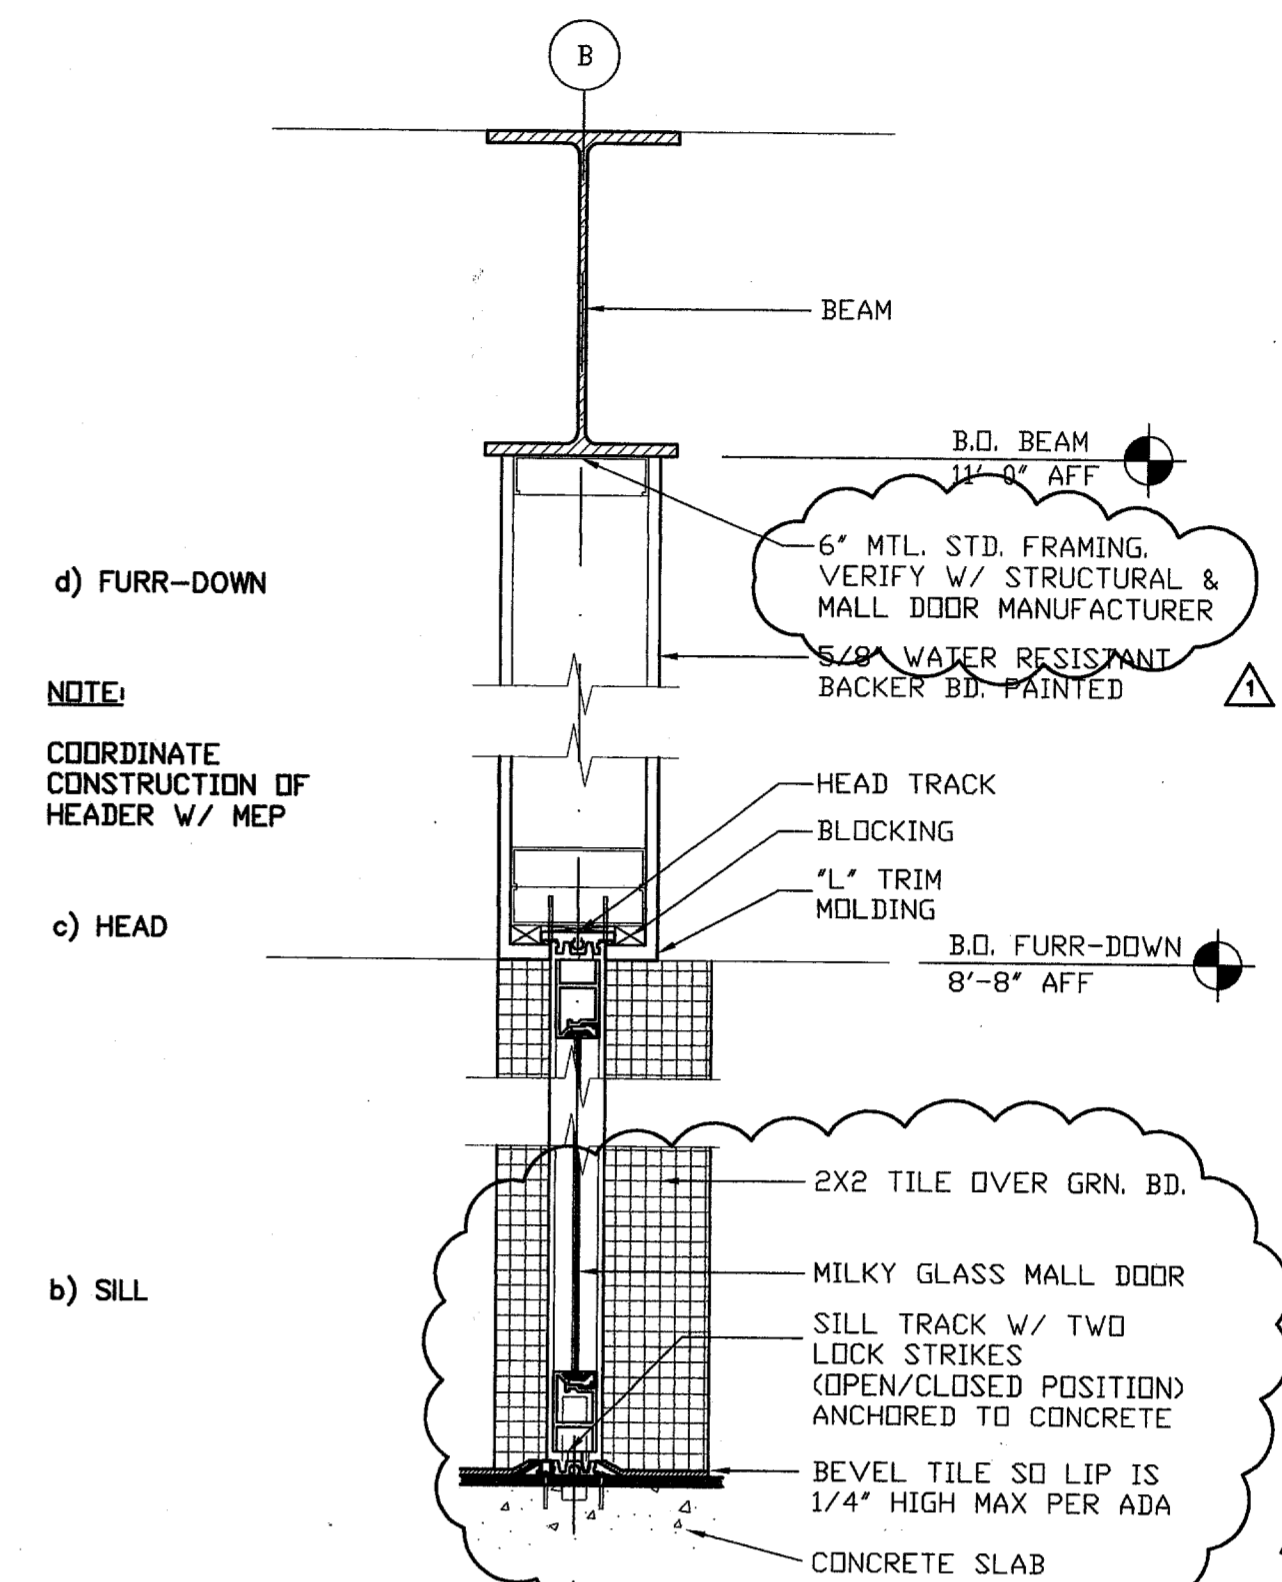

d) FURR-DOWN

NOTE:  
COORDINATE CONSTRUCTION OF HEADER W/ MEP

c) HEAD

b) SILL

a) JAMB



issue	date
DD	08/26/02
50% CD	11/05/02
100% CD	01/23/03
POST-BID REVISION	03/04/03