
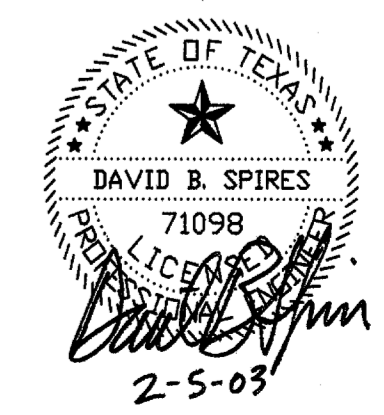


01 FOUNDATION PLAN
 SCALE: 3/16" = 1'-0"
 NORTH

- PLAN NOTES:**
- SEE S1.0 FOR GENERAL NOTES.
 - SEE S3.0 FOR TYPICAL DETAILS.
 - SLAB-ON-GRADE TO BE 5" THICK CONCRETE REINF. W/ #3 @ 14" o.c. EA. WAY, 2" FROM TOP. SEE ALSO GENERAL NOTES FOR MIX RESTRICTIONS. PROVIDE SUBGRADE PREPARATION AS SPECIFIED BY GEOTECHNICAL CONSULTANT TO REDUCE PVR TO ONE INCH OR LESS.
 - FLOOR DRAIN- SEE MEP DOCUMENTS FOR DETAILS, AND 05/AB.2 FOR LOCATIONS.
 - FLOOR SINK- SEE MEP DOCUMENTS FOR DETAILS AND 05/AB.2 FOR LOCATIONS. TOP OF SLAB EL. ADJACENT TO HOUSING 1/2" LOWER PER CITY OF ADDISON STANDARDS.
 - SLOPE SLAB TO MATCH ELEVATION OF PATIO THRESHOLD (SEE ARCH'L).
 - SLOPE SUBGRADE TO MAINTAIN 5" SLAB THICKNESS- DO NOT REDUCE THICKNESS TO CREATE SLOPE.
 - CONDENSOR UNIT MOUNTING RACKS ABOVE, SEE DETAIL 02/THIS DWG.
 - CIP PAD FOR SWITCH GEAR- SEE MEP DOCUMENTS. REINF. SAME AS SLAB-ON-GRADE (ADD'L).

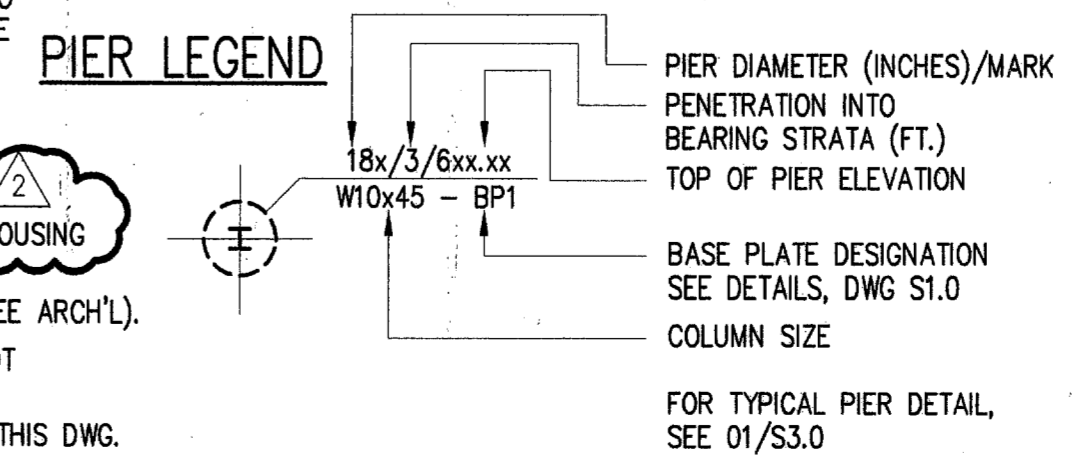

date 12/24/02
 1/23/03
 1/31/03
 2/06/03

issue 95% CD
 100% CD
 ADDM 1
 ADDM 2

S2.0
 FOUNDATION PLAN