


TOWN OF
ADDISON
DALLAS COUNTY, TEXAS

CONSTRUCTION PLANS FOR

MILDRED STREET IMPROVEMENTS

As Built

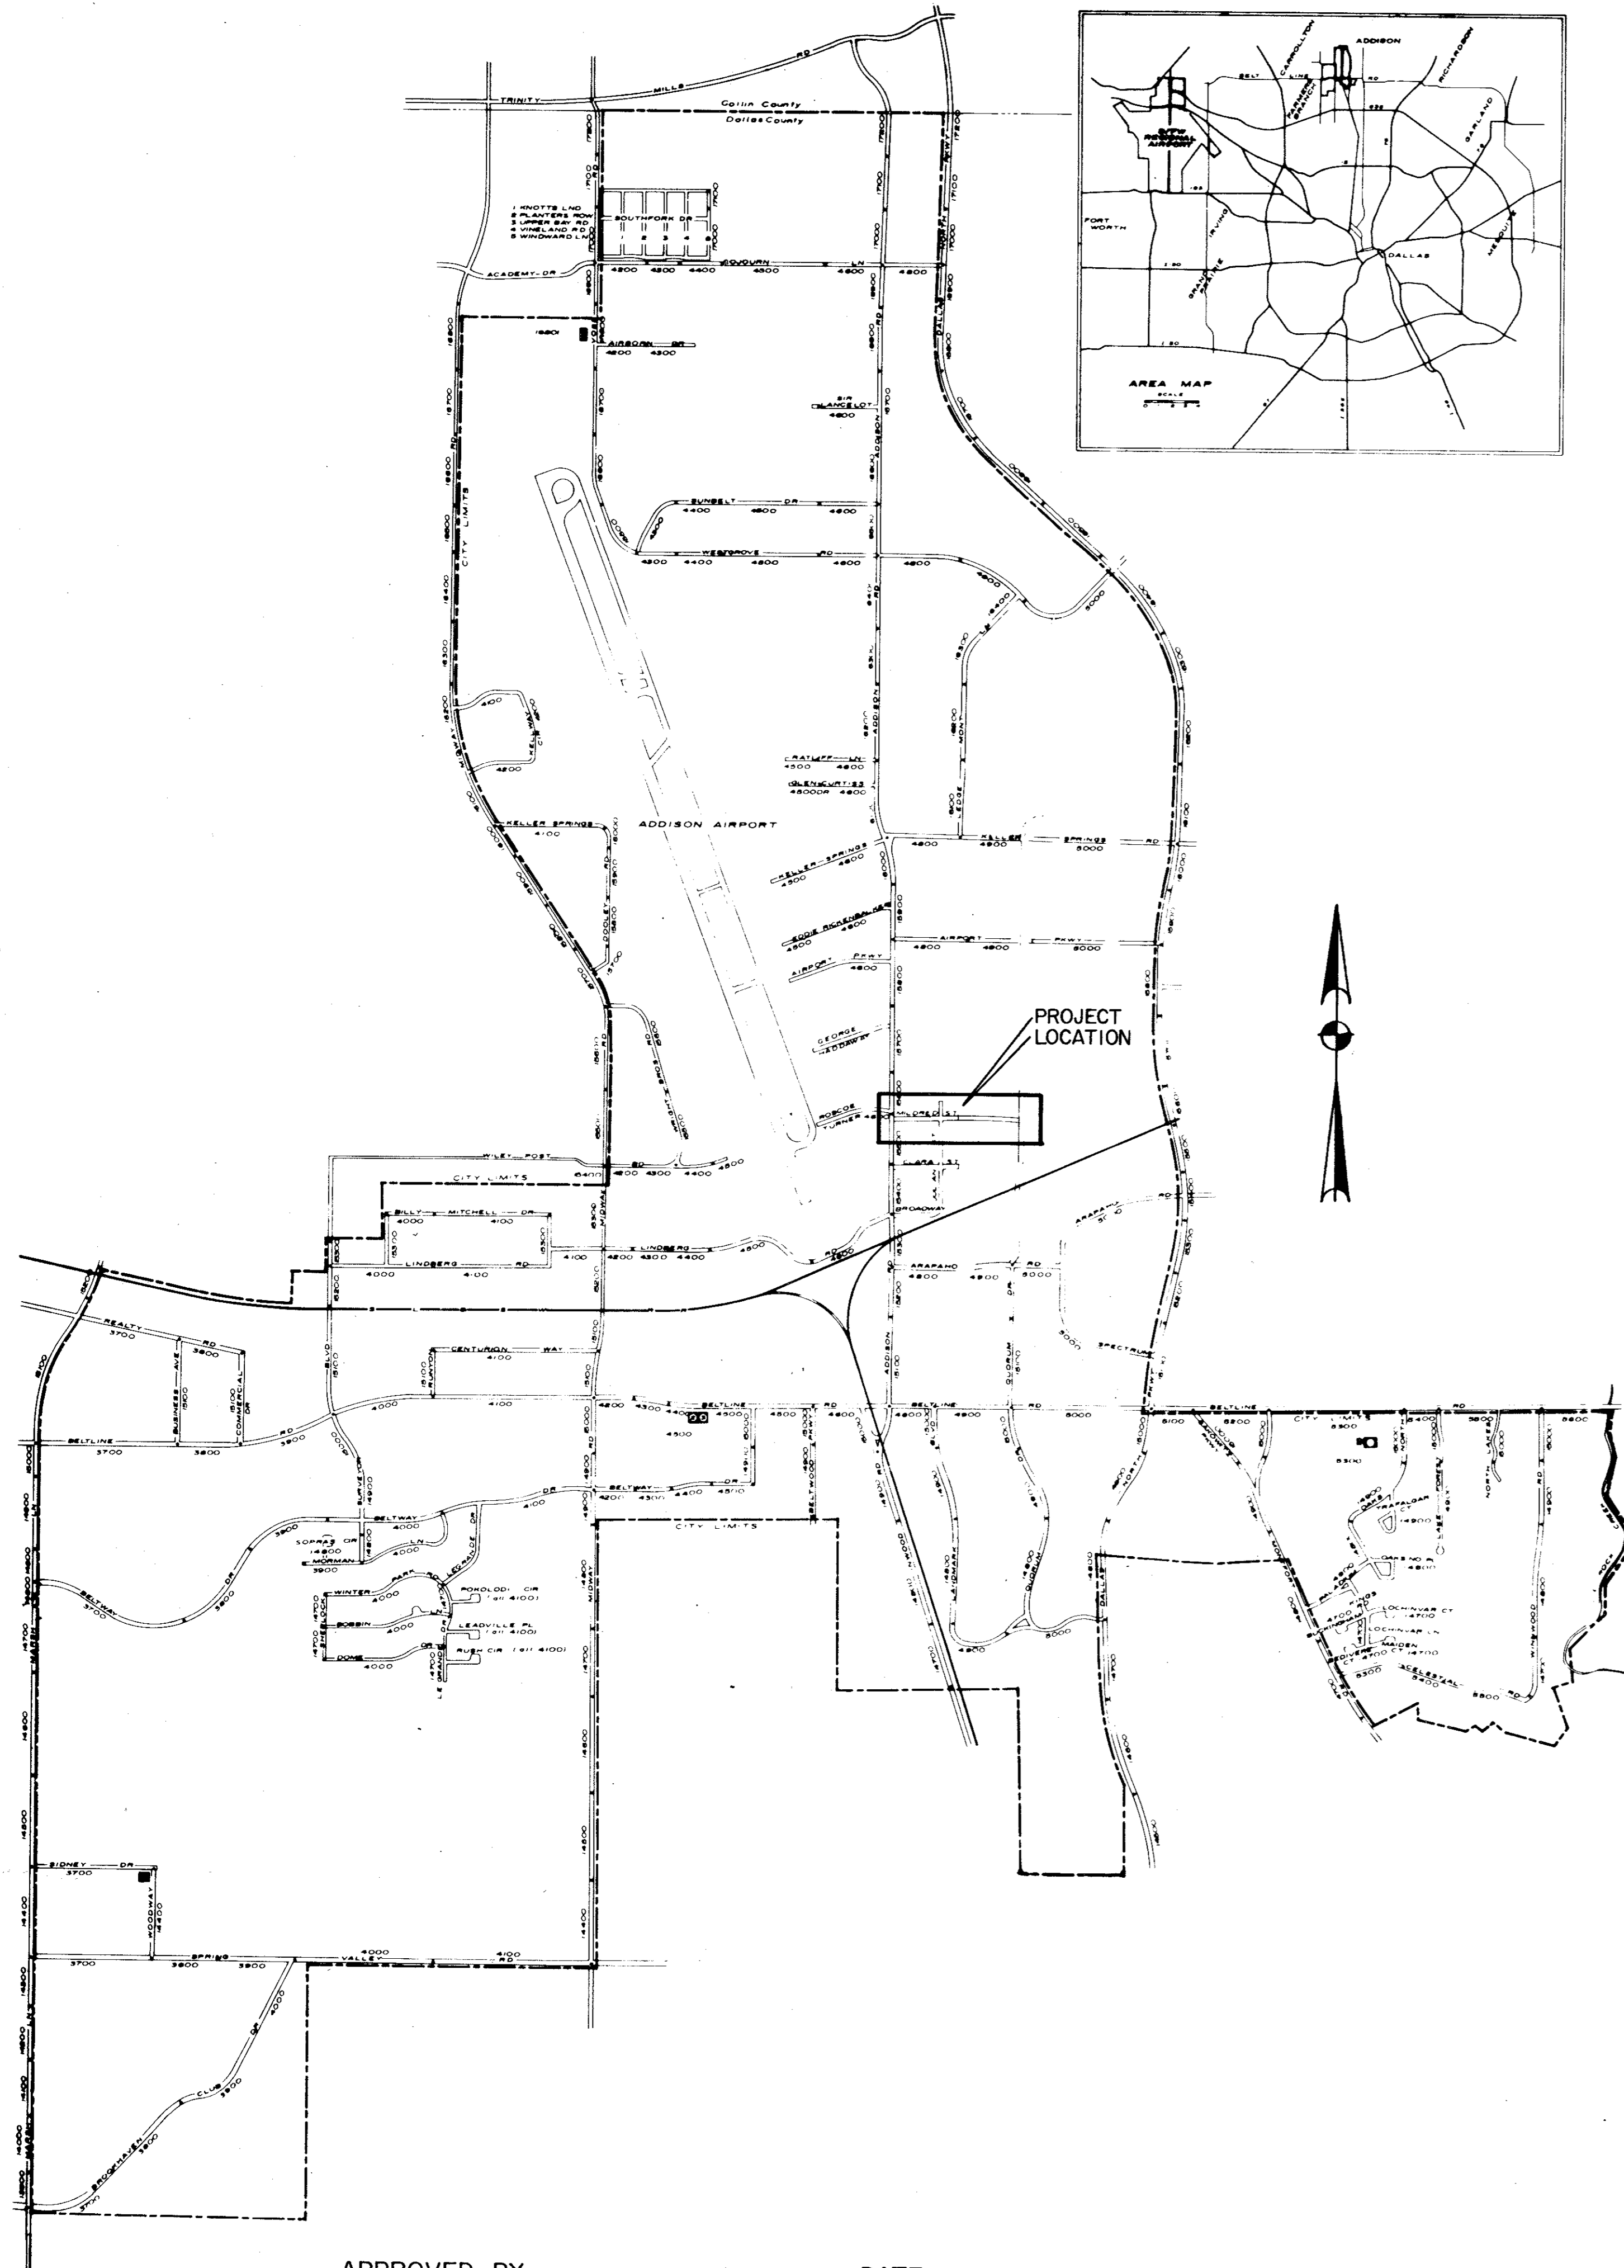

APPROVED BY: _____ DATE: _____
D. LYNN SPRUILL, MAYOR

MAYOR:
D. LYNN SPRUILL

COUNCIL MEMBERS:
JOHN BRANCH
MARY DOLAN
JIM DUFFY
DAVID GRANOFF
RILEY REINKER

CITY MANAGER:
RON WHITEHEAD


DIRECTOR OF STREETS:
ROBIN JONES

DIRECTOR OF UTILITIES:
DON PREECE

DIRECTOR OF PARKS:
SLADE STRICKLAND

INDEX TO DRAWINGS

Sheet No.	Description
	COVER SHEET
M1	PAVING, STA. 0+00 TO STA. 5+00
M2	PAVING, STA. 5+00 TO STA. 8+50
M3	PAVING, STA. 8+50 TO STA. 11+45
M4	STANDARD DETAILS-PAVING
M5	STANDARD DETAILS-PAVING
M6	STANDARD DETAILS-PAVING
M7	STANDARD DETAILS-PAVING
M8	DRAINAGE AREA MAP
M9	DRAINAGE, STA. 0+00 TO STA. 5+00
M10	DRAINAGE, STA. 5+00 TO STA. 8+50
M11	DRAINAGE, STA. 8+50 TO STA. 11+45
M12	STANDARD DETAILS, DRAINAGE
S1	SANITARY SEWER LOCATION MAP
S2	SANITARY SEWER PLAN
S3	SANITARY SEWER - MILDRED STREET
S4	SANITARY SEWER - MILDRED STREET
S5	SANITARY SEWER - PROFILES
S6	SANITARY SEWER - JULIAN TO QUORUM
S7	SANITARY SEWER - QUORUM TO DALLAS NORTH TOLLWAY
S8	STANDARD DETAILS, SANITARY SEWER
S9	STANDARD DETAILS, SANITARY SEWER
S10	STANDARD DETAILS, SANITARY SEWER

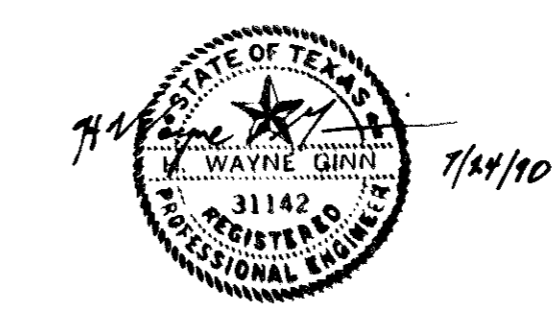

GINN, INC.
Consulting Engineers Dallas, Texas
JUNE, 1990