


RUNOFF COMPUTATIONS								
No.	AREA Acres	C Factor	Total CA	T <sub>c</sub> Minutes (10 min. Minimum)	10 Year		100 Year	
					Q <sub>10</sub> c.f.s.	Q <sub>100</sub> c.f.s.	Q <sub>10</sub> in./hr.	Q <sub>100</sub> in./hr.
A	0.28	0.9	0.25	10	7.9	2.0	11.6	2.9
B	0.22		0.20			1.6	2.3	
C	0.67		0.60			4.8	7.0	
D	0.21		0.20			1.5	2.2	
E	0.39		0.35			2.8	4.1	
F	0.26		0.23			1.8	2.7	
G	0.13		0.12			0.9	1.4	
H	0.10		0.09			0.7	1.0	
I	0.06		0.05			0.4	0.6	
J	0.04		0.04			0.3	0.4	
K	0.68		0.61			4.8	7.1	
L	1.86		1.67			13.2	19.4	

REVISIONS AUG 1988  
 Compiled from aerial photographs taken February 25, 1986 with the Wild RC-8 camera. Horizontal and vertical control was extended from existing U.S. Coast and Geodetic Survey monuments. Further densification was performed by Aero Tranquation using the Wild BC-1 Aviolet.



Grid lines and values shown are based on the Texas State Coordinate System, North Central Zone.

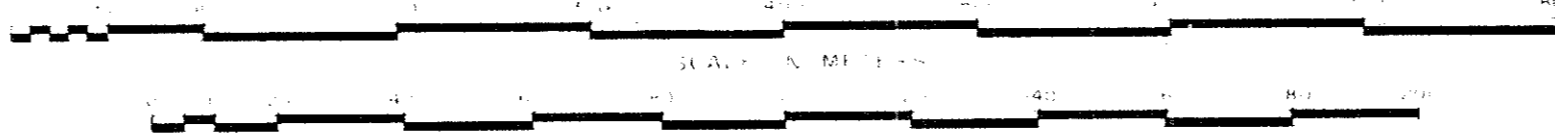

TOWN OF ADDISON, DALLAS COUNTY, TEXAS *As Built*  
**MILDRED STREET IMPROVEMENTS**  
**DRAINAGE AREA MAP**  
 GINN, INC.  
 Consulting Engineers Dallas, Texas  
 Designed - TEC Drawn - TEC Date - June, 1990 Job No. - 90439  
 Approved - HWG Checked - GF Scale - 1" = 100' Sheet MS of 12

