

REVISIONS:	
DATE	DESCRIPTION
3-19-93	CITY REVIEW COMMENTS

PREPARED BY:
DEWEY & ASSOCIATES
 ENGINEERING, SURVEYING
 LAND PLANNING, CAD DESIGNS
 D & A
 2505 TEXAS DRIVE, SUITE 110 - IRVING, TEXAS 75062 - 214/255-1501

PREPARED FOR:
OUTBACK STEAKHOUSE
 550 NORTH REO STREET, SUITE 204
 TAMPA, FLORIDA 33609
 PHONE: (813) 282-1225
 FAX: (813) 282-1209


OUTBACK STEAKHOUSE
 QUORUM CENTRE ADDITION
 ADDISON ROAD
 TOWN OF ADDISON, TEXAS

SHEET TITLE
SITE DIMENSIONAL CONTROL PLAN

DATE: FEB. 19, 1993
 SCALE: 1" = 20'
 DRAWN BY: SAS (ACAD)
 CHECKED BY: JDJ
 SHEET NO.
C1 of 5


B12-10

B12-10

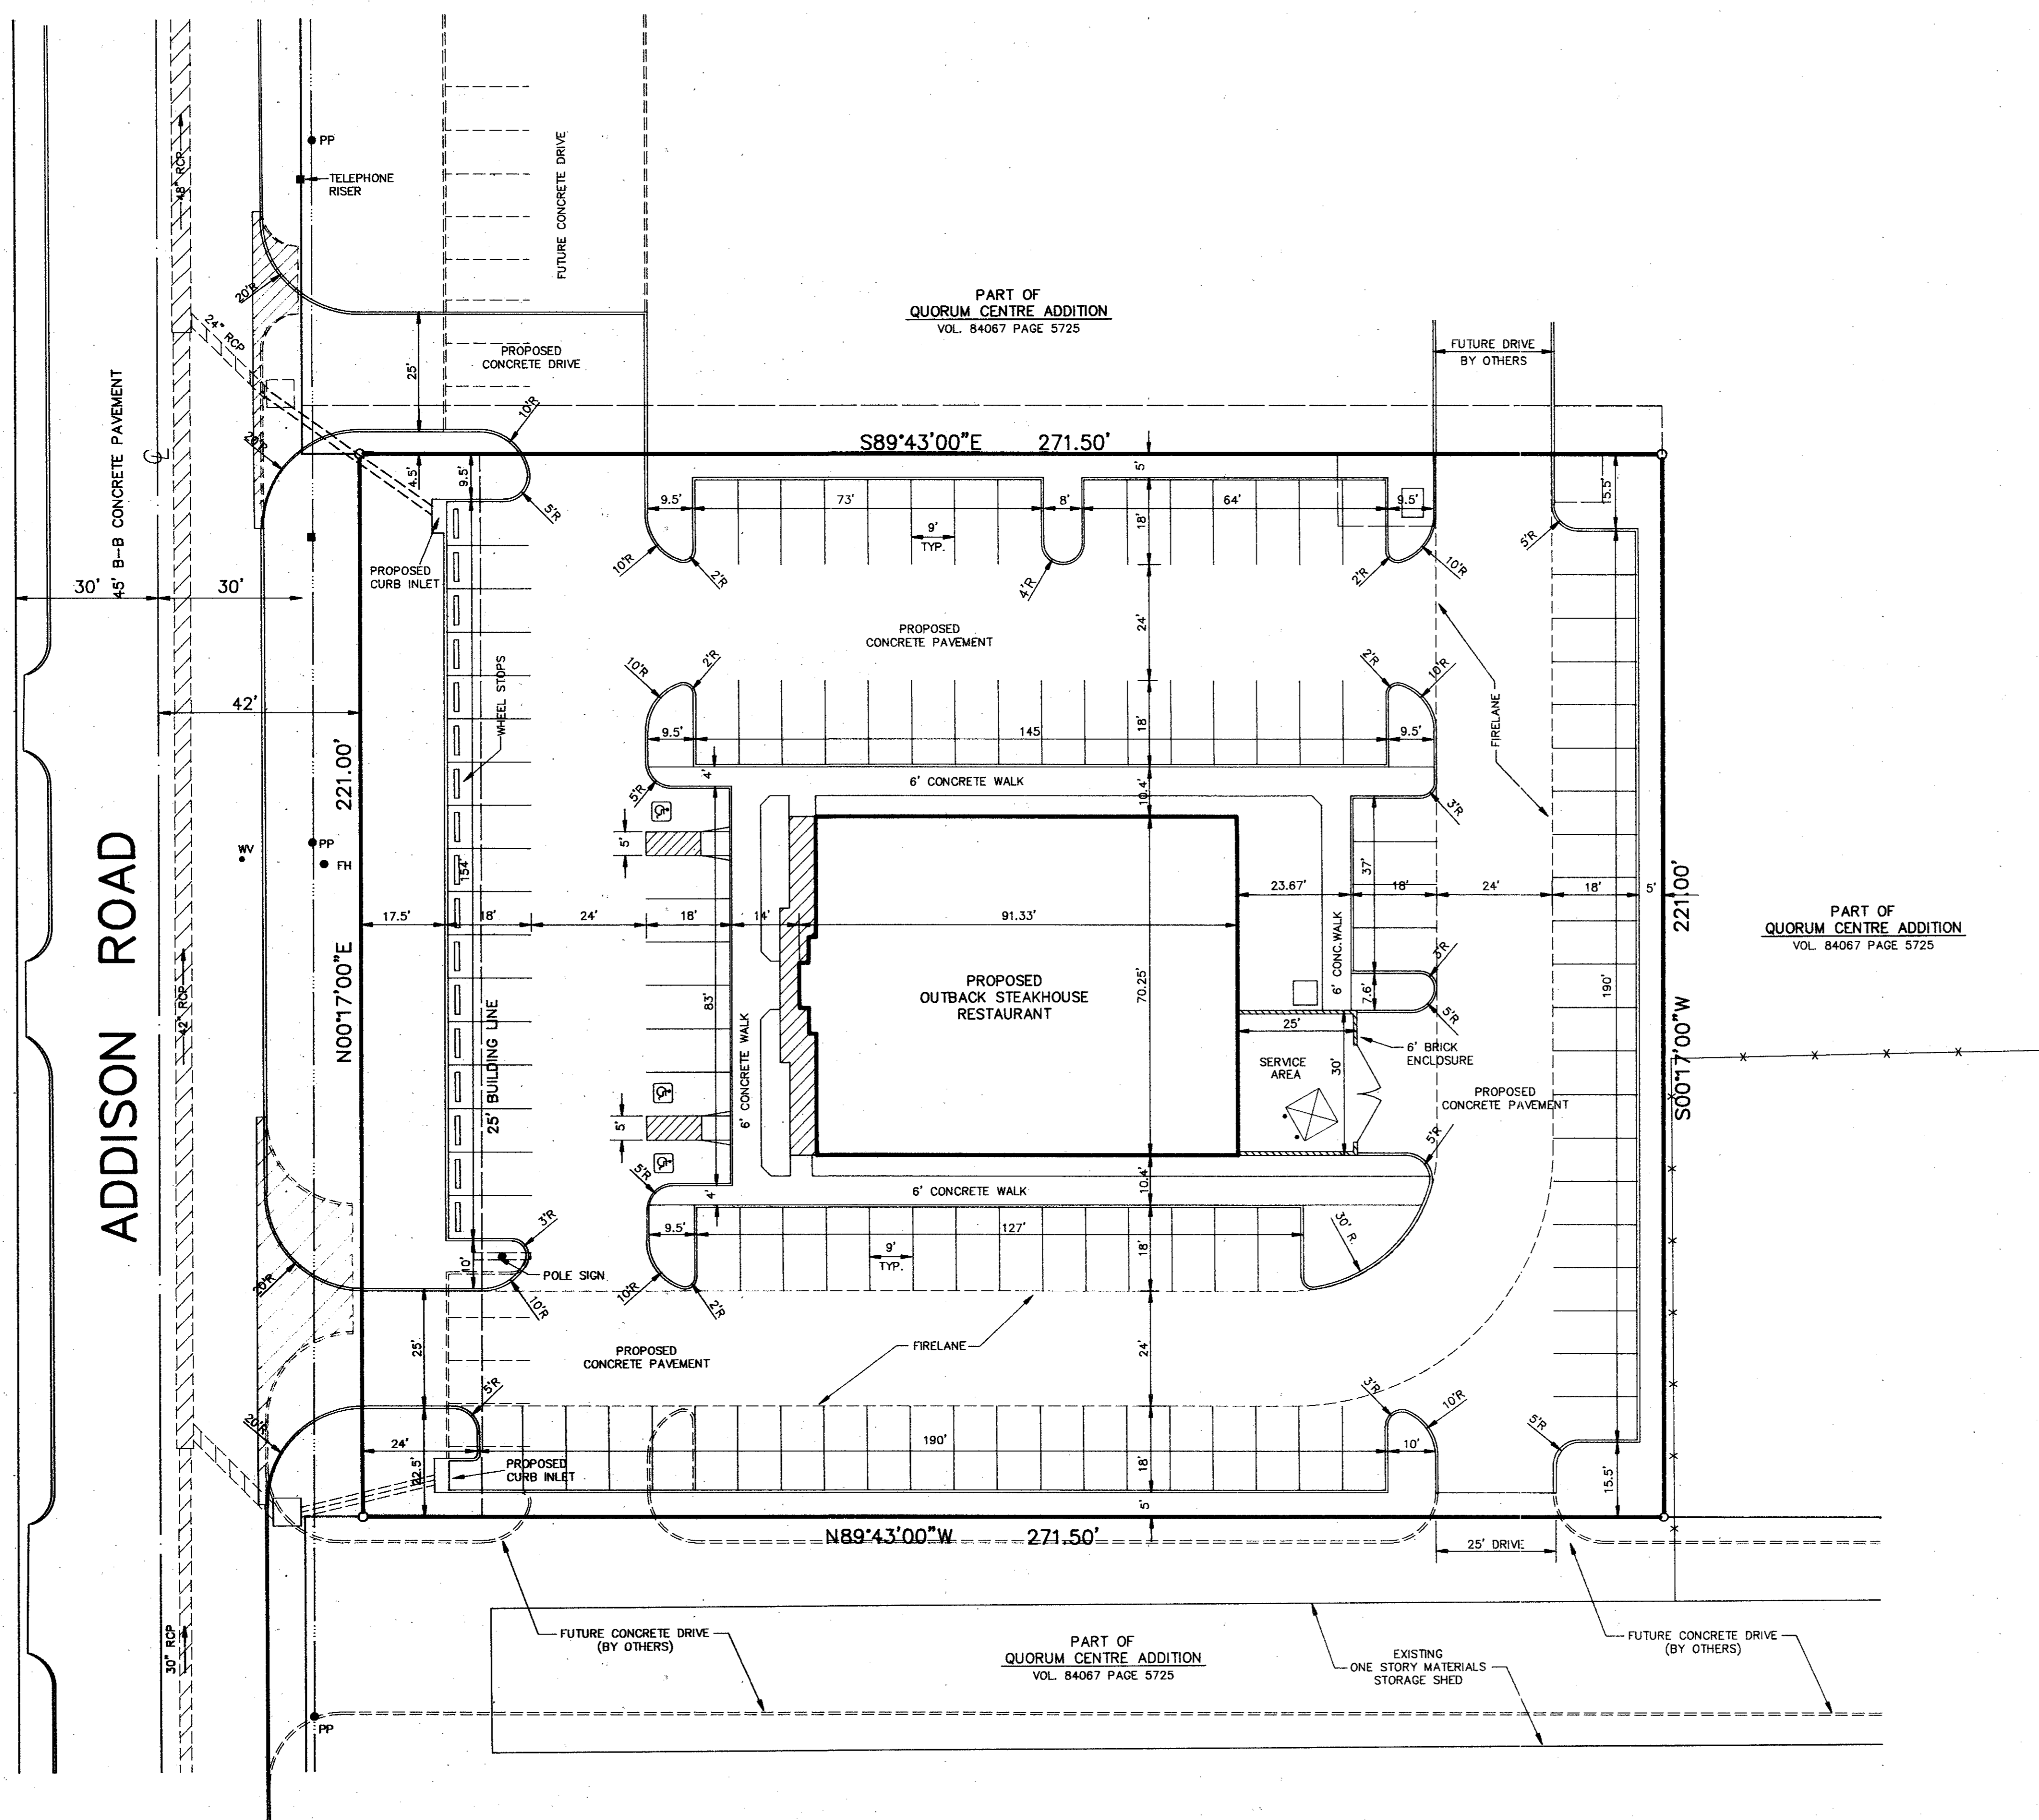

- NOTES:
1. ALL CONSTRUCTION TO BE DONE IN STRICT ACCORDANCE TO THESE PLANS AND ALL APPLICABLE MUNICIPAL CODES AND STANDARDS.
 2. ALL DIMENSIONS SHOWN ARE TO THE BACK OF CURB UNLESS OTHERWISE NOTED.
 3. SEE ARCHITECTURAL PLANS FOR ALL BUILDING DIMENSIONS AND DETAILS.
 4. SEE SHEET C2 FOR ALL PAVING AND GRADING PLANS.
 5. SEE SHEET C4 FOR PAVEMENT JOINT LOCATIONS AND DETAILS.
 6. SEE SHEET C5 FOR LOCATIONS AND DETAILS OF WATER AND SANITARY SEWER SERVICES TO BUILDING.

AS-BUILT

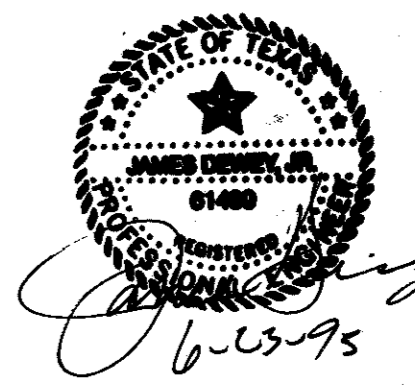

617