



811
DRAWN: FEC
DATE: 10/2/98
REVISIONS:

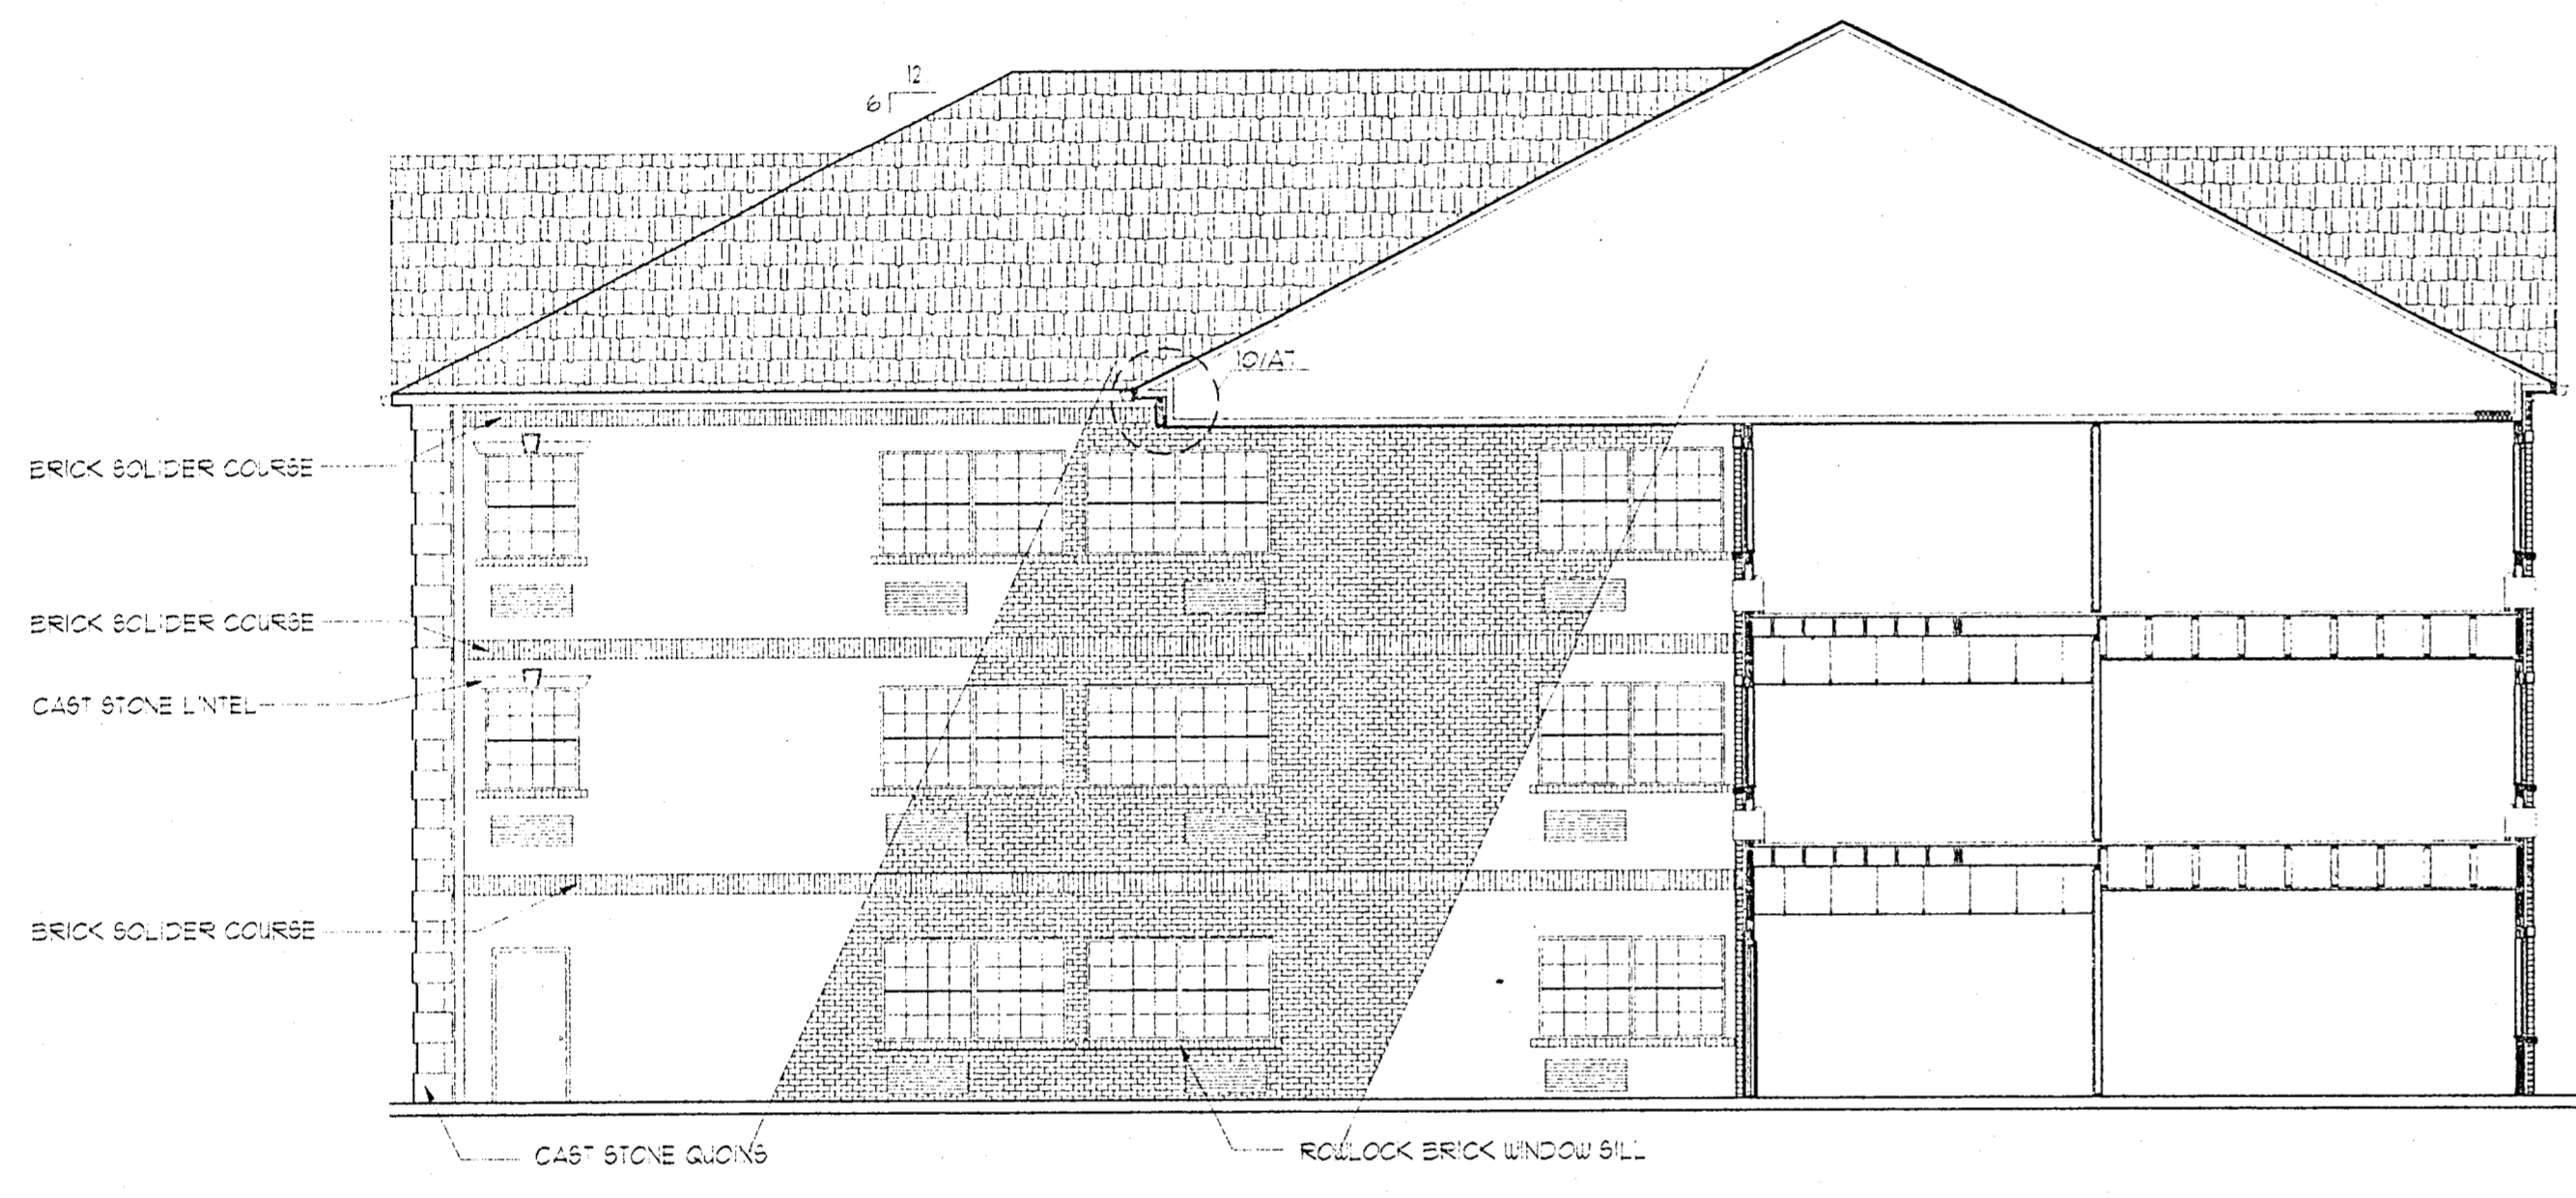


3 ELEVATION
SCALE: 1/8" = 1'-0"
EXT-ELEV.DWG

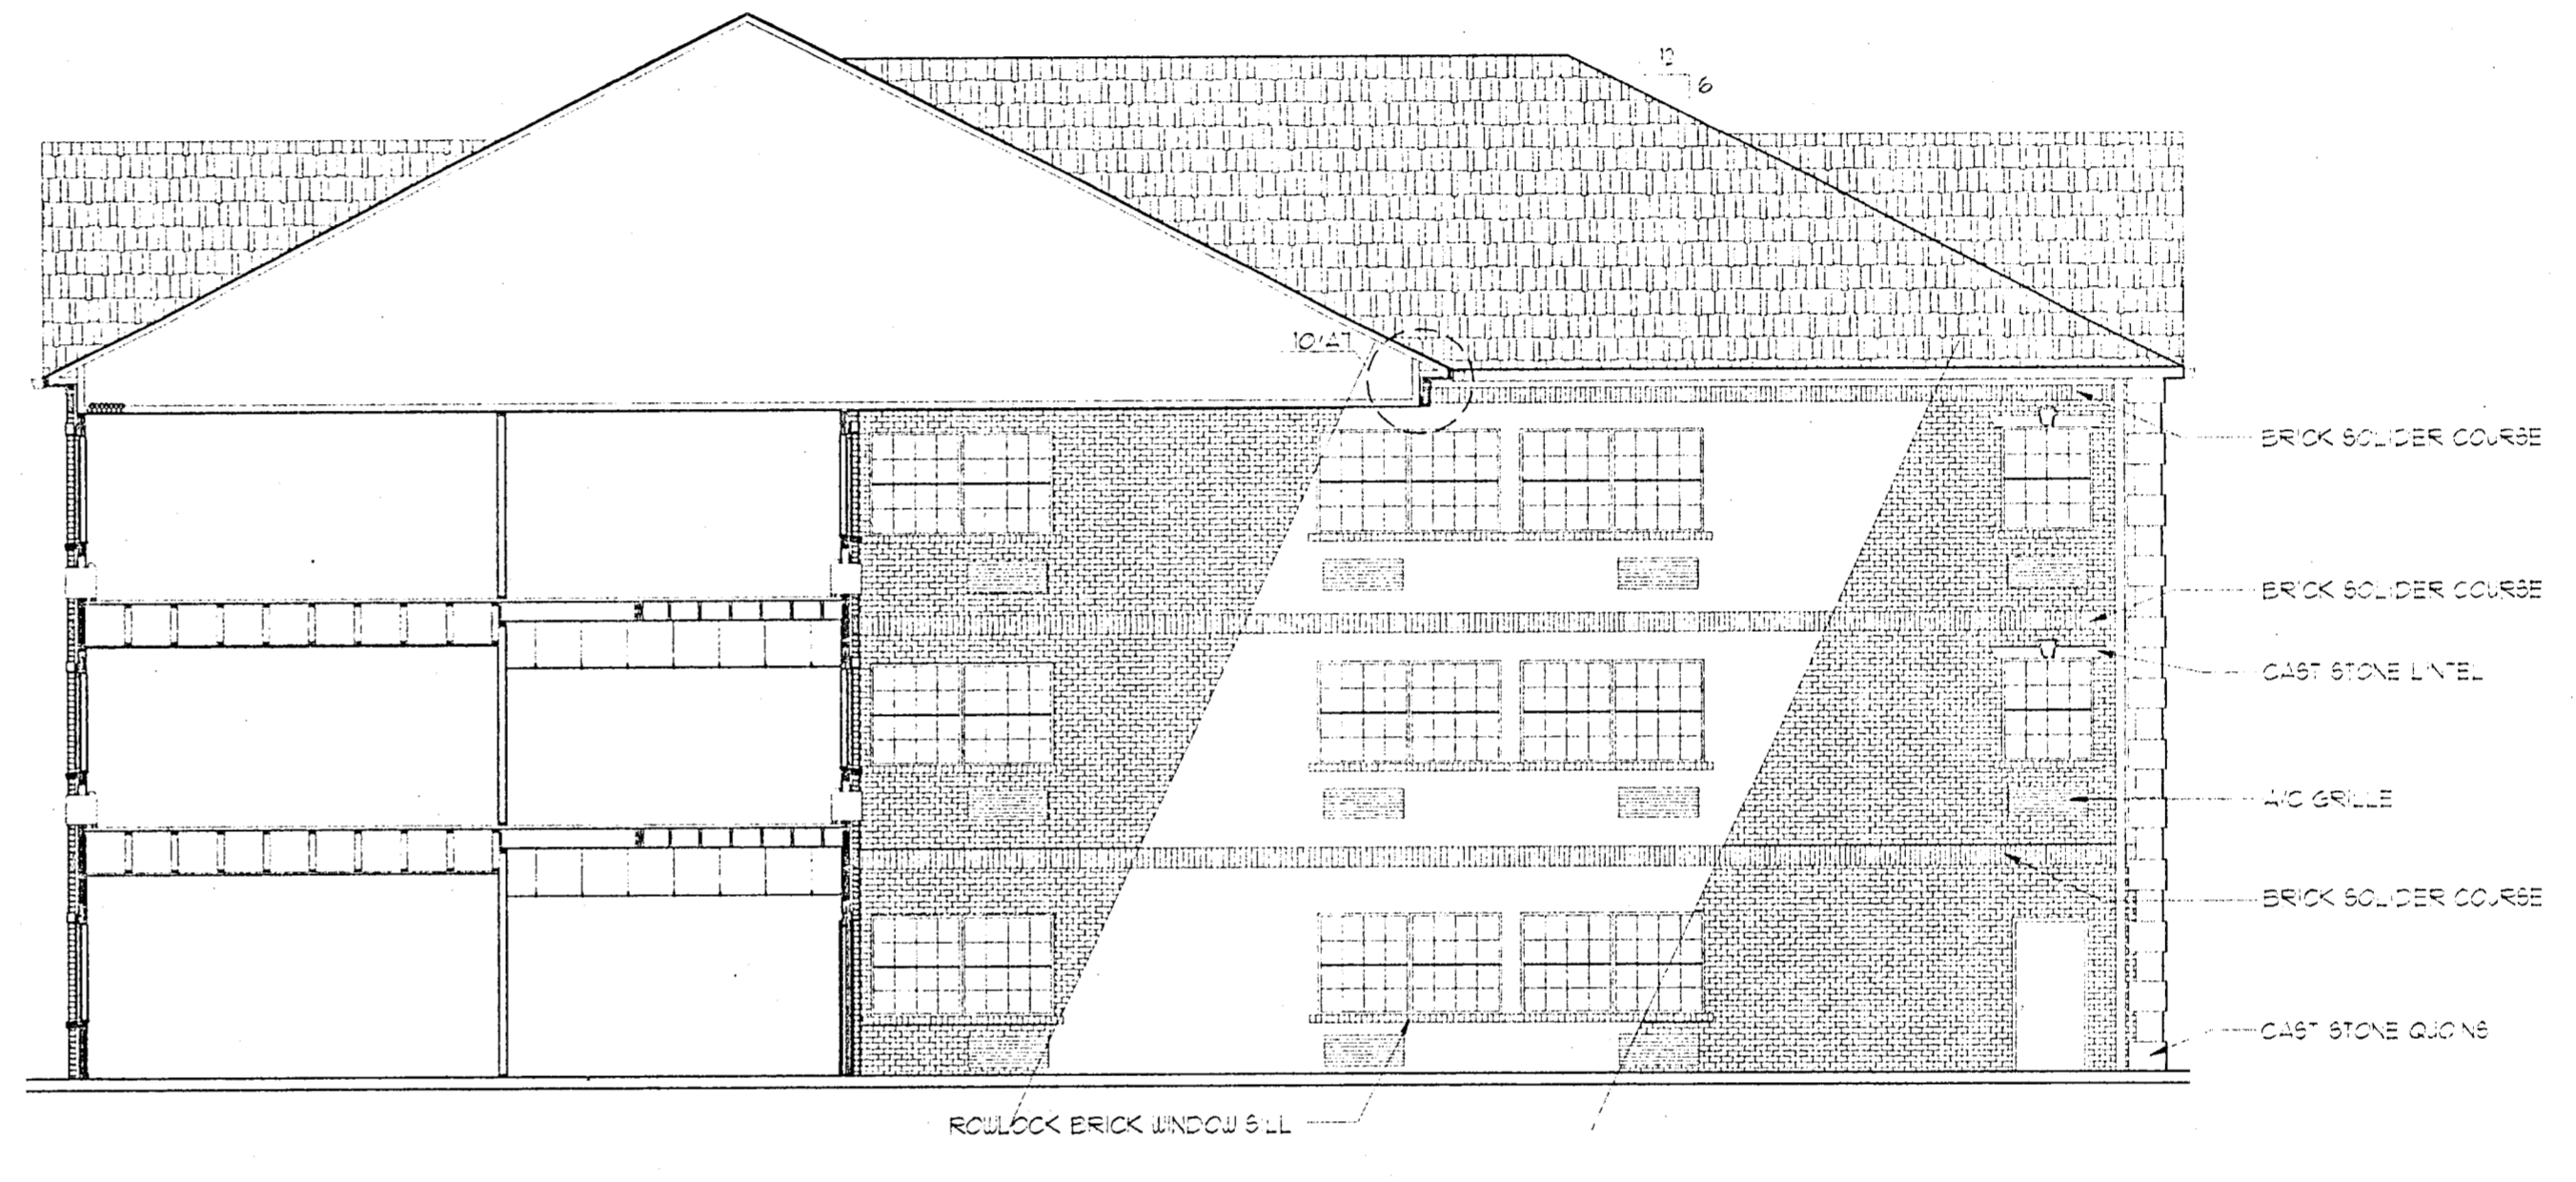

2 ELEVATION
SCALE: 1/8" = 1'-0"
EXT-ELEV.DWG



1 ELEVATION
SCALE: 1/8" = 1'-0"
EXT-ELEV.DWG

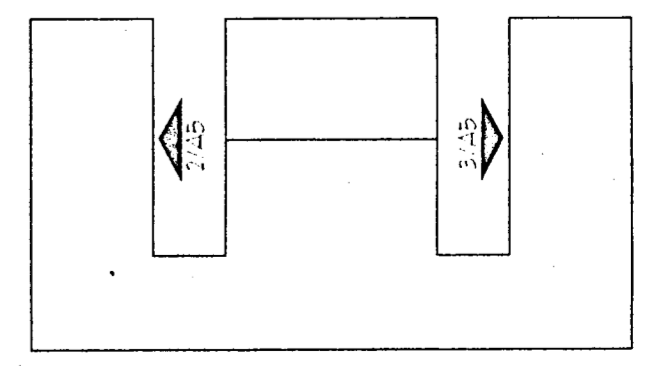

KEY PLAN
NO SCALE

Separate SIGN permit reqd.

3-6 1/2" LOUVER VENTS
W/ INSECT SCREEN (TYPICAL)

3" DIA LOUVER VENT
WITH INSECT SCREEN
(TYPICAL)

4-1/8" X 0.032 PRE-FIN
ALUM GUTTER TO
MATCH FLOOR

2" HIGH BRICK WALL
W/ CAST STONE CAP

1-1/8" X 0.032 PRE-FINISHED
ALUM DOWN SPOUT TO
MATCH BRICK COLOR

BRICK EXTERIOR

CAST STONE QUIONS

4-1/8" ALUM
DOWN SPOUT

A/C GRILLE

CAST STONE QUIONS

BRICK SOLDIER COURSE

BRICK SOLDIER COURSE

BRICK SOLDIER COURSE

CAST STONE LINTEL

ROWLOCK BRICK WINDOW SILL

CAST STONE QUIONS

BRICK SOLDIER COURSE

BRICK SOLDIER COURSE

CAST STONE LINTEL

A/C GRILLE

BRICK SOLDIER COURSE

CAST STONE QUIONS