


AS-BUILT

B. Williams
 2/2/85
 3/6/85

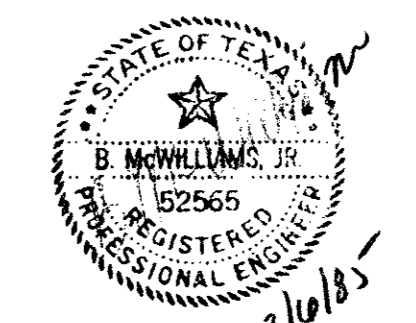

QUORUM CENTER
STORM SEWER & SANI. SEWER PROFILES
TOWN OF ADDISON
 JACK R DAVIS & ASSOCIATES-ENGINEERS
 3535 TRAVIS, SUITE 100, DALLAS, TEXAS