


NOTES:

1. DEMOLITION CONTRACTOR TO BE FAMILIAR WITH ALL PROPOSED CONSTRUCTION PLANS BEFORE ANY SITE DEMOLITION COMMENCES.
2. DEMOLITION CONTRACTOR TO LOCATE ALL UNDERGROUND UTILITIES PRIOR TO ANY DEMOLITION WORK. CONTACT UTILITY COMPANIES AT LEAST 2 WORKING DAYS PRIOR TO ANY DEMOLITION WORK.
3. INSTALL BARRICADES AT LIMITS OF CONSTRUCTION AT THE SOUTH END OF PROJECT AS SHOWN ON PLAN. BARRICADES TO BE MULTI-BARRIER AIRPORT-RUNWAY BARRICADE AR-10x96 HDPE, AS MANUFACTURED BY OFF THE WALL PRODUCTS, DISTRIBUTED BY DALLAS LITE & BARRICADE, INC. (214) 748-5791, PART NO. P6000-101096.

INDICATES EXISTING IMPROVEMENTS TO BE REMOVED

"AS-BUILT"
 THIS AS-BUILT DRAWING IS BASED ON INFORMATION OBTAINED FROM BUILDING CONTRACTORS DURING CONSTRUCTION AS PROVIDED TO JDJR ENGINEERS & CONSULTANTS, INC.
 JDJR ENGINEERS & CONSULTANTS, INC. DOES NOT GUARANTEE THE ACCURACY OR COMPLETENESS OF THESE RECORDS.

REVISIONS:	
1/07/09	PER CITY REVIEW
8/11/09	REV FOR CLIENT
9/11/09	PER CITY REVIEW
9/23/09	PER CITY REVIEW
12/18/09	FENCE REMOVAL
5/18/10	AS BUILT

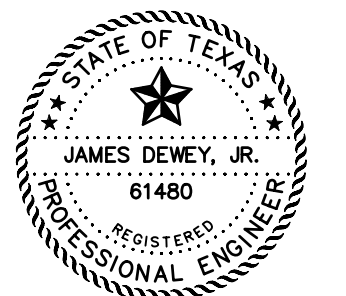

SHEET TITLE:
DEMOLITION PLAN
 PAVING AND DRAINAGE IMPROVEMENTS
 15841 ADDISON ROAD
 AIRPORT
 ADDISON, TEXAS

PREPARED BY:
JDJR ENGINEERS AND CONSULTANTS
 TSBPE REGISTRATION NUMBER F-8527
 ENGINEERS • SURVEYORS • LAND PLANNERS
 2500 Texas Drive Suite 100 Irving, Texas 75062
 Tel 972-252-5357 Fax 972-252-8958

DATE: DEC. 2, 2008 DRAWN BY: SAS SHEET NO.
 SCALE: 1" = 30' CHECKED BY: JDJR **C2** OF **7**