


SHOW TRAFFIC BARRICADES

PVMT. REPAIR AT BORE PIT & TAP

NOTE
ALL CONSTRUCTION SHALL CONFORM TO CITY OF ADDISON STANDARDS & SPECIFICATIONS.

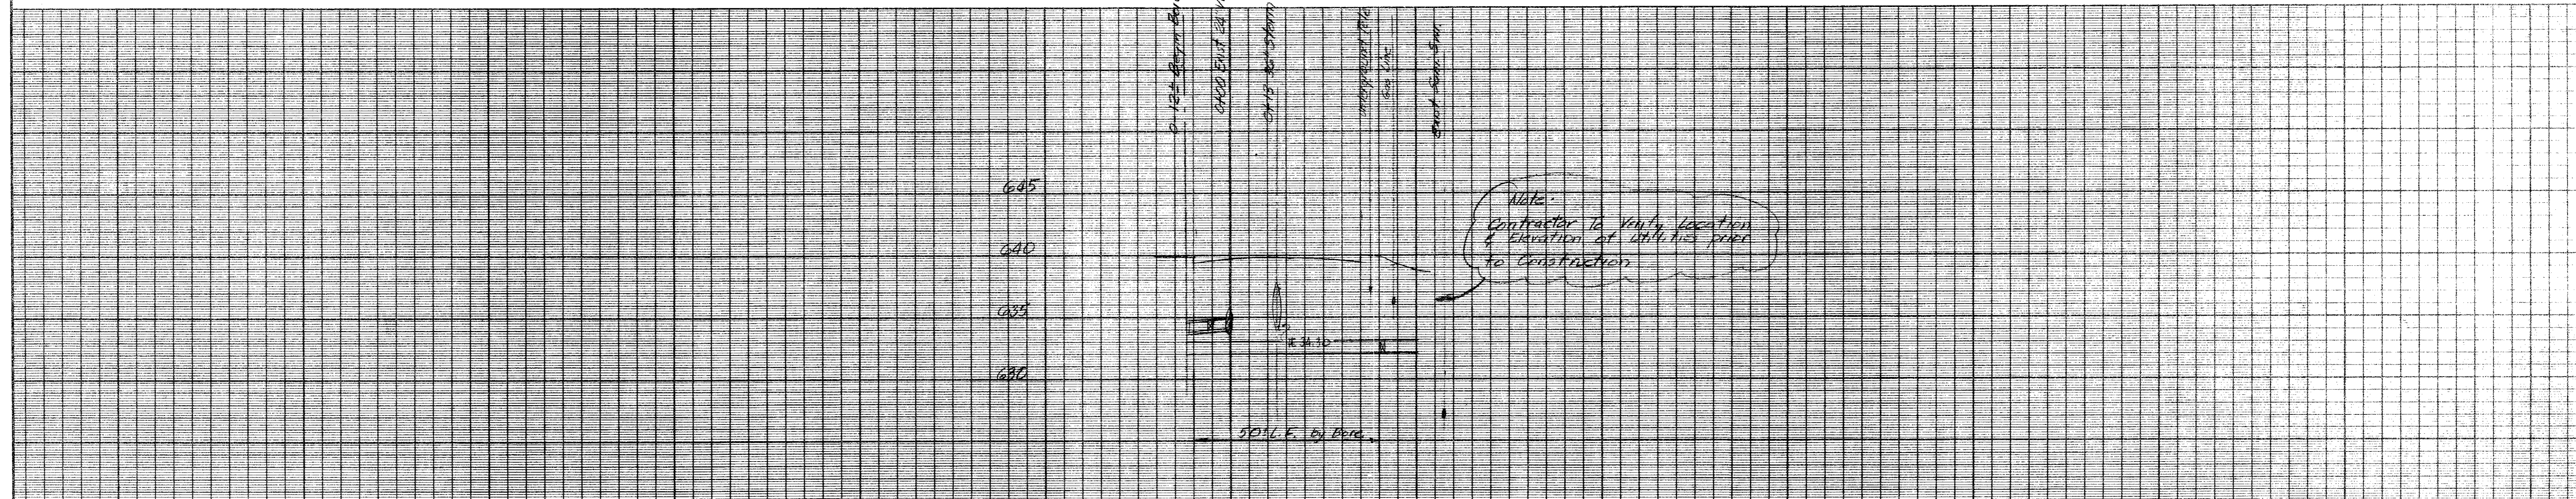

NOTE
Contractor to verify location & elevation of utilities prior to construction.

WATER PLAN & PROFILE						
CONCOURSE PLAZA						
CITY OF ADDISON, TEXAS						
RAYMOND L. GOODSON JR., INC.						
10,200 N. CENTRAL EXP. BLDG. I, SUITE 200						
DALLAS, TX 75231						
DESIGN	DRAWN	DATE	SCALE	NOTES	FILE	NO.
RLG	RLG	4-17-84	1"=20'H 1/8"=6'V			