

16175 Addison Rd.  
STONE  
B14-16

# CONSTRUCTION PLANS FOR T.F. STONE BUILDING ADDISON STORAGE ADDITION LOT 1, BLOCK A

PREPARED FOR

T.F. STONE COMPANIES INC.

16600 NORTH DALLAS PARKWAY, SUITE 400  
DALLAS, TEXAS 75053  
PHONE: 972-931-9911  
FAX: 972-991-5742


### SHEET INDEX

SH #	SHEET DESCRIPTION
1	COVER SHEET
2	DEMOLITION PLAN
3	PAVING AND DIMENSIONAL CONTROL PLAN
4	GRADING PLAN
5	ON-SITE DRAINAGE AREA MAP
6	WATER AND WASTE WATER PLAN
7	CONSTRUCTION DETAILS
8	GENERAL NOTES
9	INITIAL EROSION CONTROL PLAN

LANDSCAPE PLAN (BY OTHERS)  
IRRIGATION PLAN (BY OTHERS)

*Reviews  
SZ & P.L.  
1/20/03*

*PLEASE RETURN THESE  
CHECK REIMS w/ NEXT  
SUBMITTAL!*

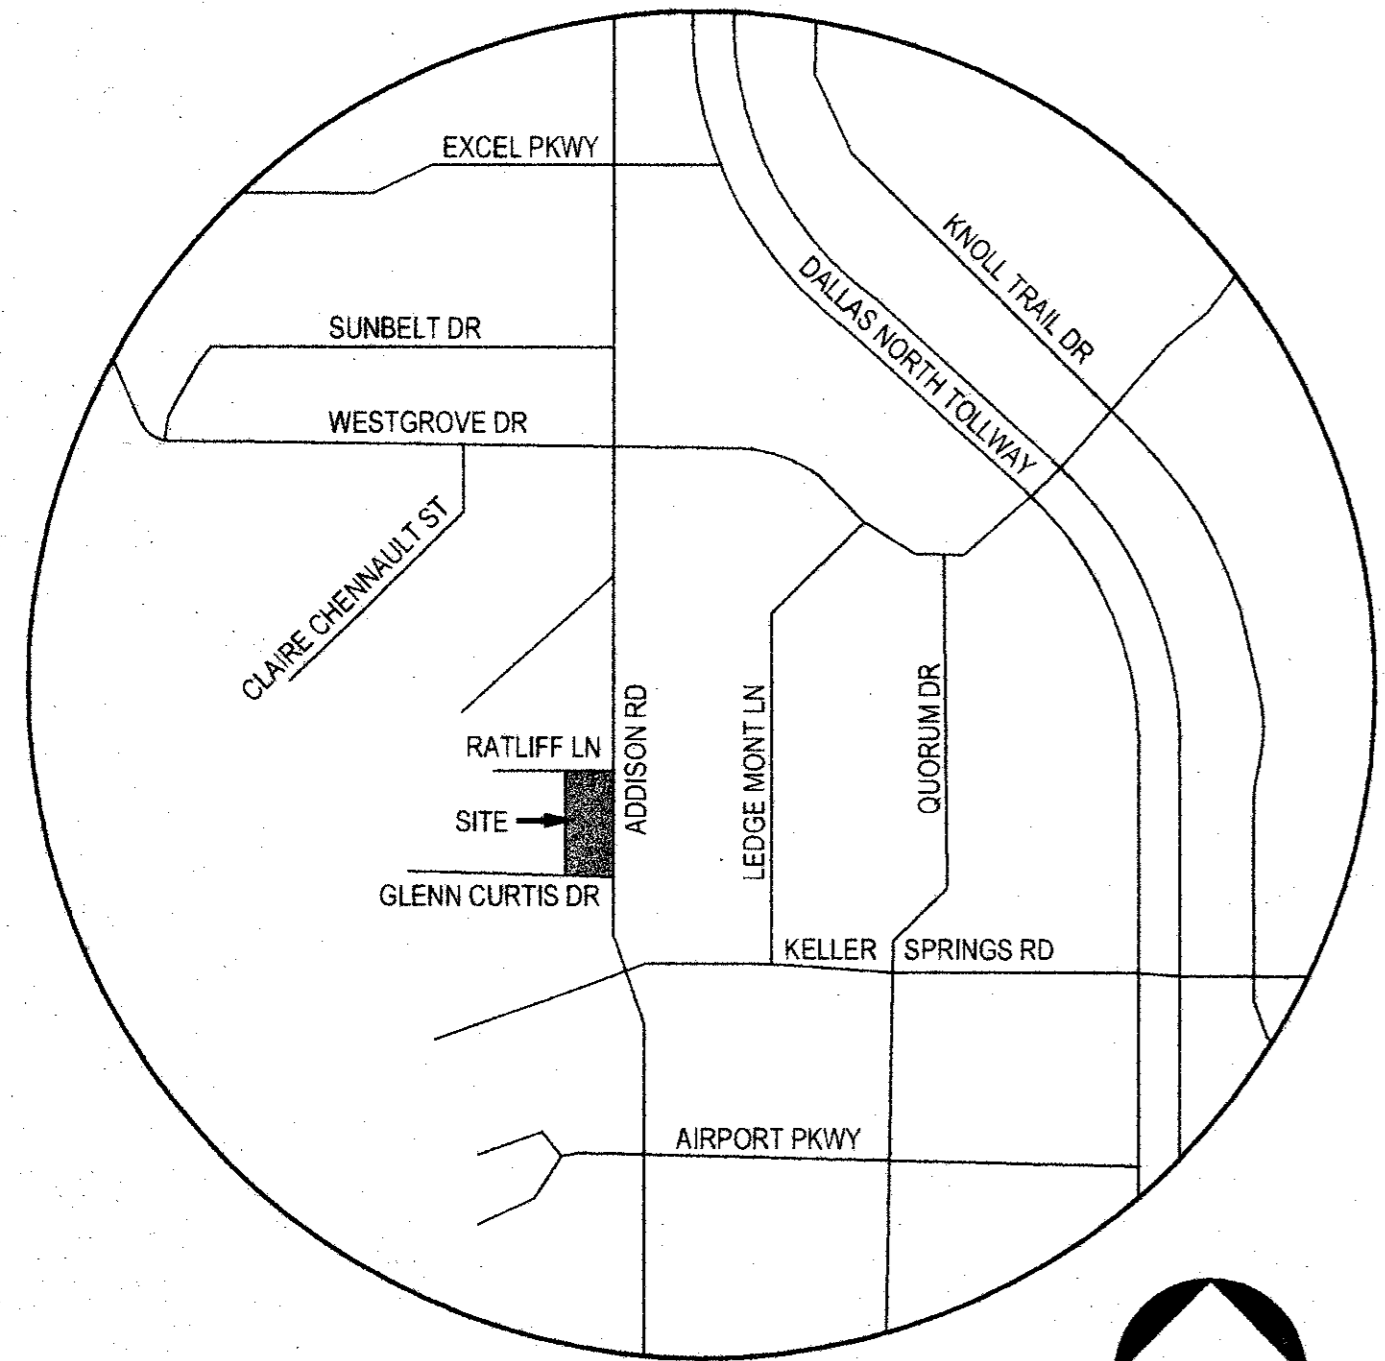

VICINITY MAP  
NO SCALE



JANUARY 14, 2003

**O'Brien Engineering, Inc.**

4011 W. Plano Pkwy, Ste 108  
Plano, TX 75093

Phone: 972 312-8850  
Fax: 972 312-0675

OEI Job No: 138-02

16175 Addison Rd.  
B14-16